


MALHEUR CO.

**R37E
R38E**

Application No. 8-1605
Permit No.

70515

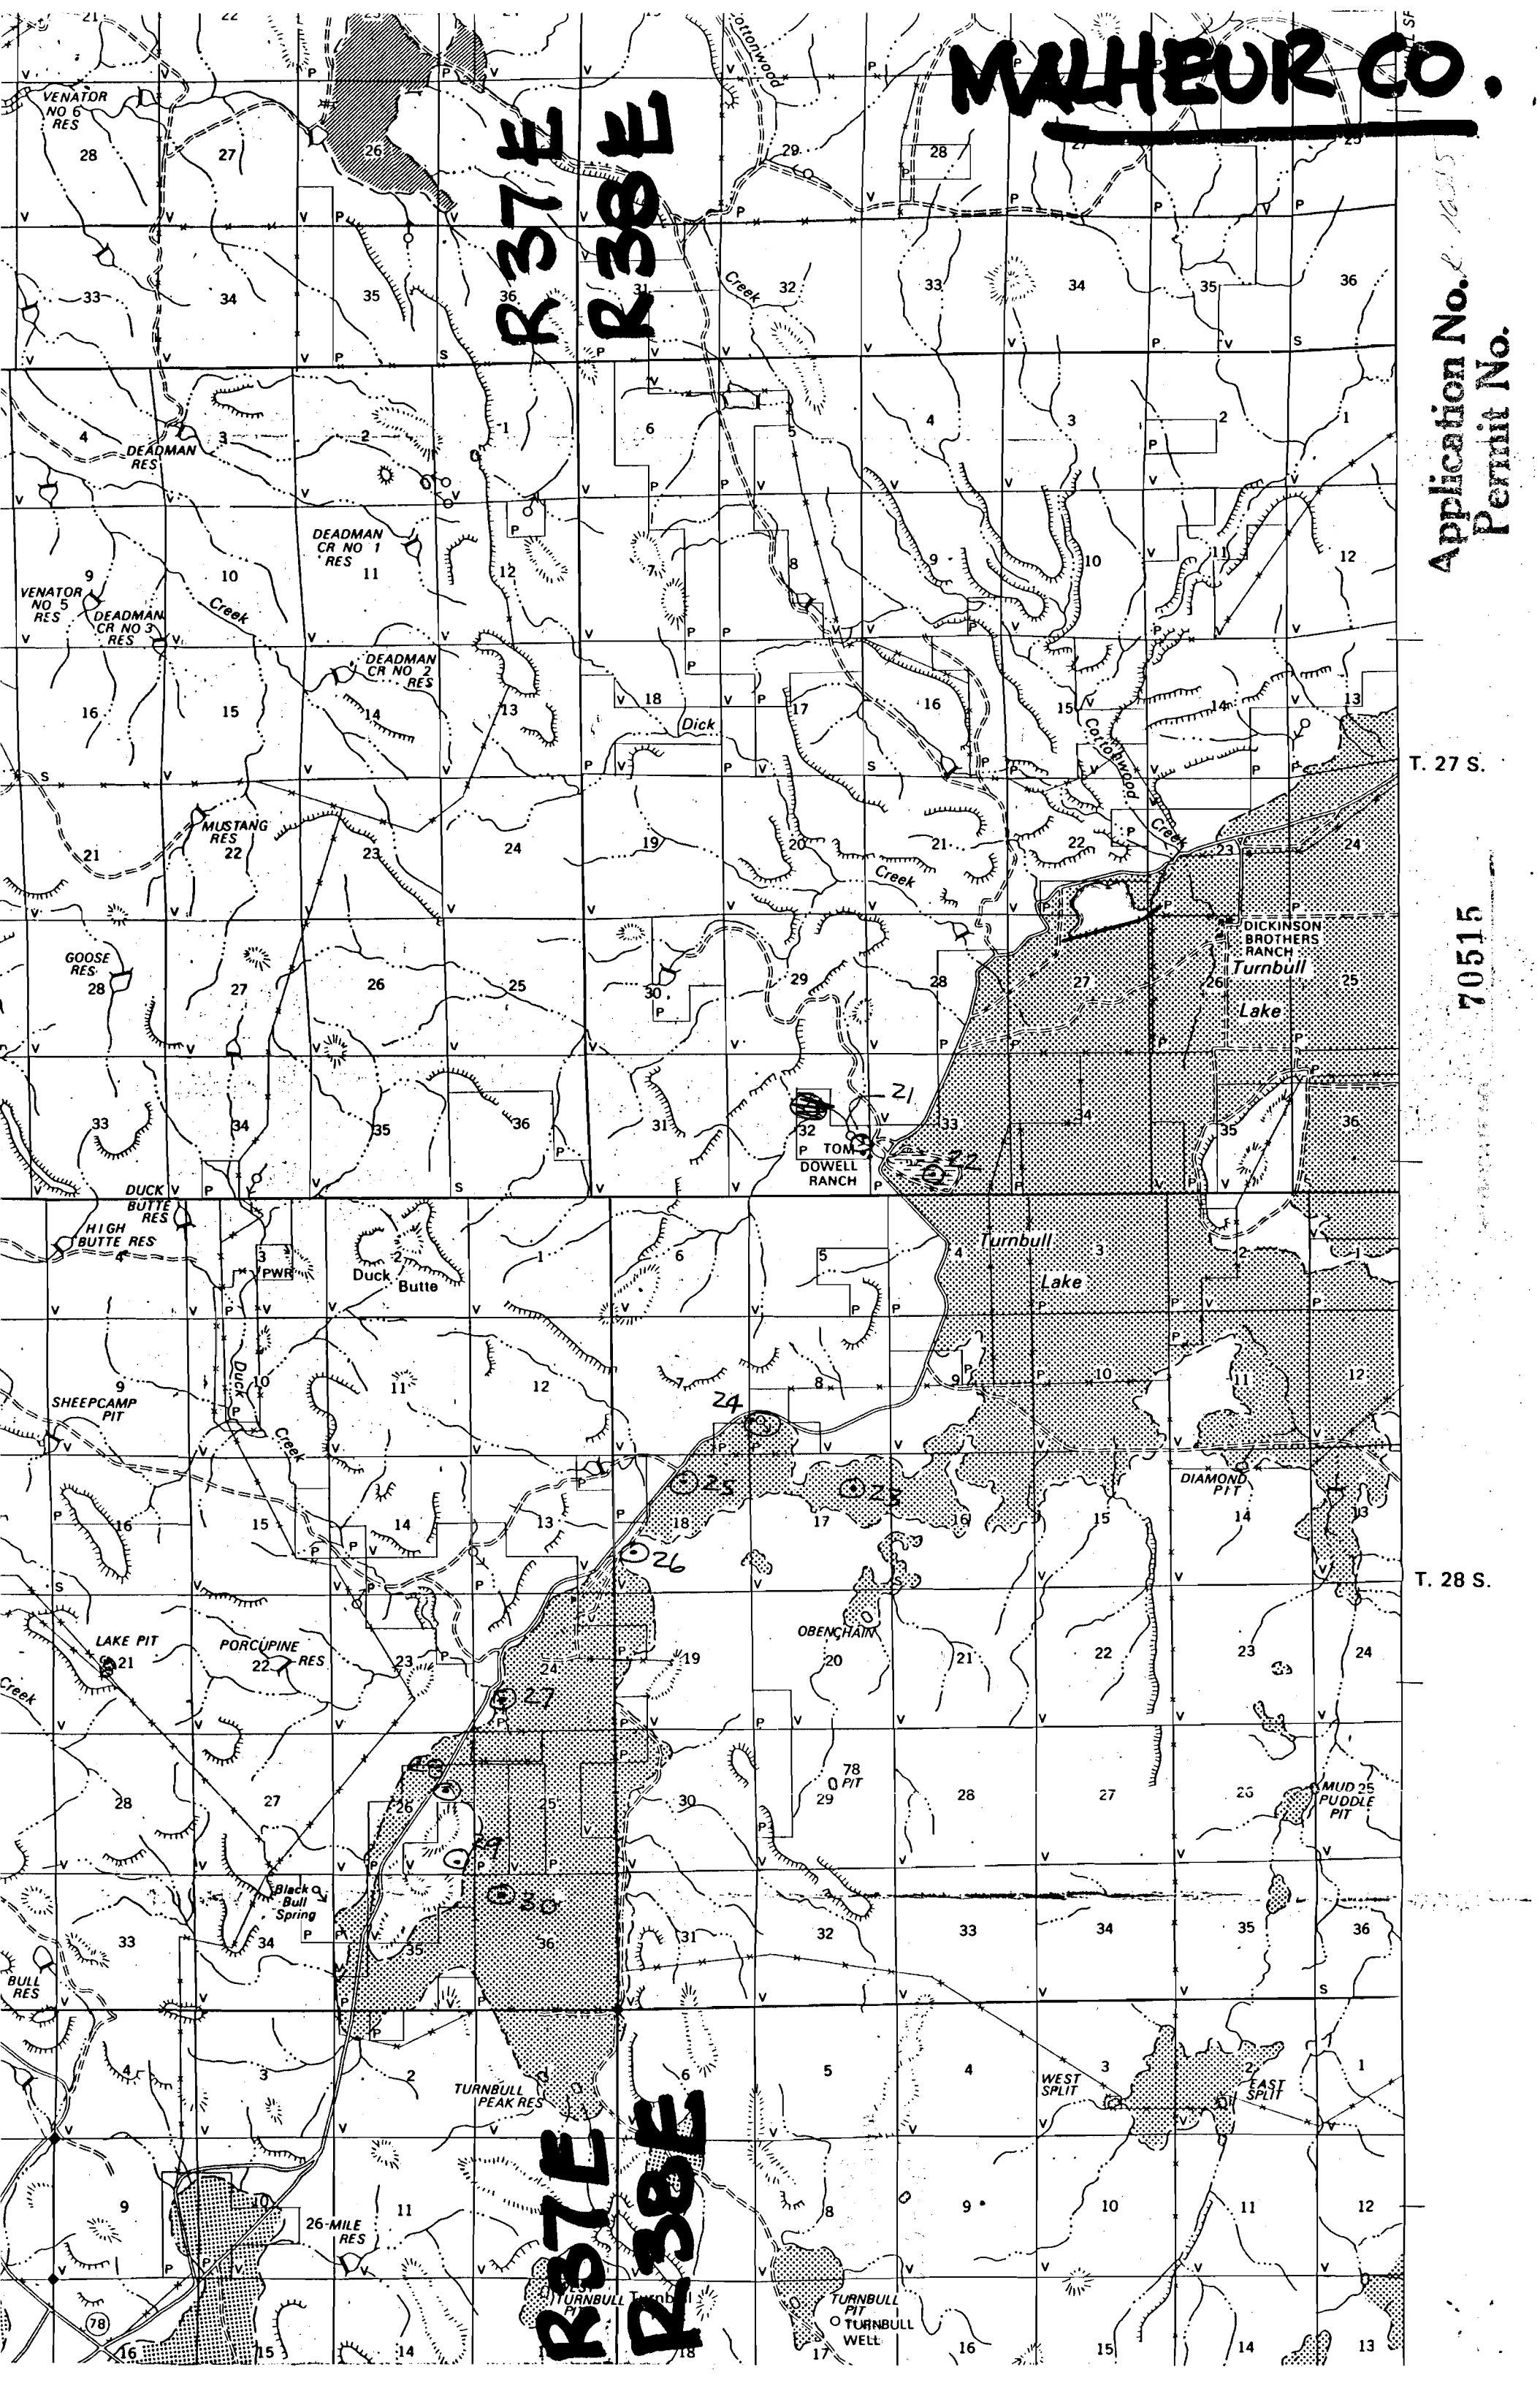

T. 27 S.

T. 28 S.

**R37E
R38E**

No Final Proof Map available

No Permit Map available