

MALHEUR CO.

**R 37 E
R 38 E**


Application No. _____
Permit No. _____

T. 27 S.

70516

T. 28 S.

**R 37 E
R 38 E**

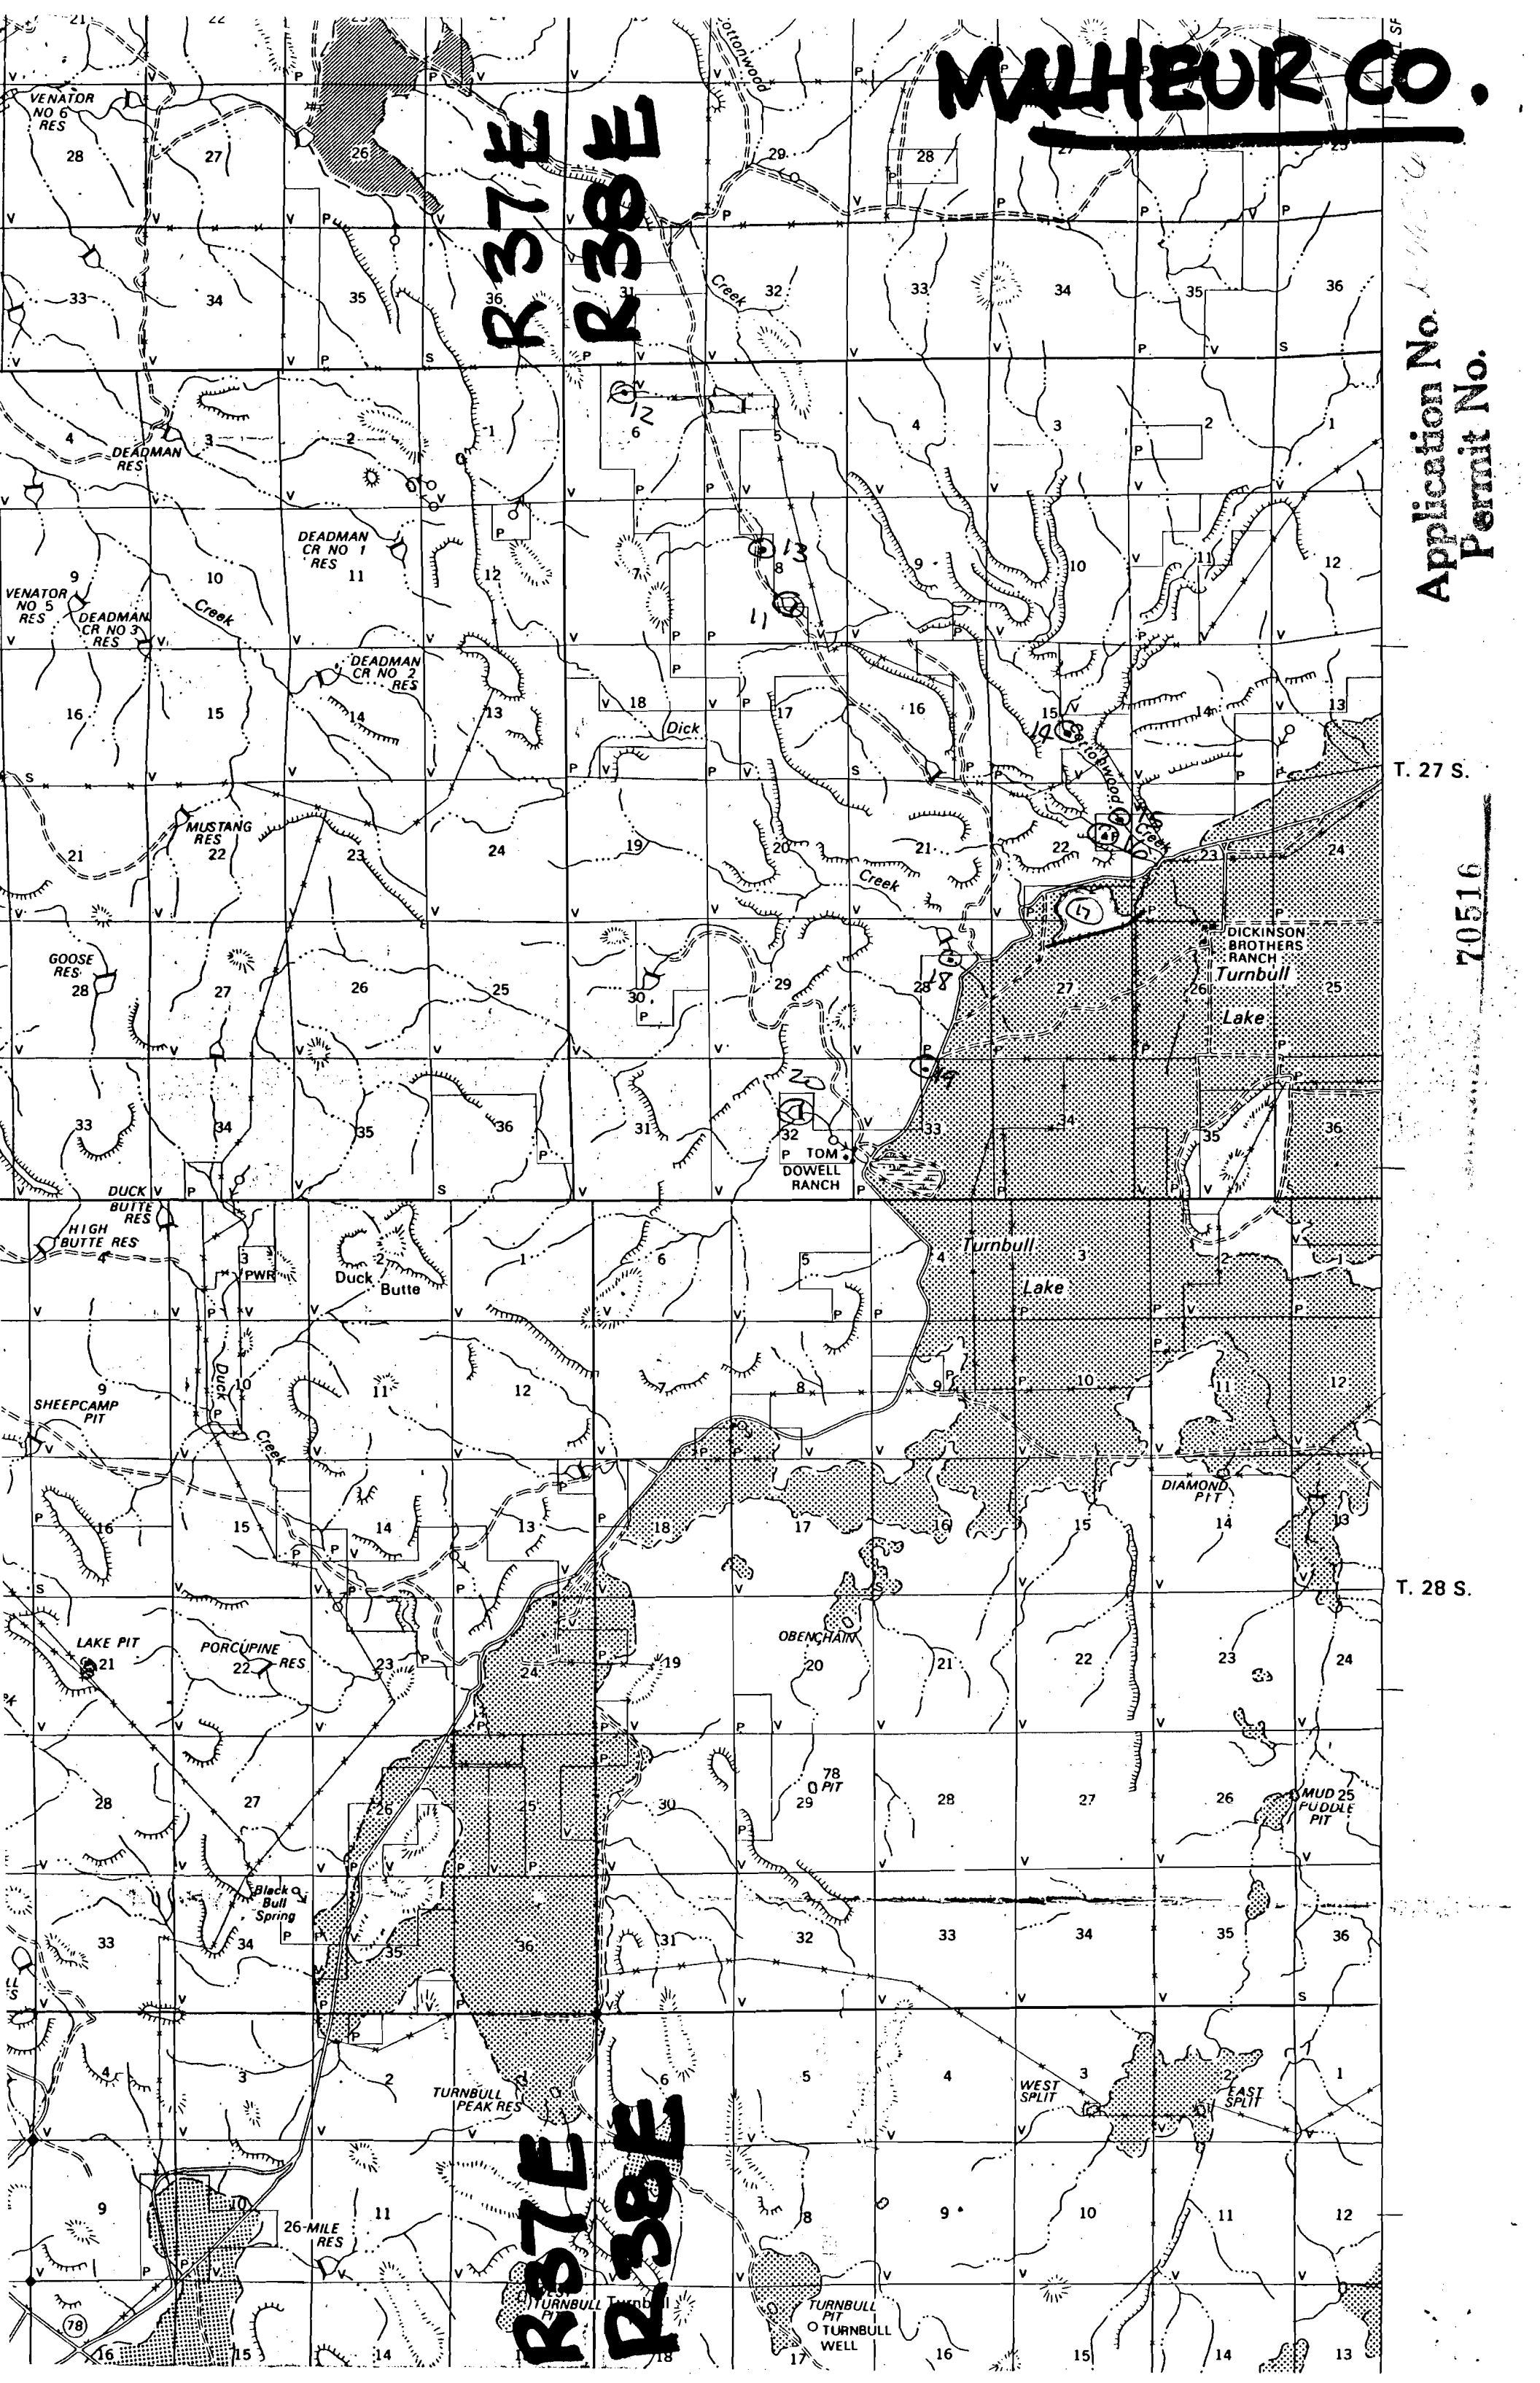

No Final Proof Map available

No Permit Map available