

MALHEUR CO.

**R37E
R38E**

Application No.
Permit No.


T. 27 S.

70517

70517

T. 28 S.

**R37E
R38E**

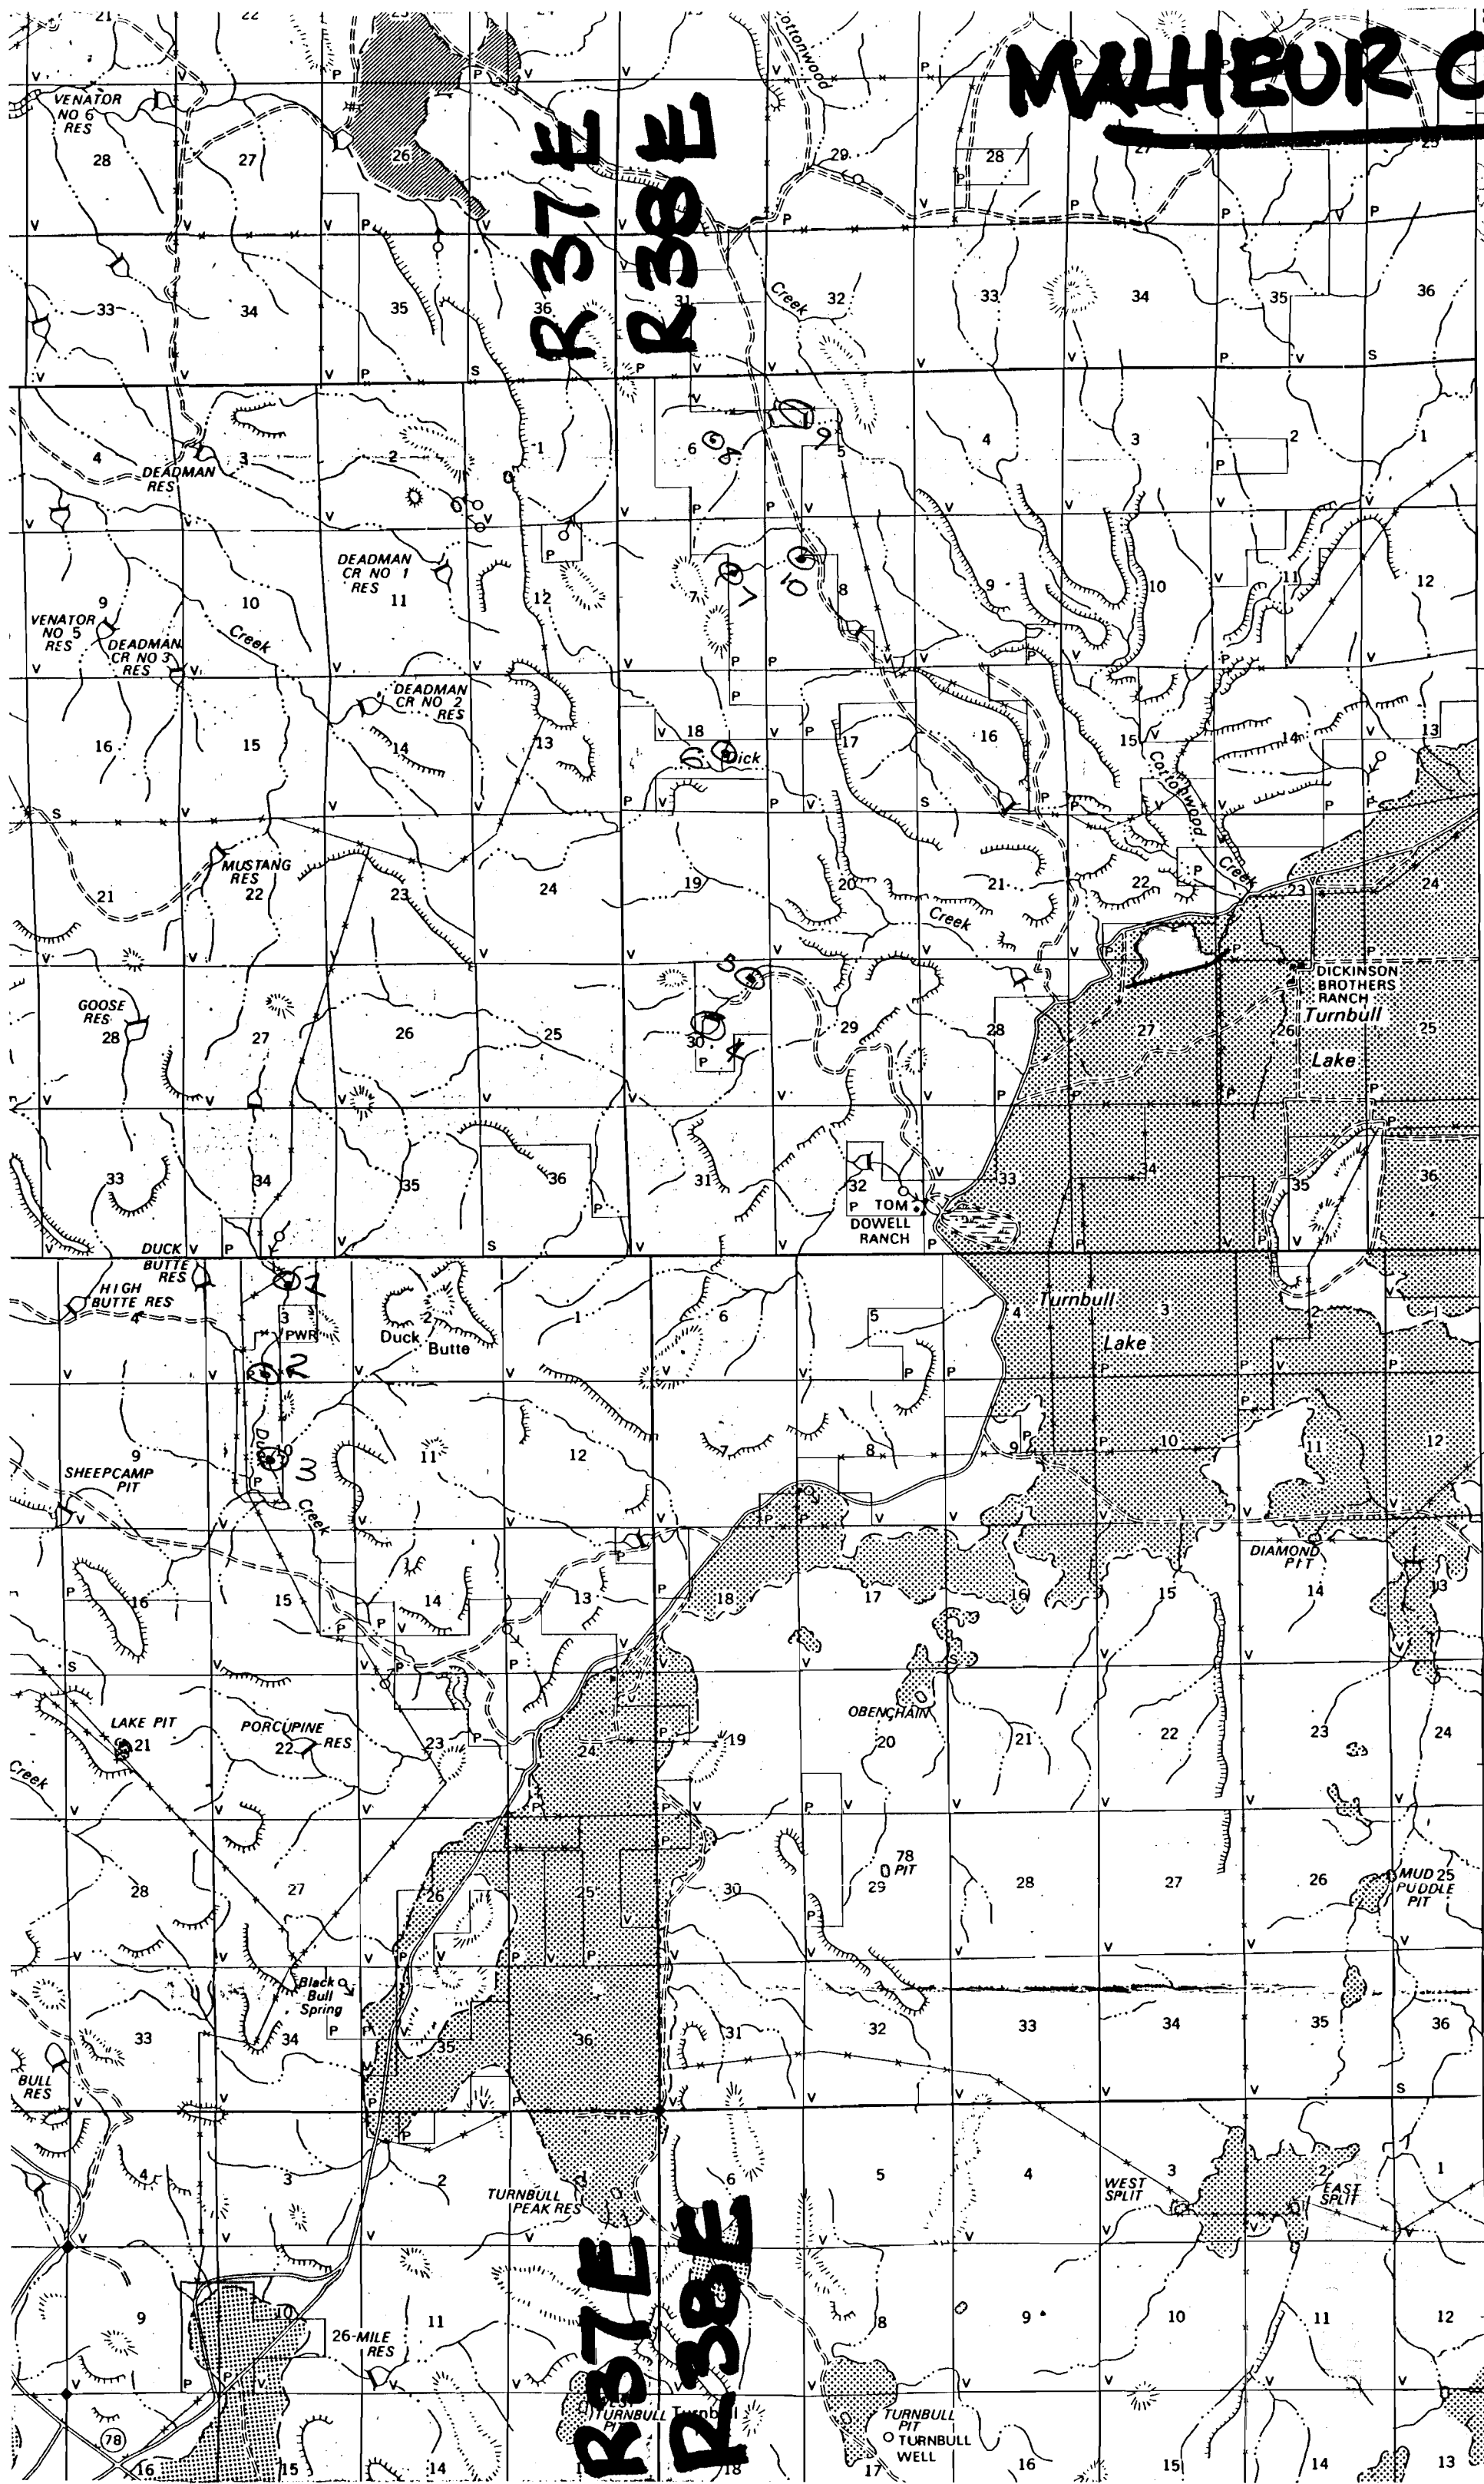

No Final Proof Map available

No Permit Map available