


**R36E
R37E**

T26S

**T26S
T27S**

T27S

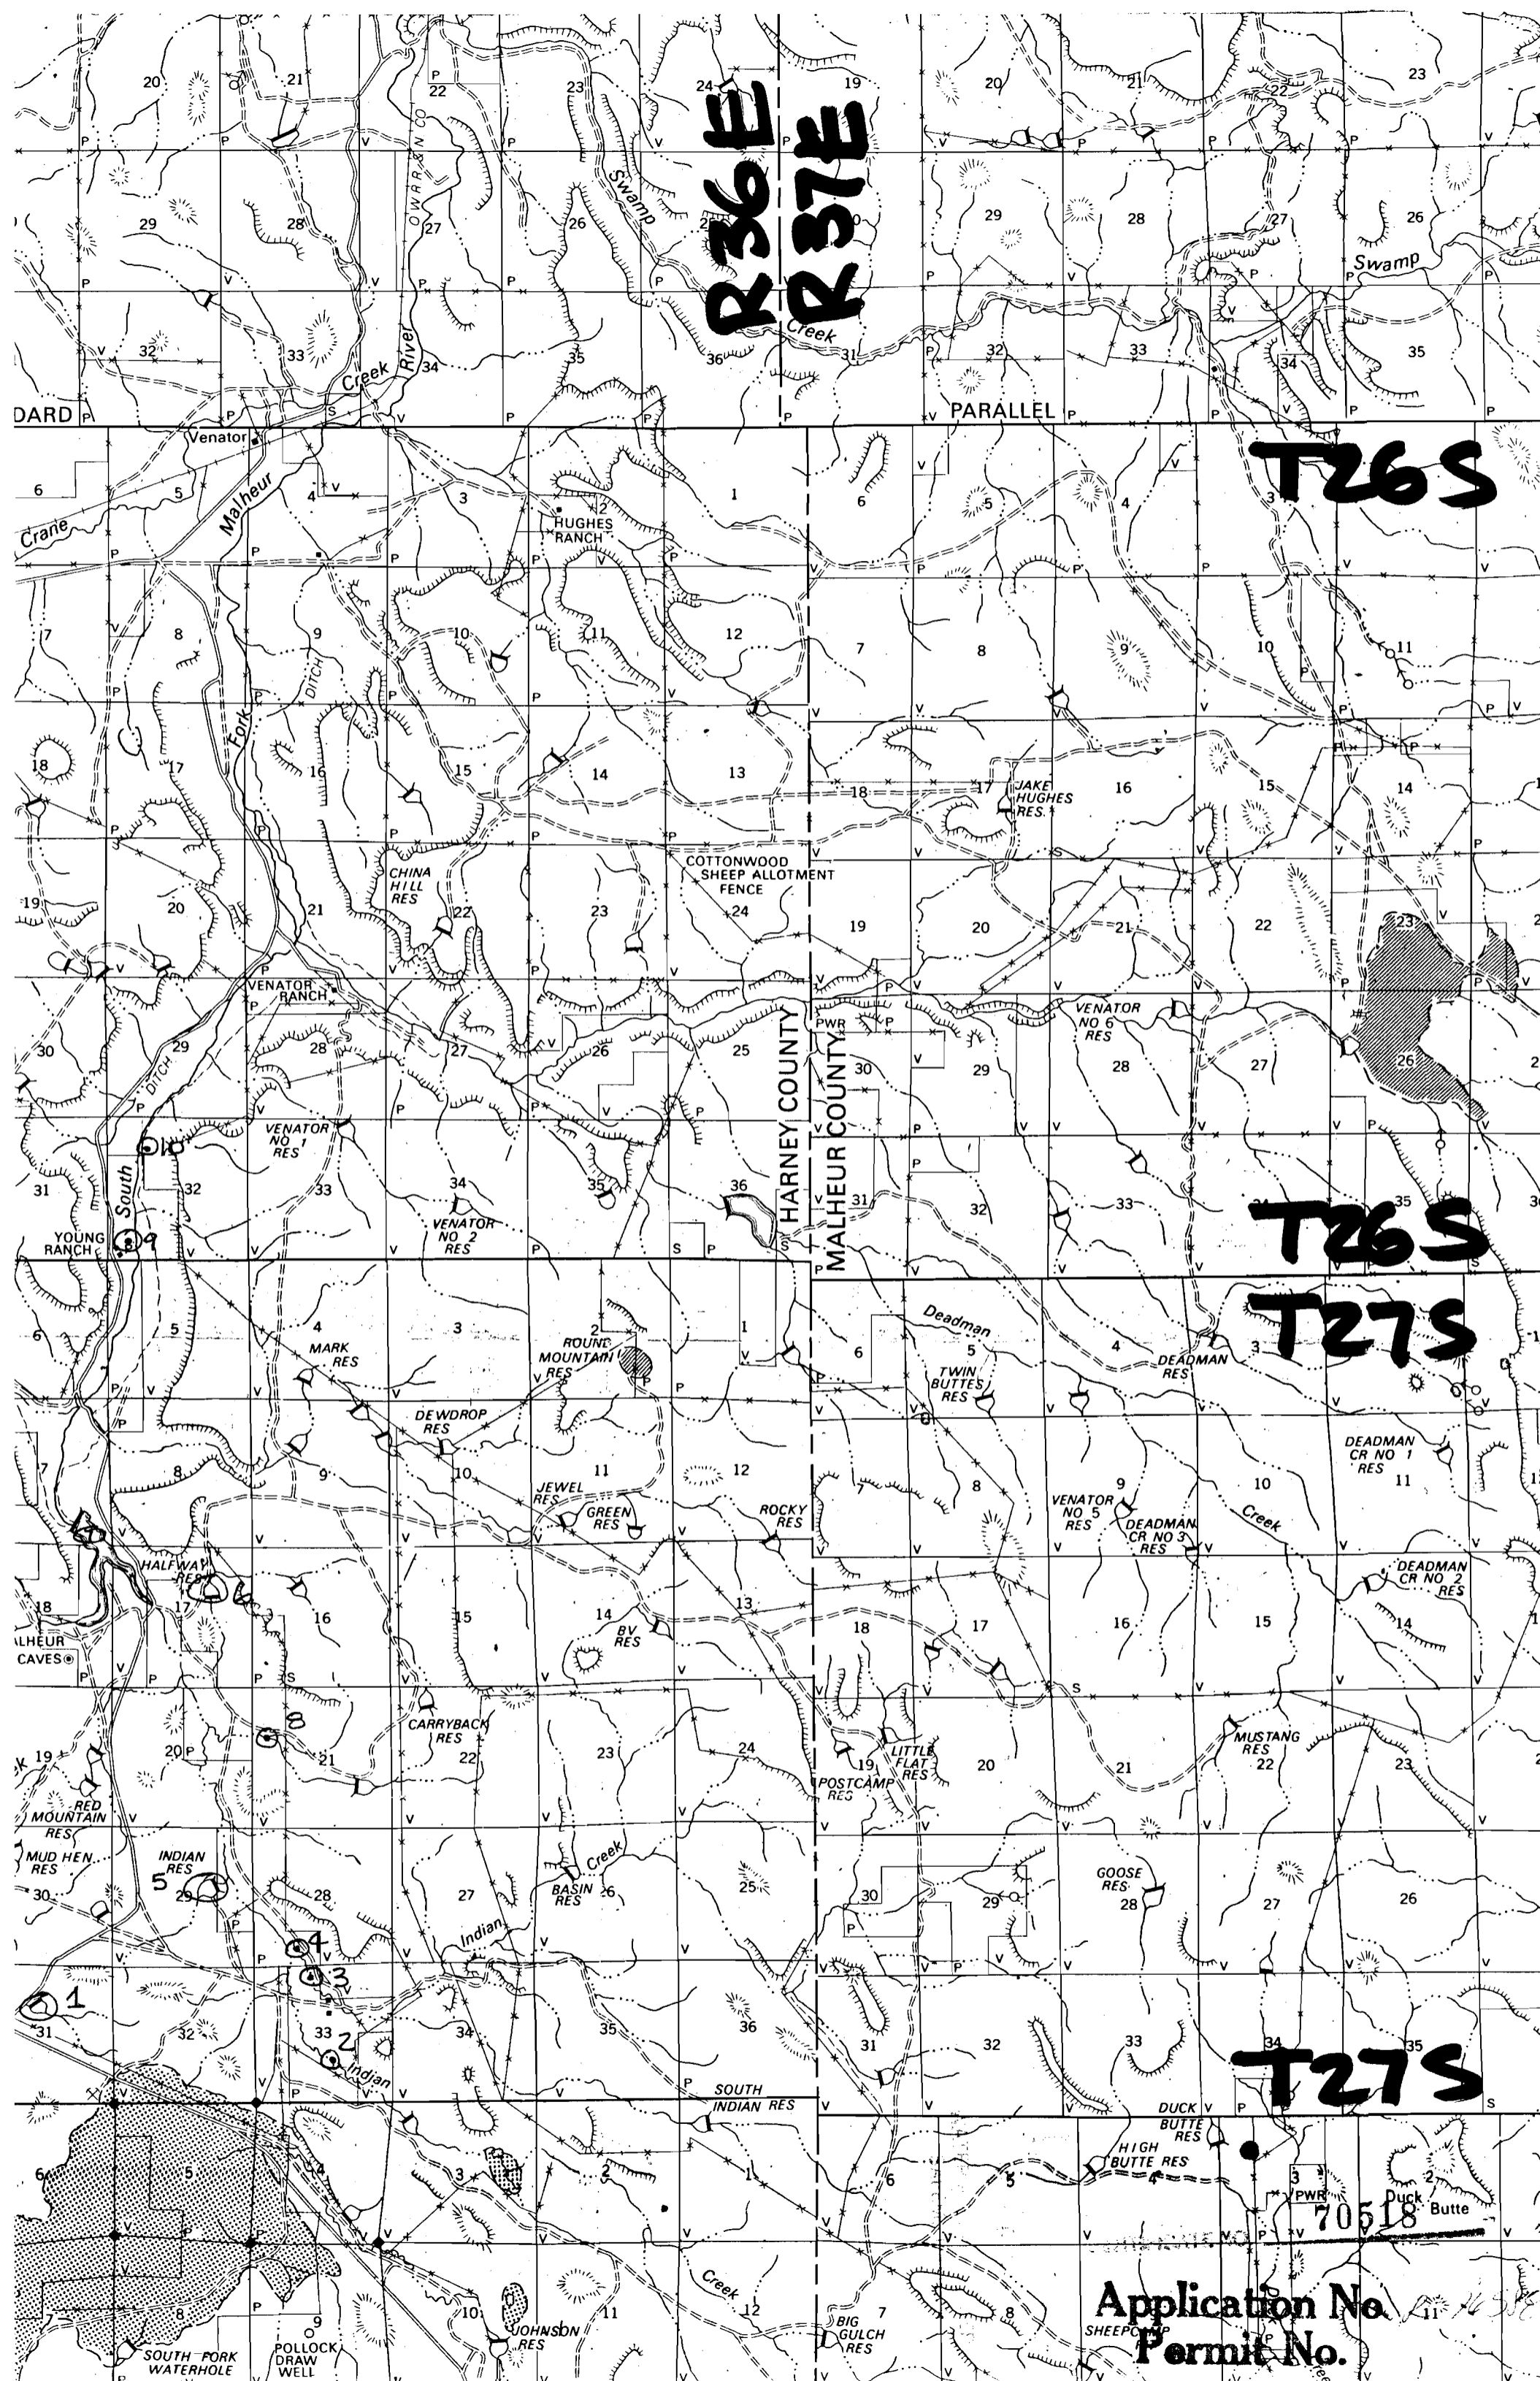

Application No. _____
Permit No. _____

70518

No Final Proof Map available

No Permit Map available