


MAP OF
POINTS OF DIVERSION FOR
APPROPRIATION OF PUBLIC WATER
IN SECTION 34 T1N R4W, W.M.

BY M. V. WALKER ET AL.
SCALE: 1 IN = 200 FT.

SURVEYOR'S CERTIFICATE
A. Robert Sorbel, Registered
Surveyor of Forest Grove, Ore.,
reby certify that this map was
from notes taken during an actual
made by me on 14 August, 1957,
that the monuments at the points
version and their locations are as
ted on the annexed map.

A. Robert Sorbel

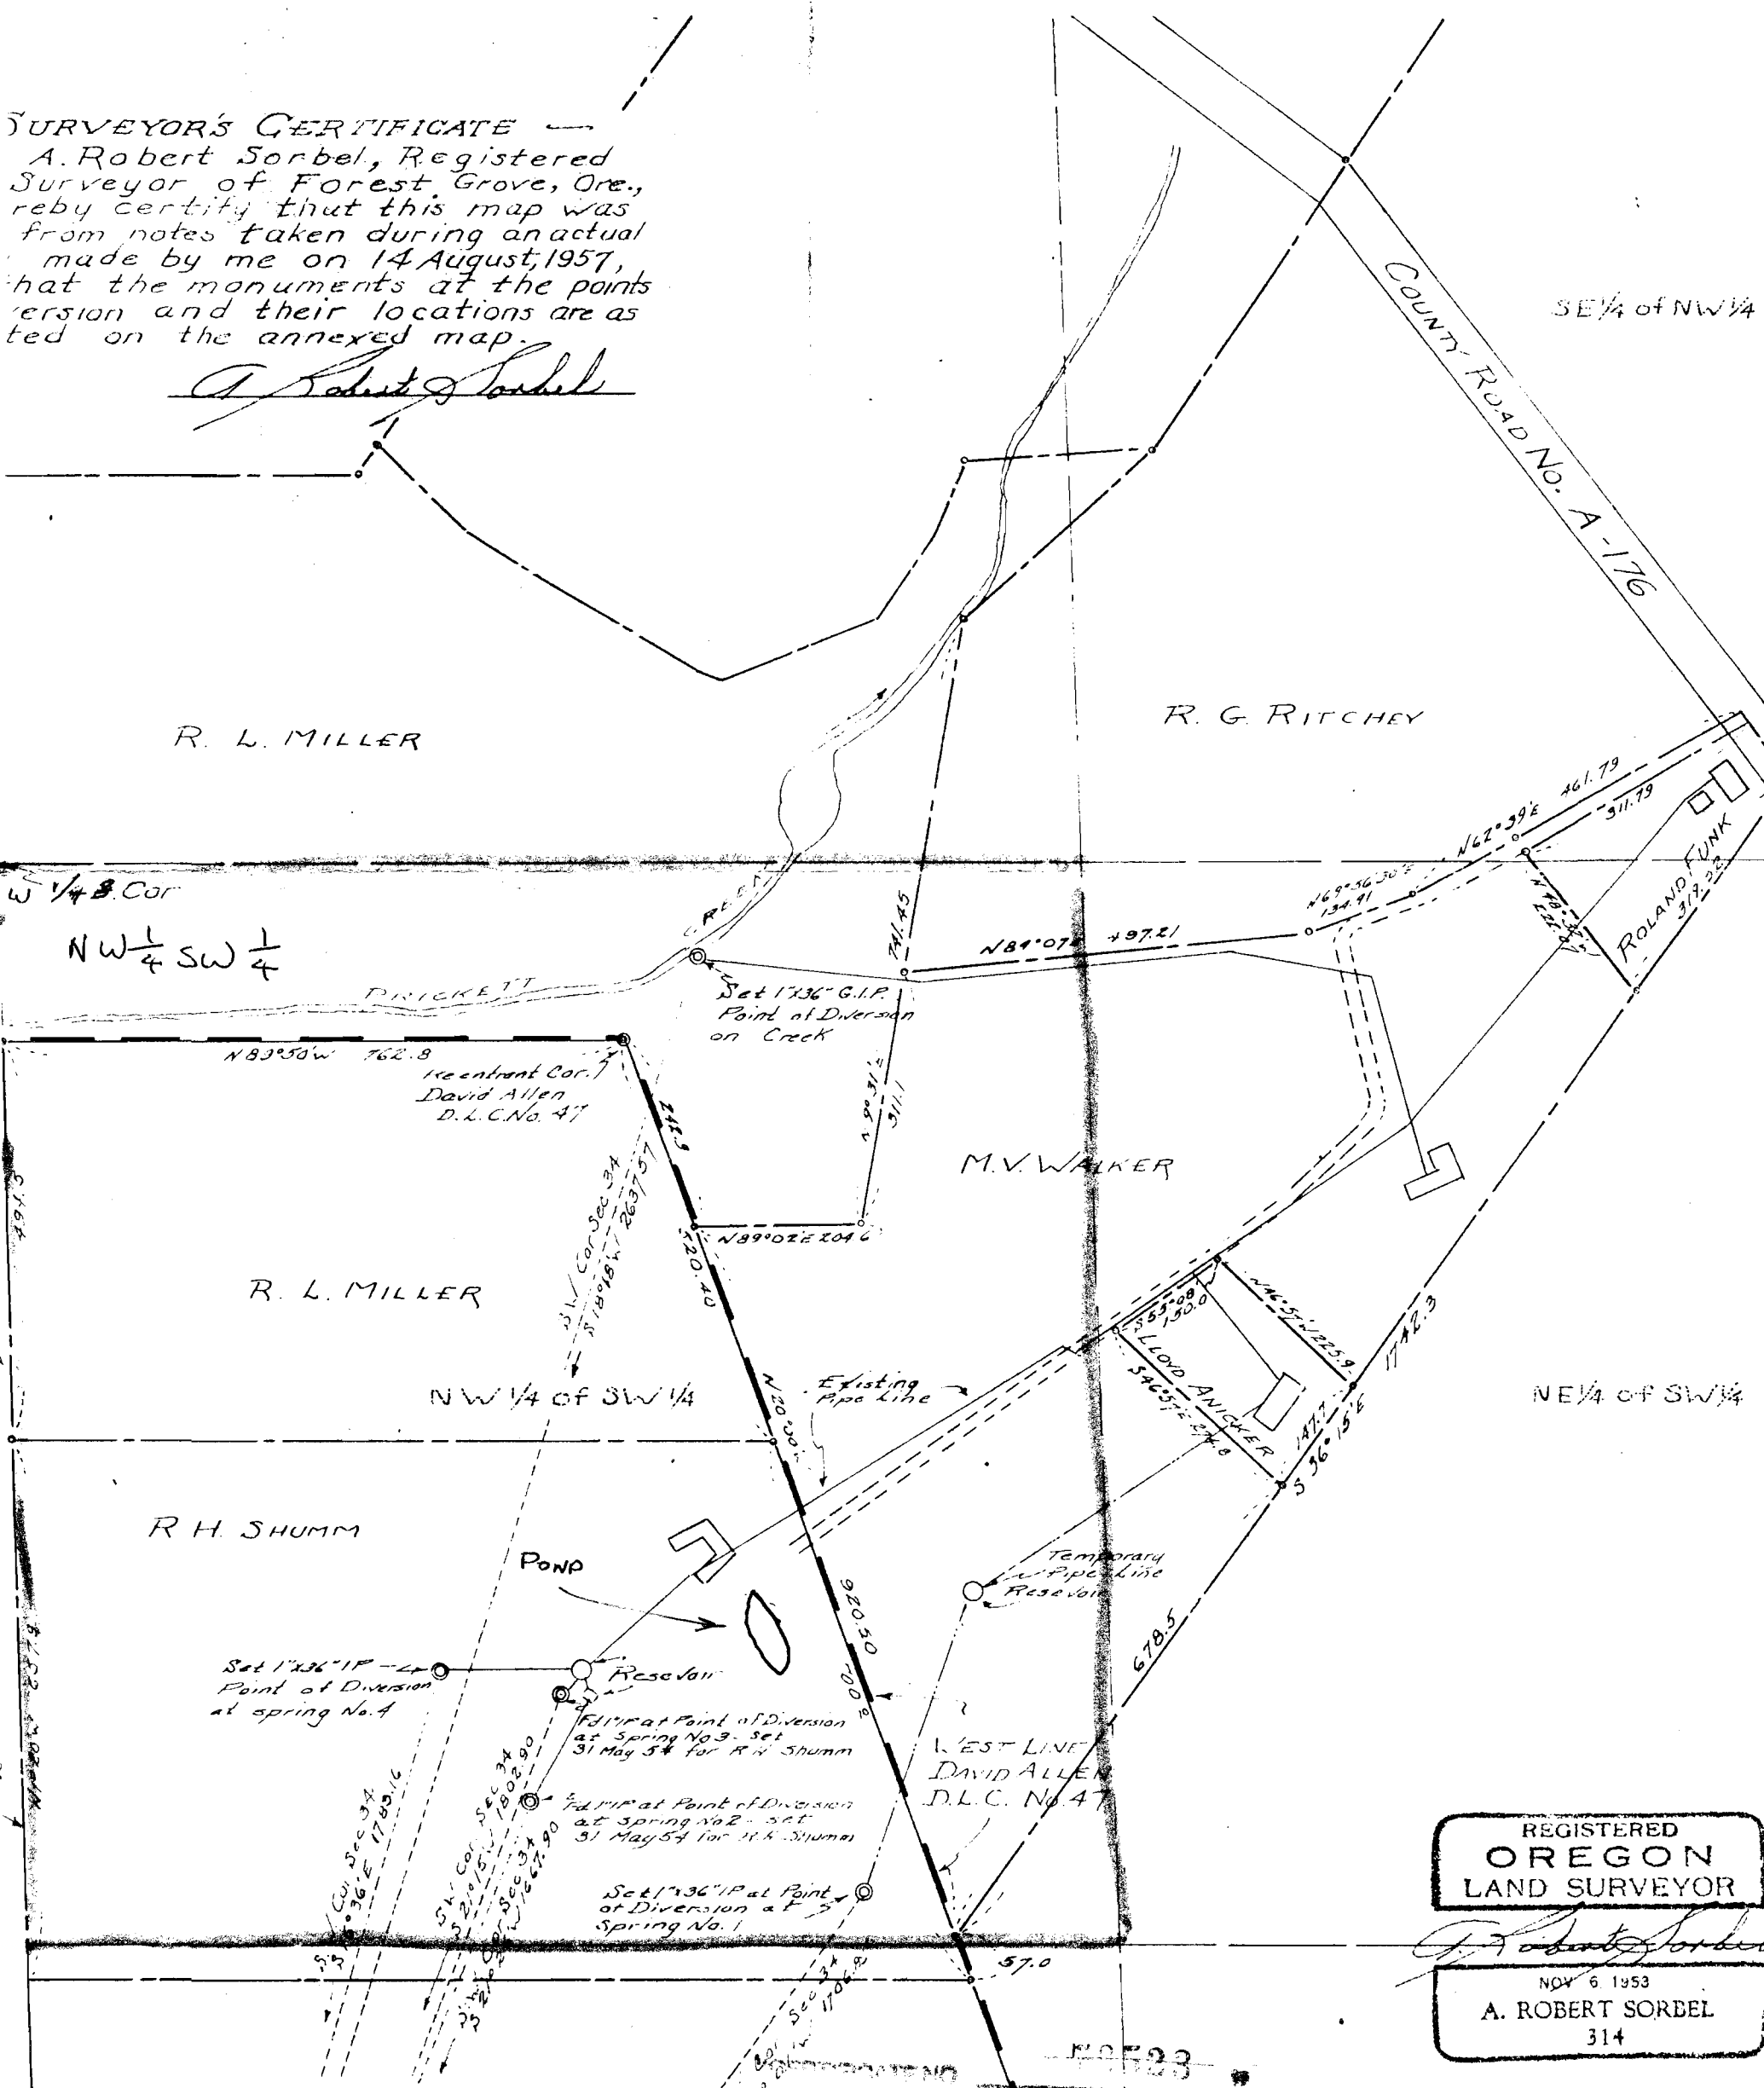

REGISTERED
OREGON
LAND SURVEYOR

A. Robert Sorbel
NOV 6 1953
A. ROBERT SOBREL
314

Application No.
Permit No.

A. R. SOBREL, Surveyor
1911 Pacific Ave.
Forest Grove, Ore.

No Final Proof Map available

No Permit Map available