


SEE MAP 8 4 23

1/4 COR

Work Copy

General Location of Pond

SCALE 1:4000

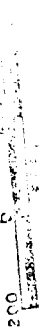

5-10


5-10

Best location from maps

SEE MAP 8 4 27

SEE MAP 8 4 26

8N 4W
Sec 26
SW NW

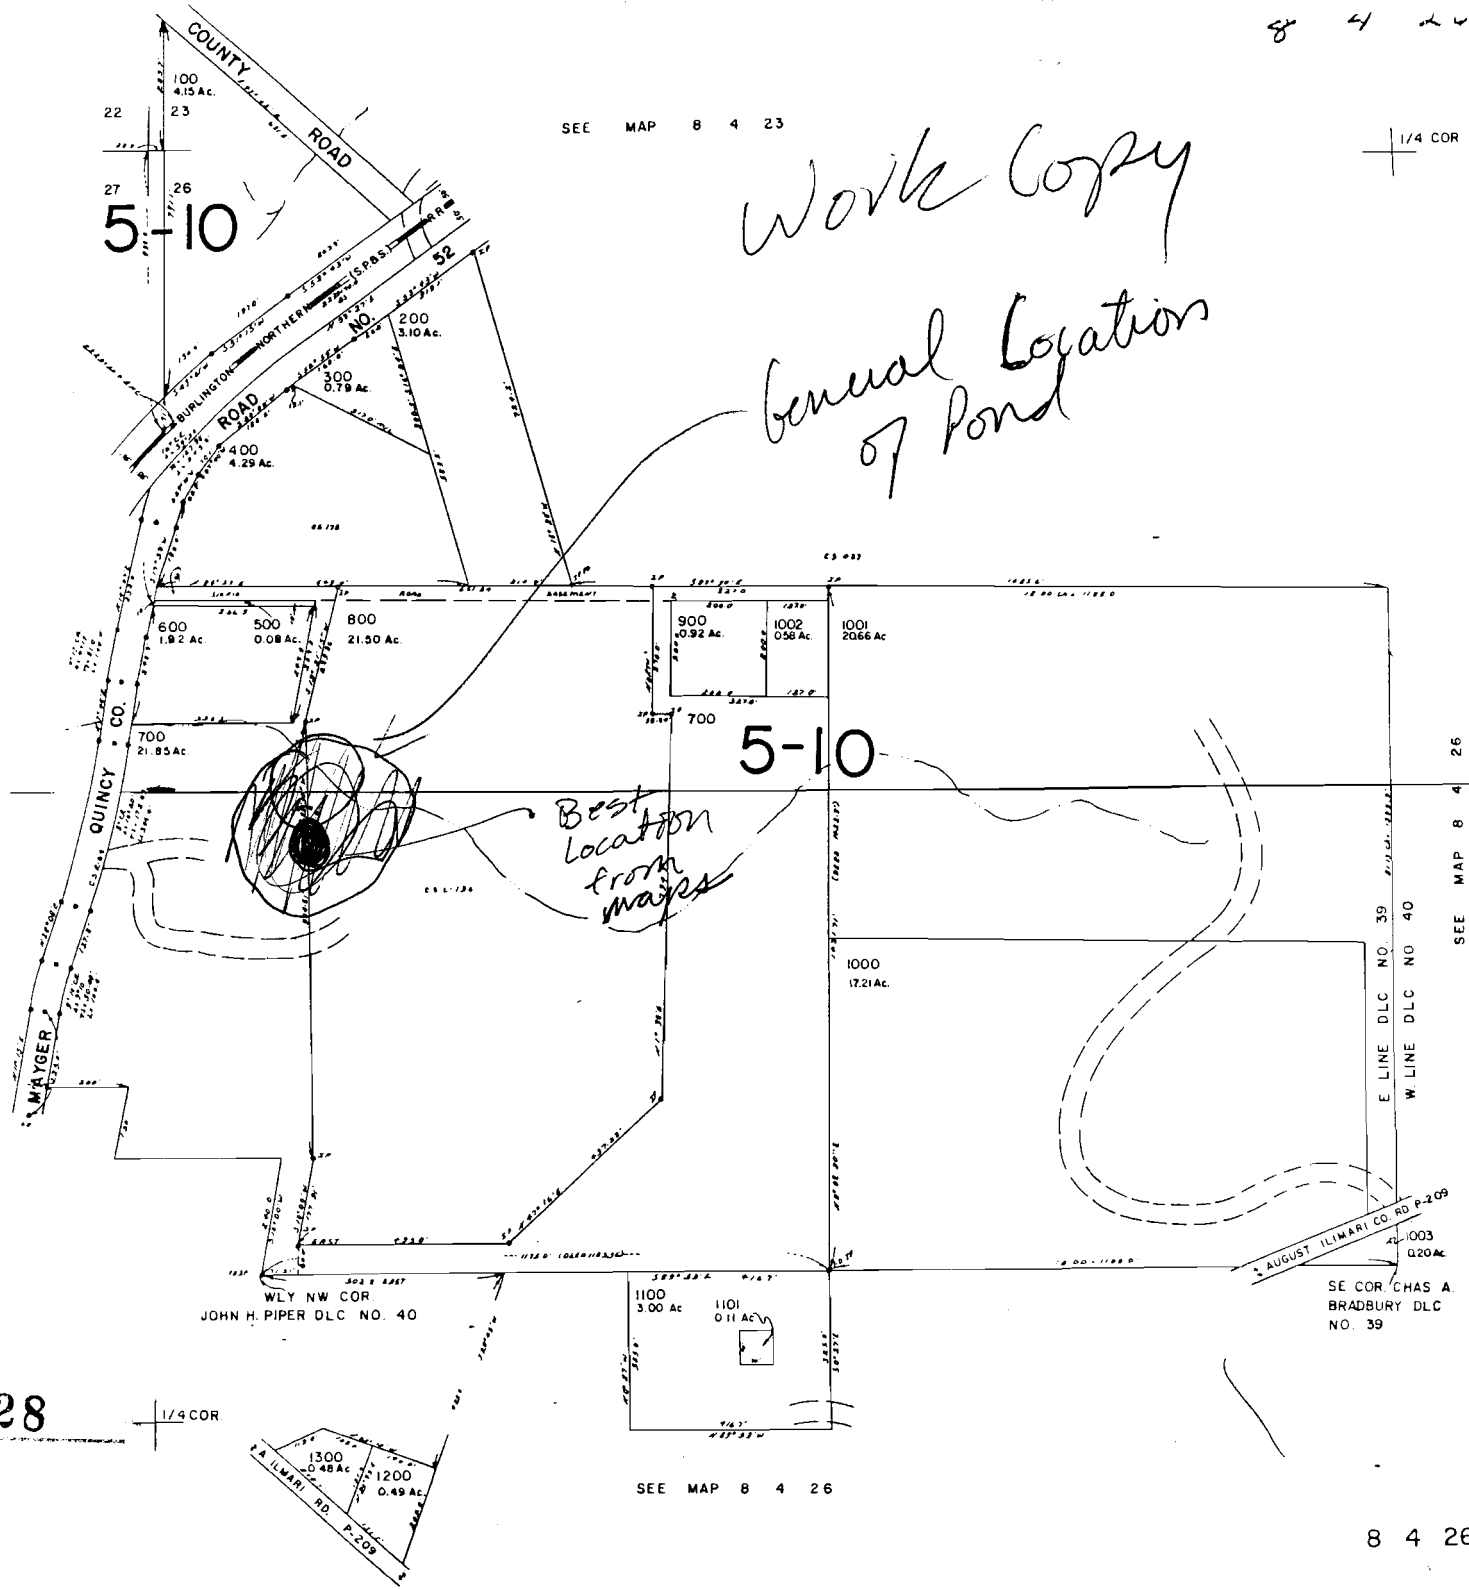

70528

1/4 COR

SEE MAP 8 4 26

Application No. R-76598

Permit No.
70528

SOIL and CAPABILITY MAP



Prepared by UNITED STATES DEPARTMENT of AGRICULTURE * SOIL CONSERVATION SERVICE
cooperating with

Clatskanie
U.S. DISTRICT AND AGENCIES COOPERATING IN SOIL SURVEY


OWNER Edward Sirmio

FARM NO. 346 DATE 6-58

OPERATOR Columbia, Oregon

SCALE 1" = 660' ACRES 65

PHOTO NO. BAS 8M-89

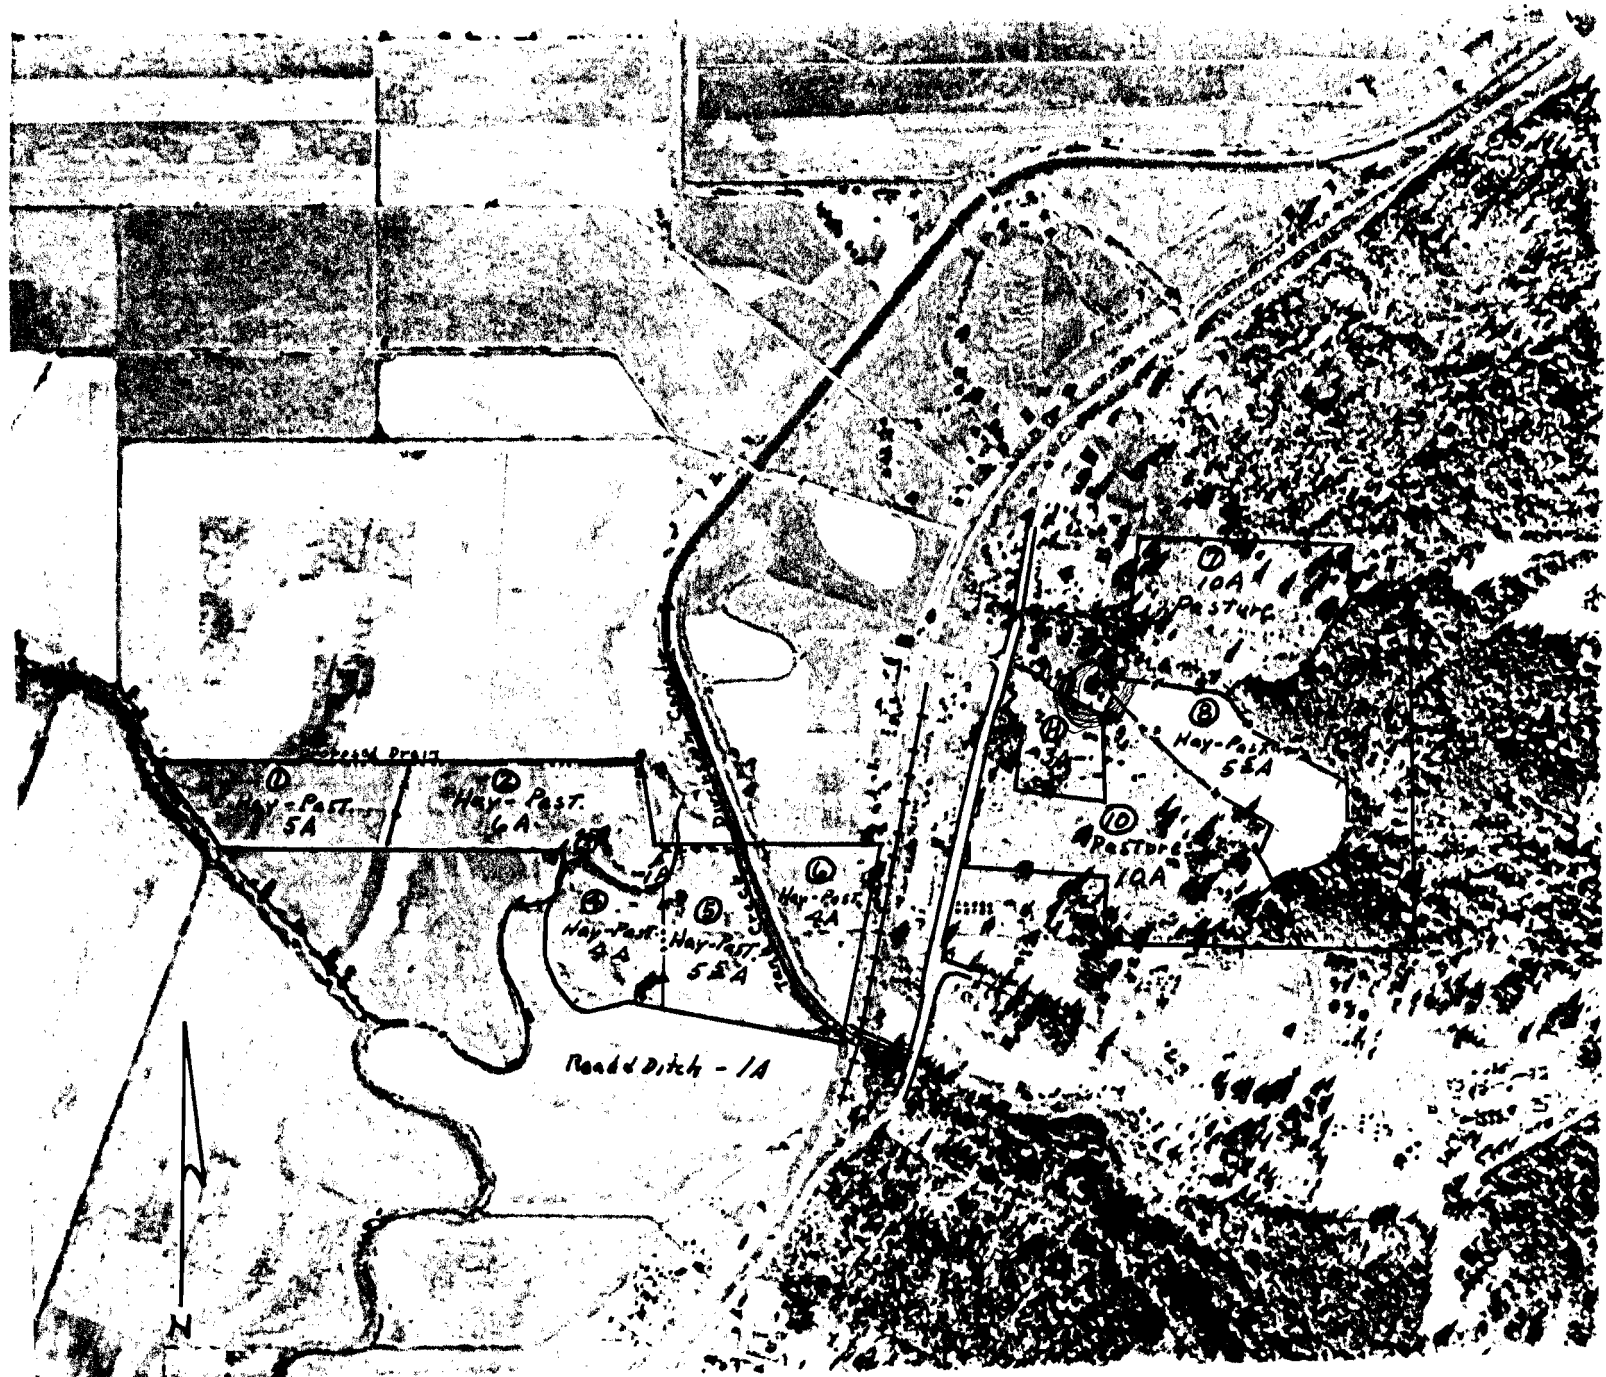

No Final Proof Map available

No Permit Map available