

HB 2153

Application No. 2-76591  
Permit No.

REVISED ON  
10-24-91

30 5 1

Calvin & Kathy Linn  
112 Rokos Ln  
Canyonville OR 97417

SE 1/4 SEC. 13 T.30S. R.5W. WM.  
DOUGLAS COUNTY

1" = 200'


This map was prepared for  
assessment purposes only.

CERTIFICATE NO. 70529

SEE MAP 30 5 13

CEN. SEC

APPROX.  
1/4 COR.

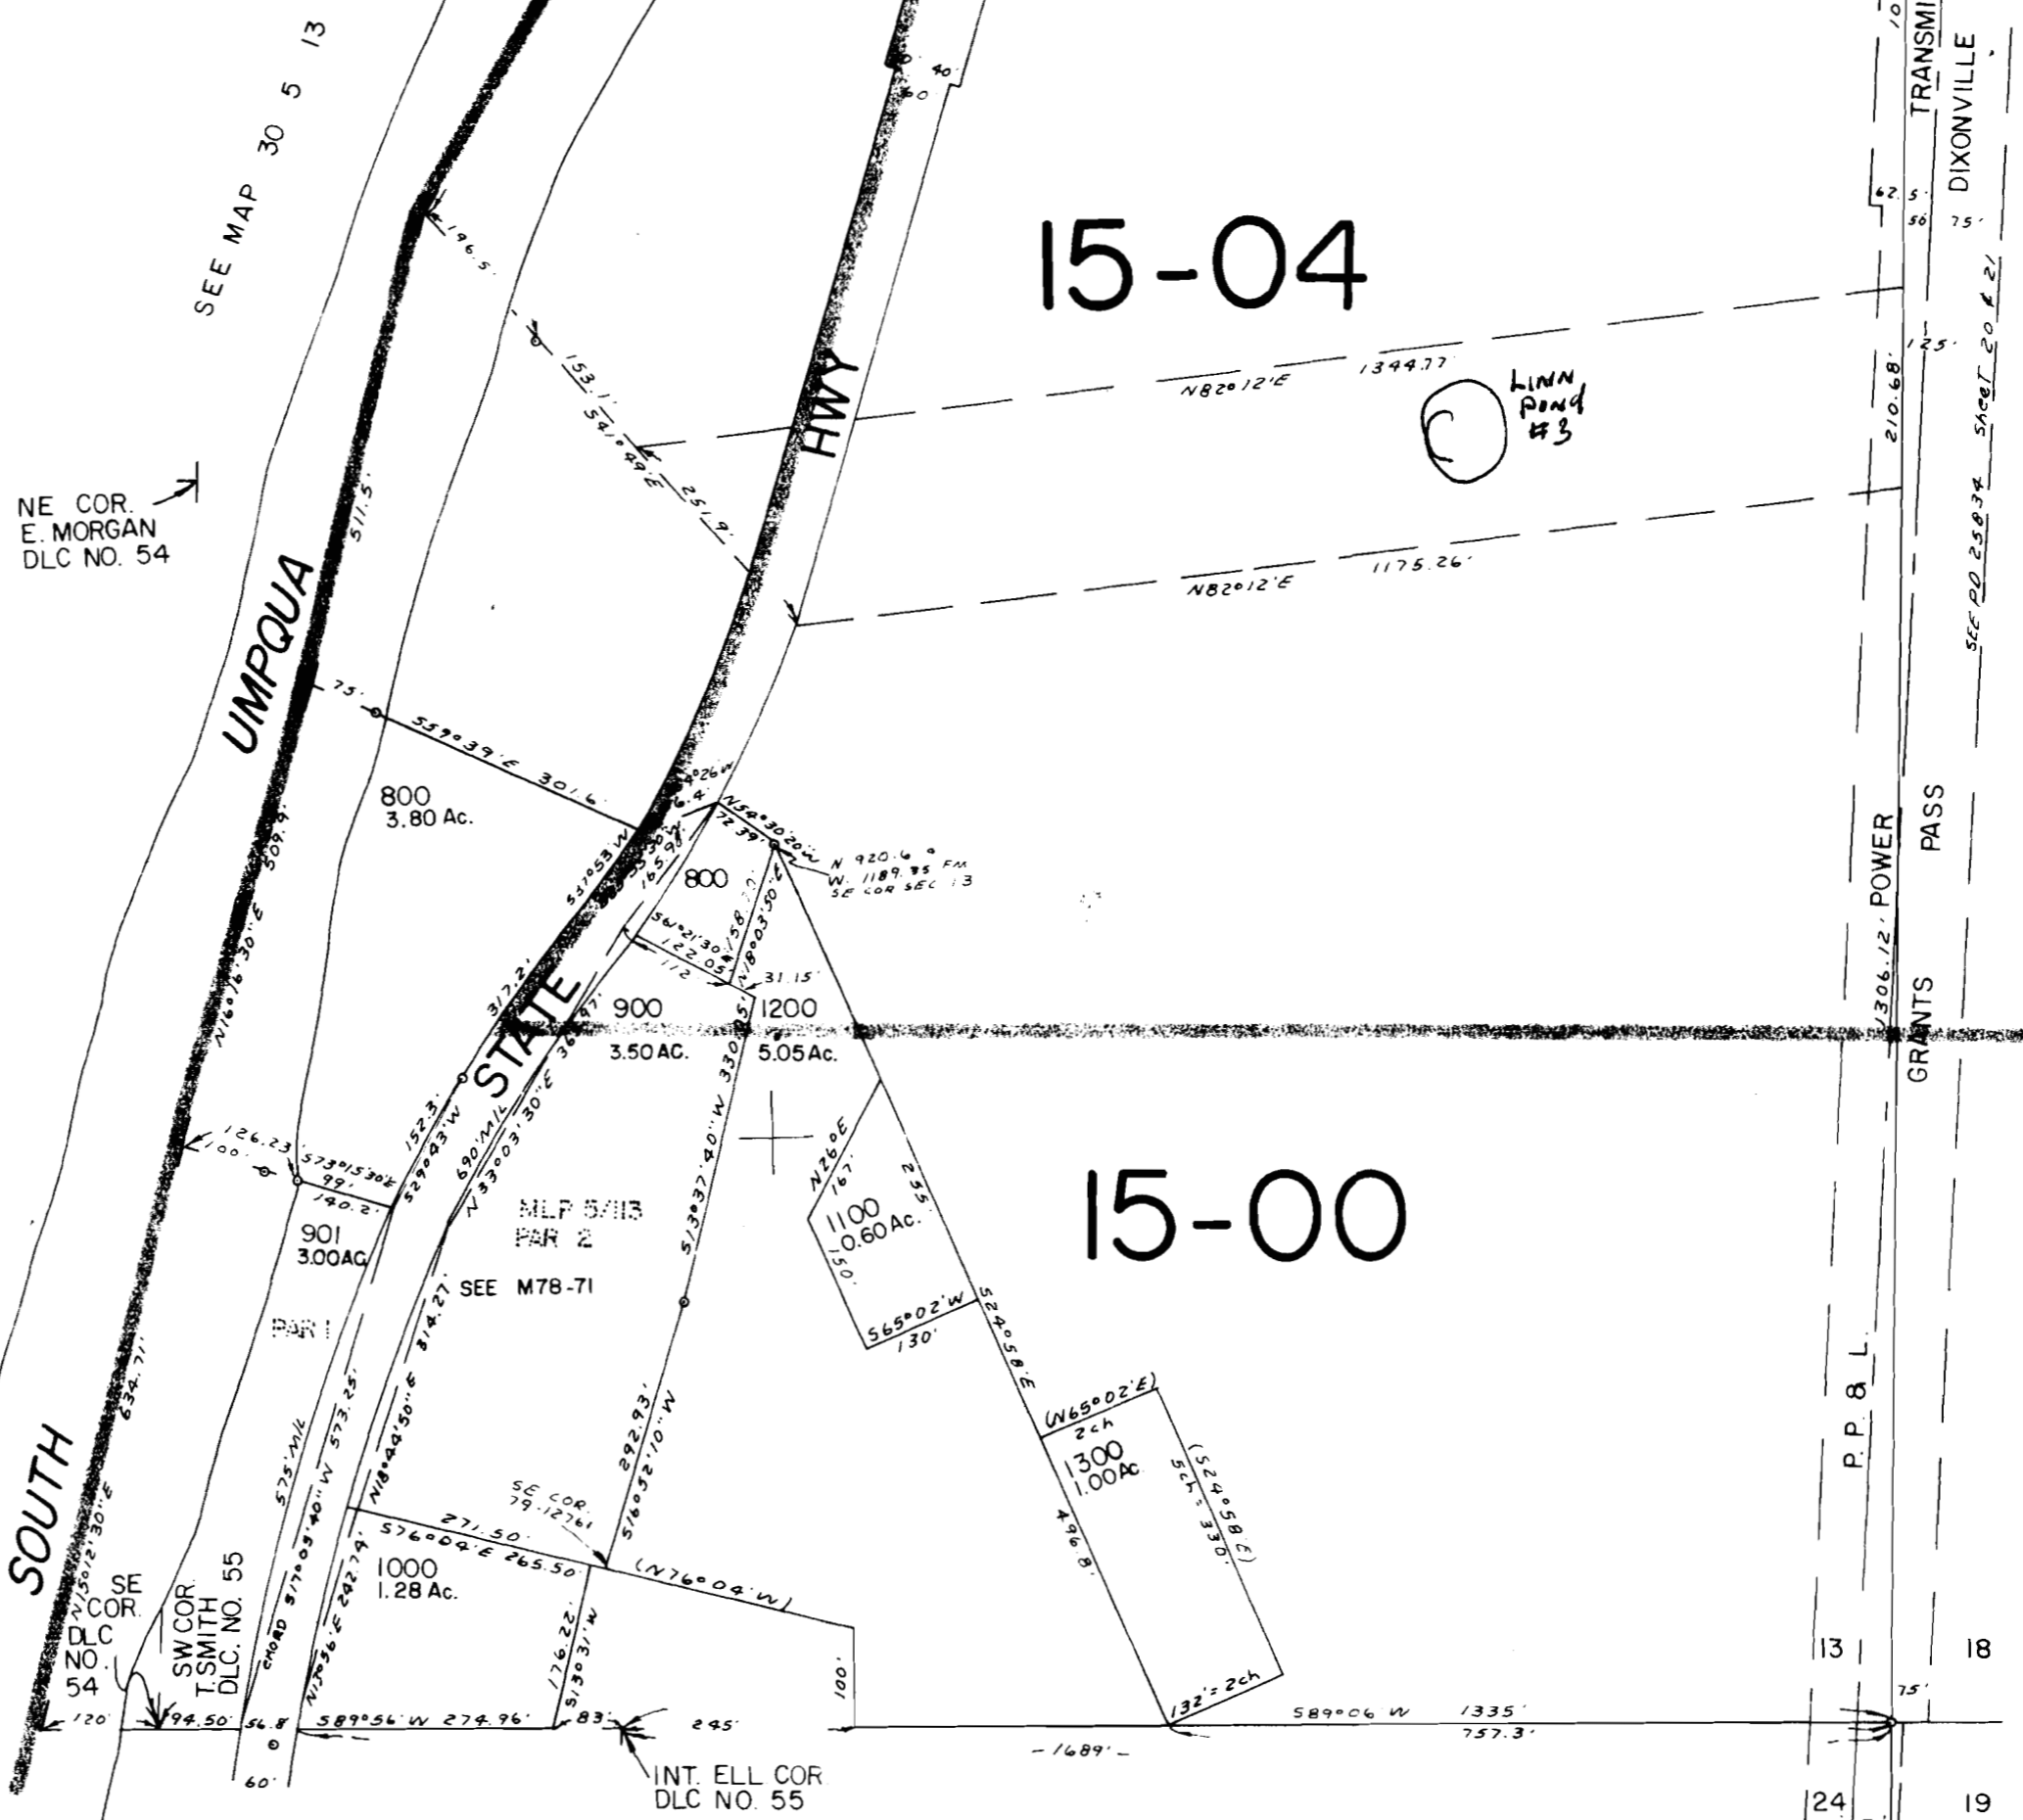

NE COR.  
E. MORGAN  
DLC NO. 54

SEE MAP 30 5 13

15-04

Linn Pond #3

15-00

SOUTH

SE COR.  
Z. C. C.  
DLC NO. 54

SW COR.  
T. SMITH  
DLC NO. 55

INT. ELL COR  
DLC NO. 55

INT. ELL COR  
DLC NO. 54

1/4 COR.

GRANTS  
PASS

P.P.B.L.

13 18  
24 50 50 19

SEE MAP 30 4 18

SEE MAP 30 5 24A

30 5

HB 2153

SECTION 19 T.30S. R.4W. W.M.  
DOUGLAS COUNTY

30 4 19

THIS MAP WAS PREPARED FOR  
ASSESSMENT PURPOSE ONLY.

Calvin + Kathy Linn  
112 Kokos Ln  
Canyonville OR 97417

1"=400'


Application No. R-76599  
Permit No.

JAN 1995

SEE MAP 30 4 18

SE COR  
JACOB SLIPPY  
DLC NO. 37

CERTIFICATE NO. 70529  
N89°25'E 41.21 CH GLO

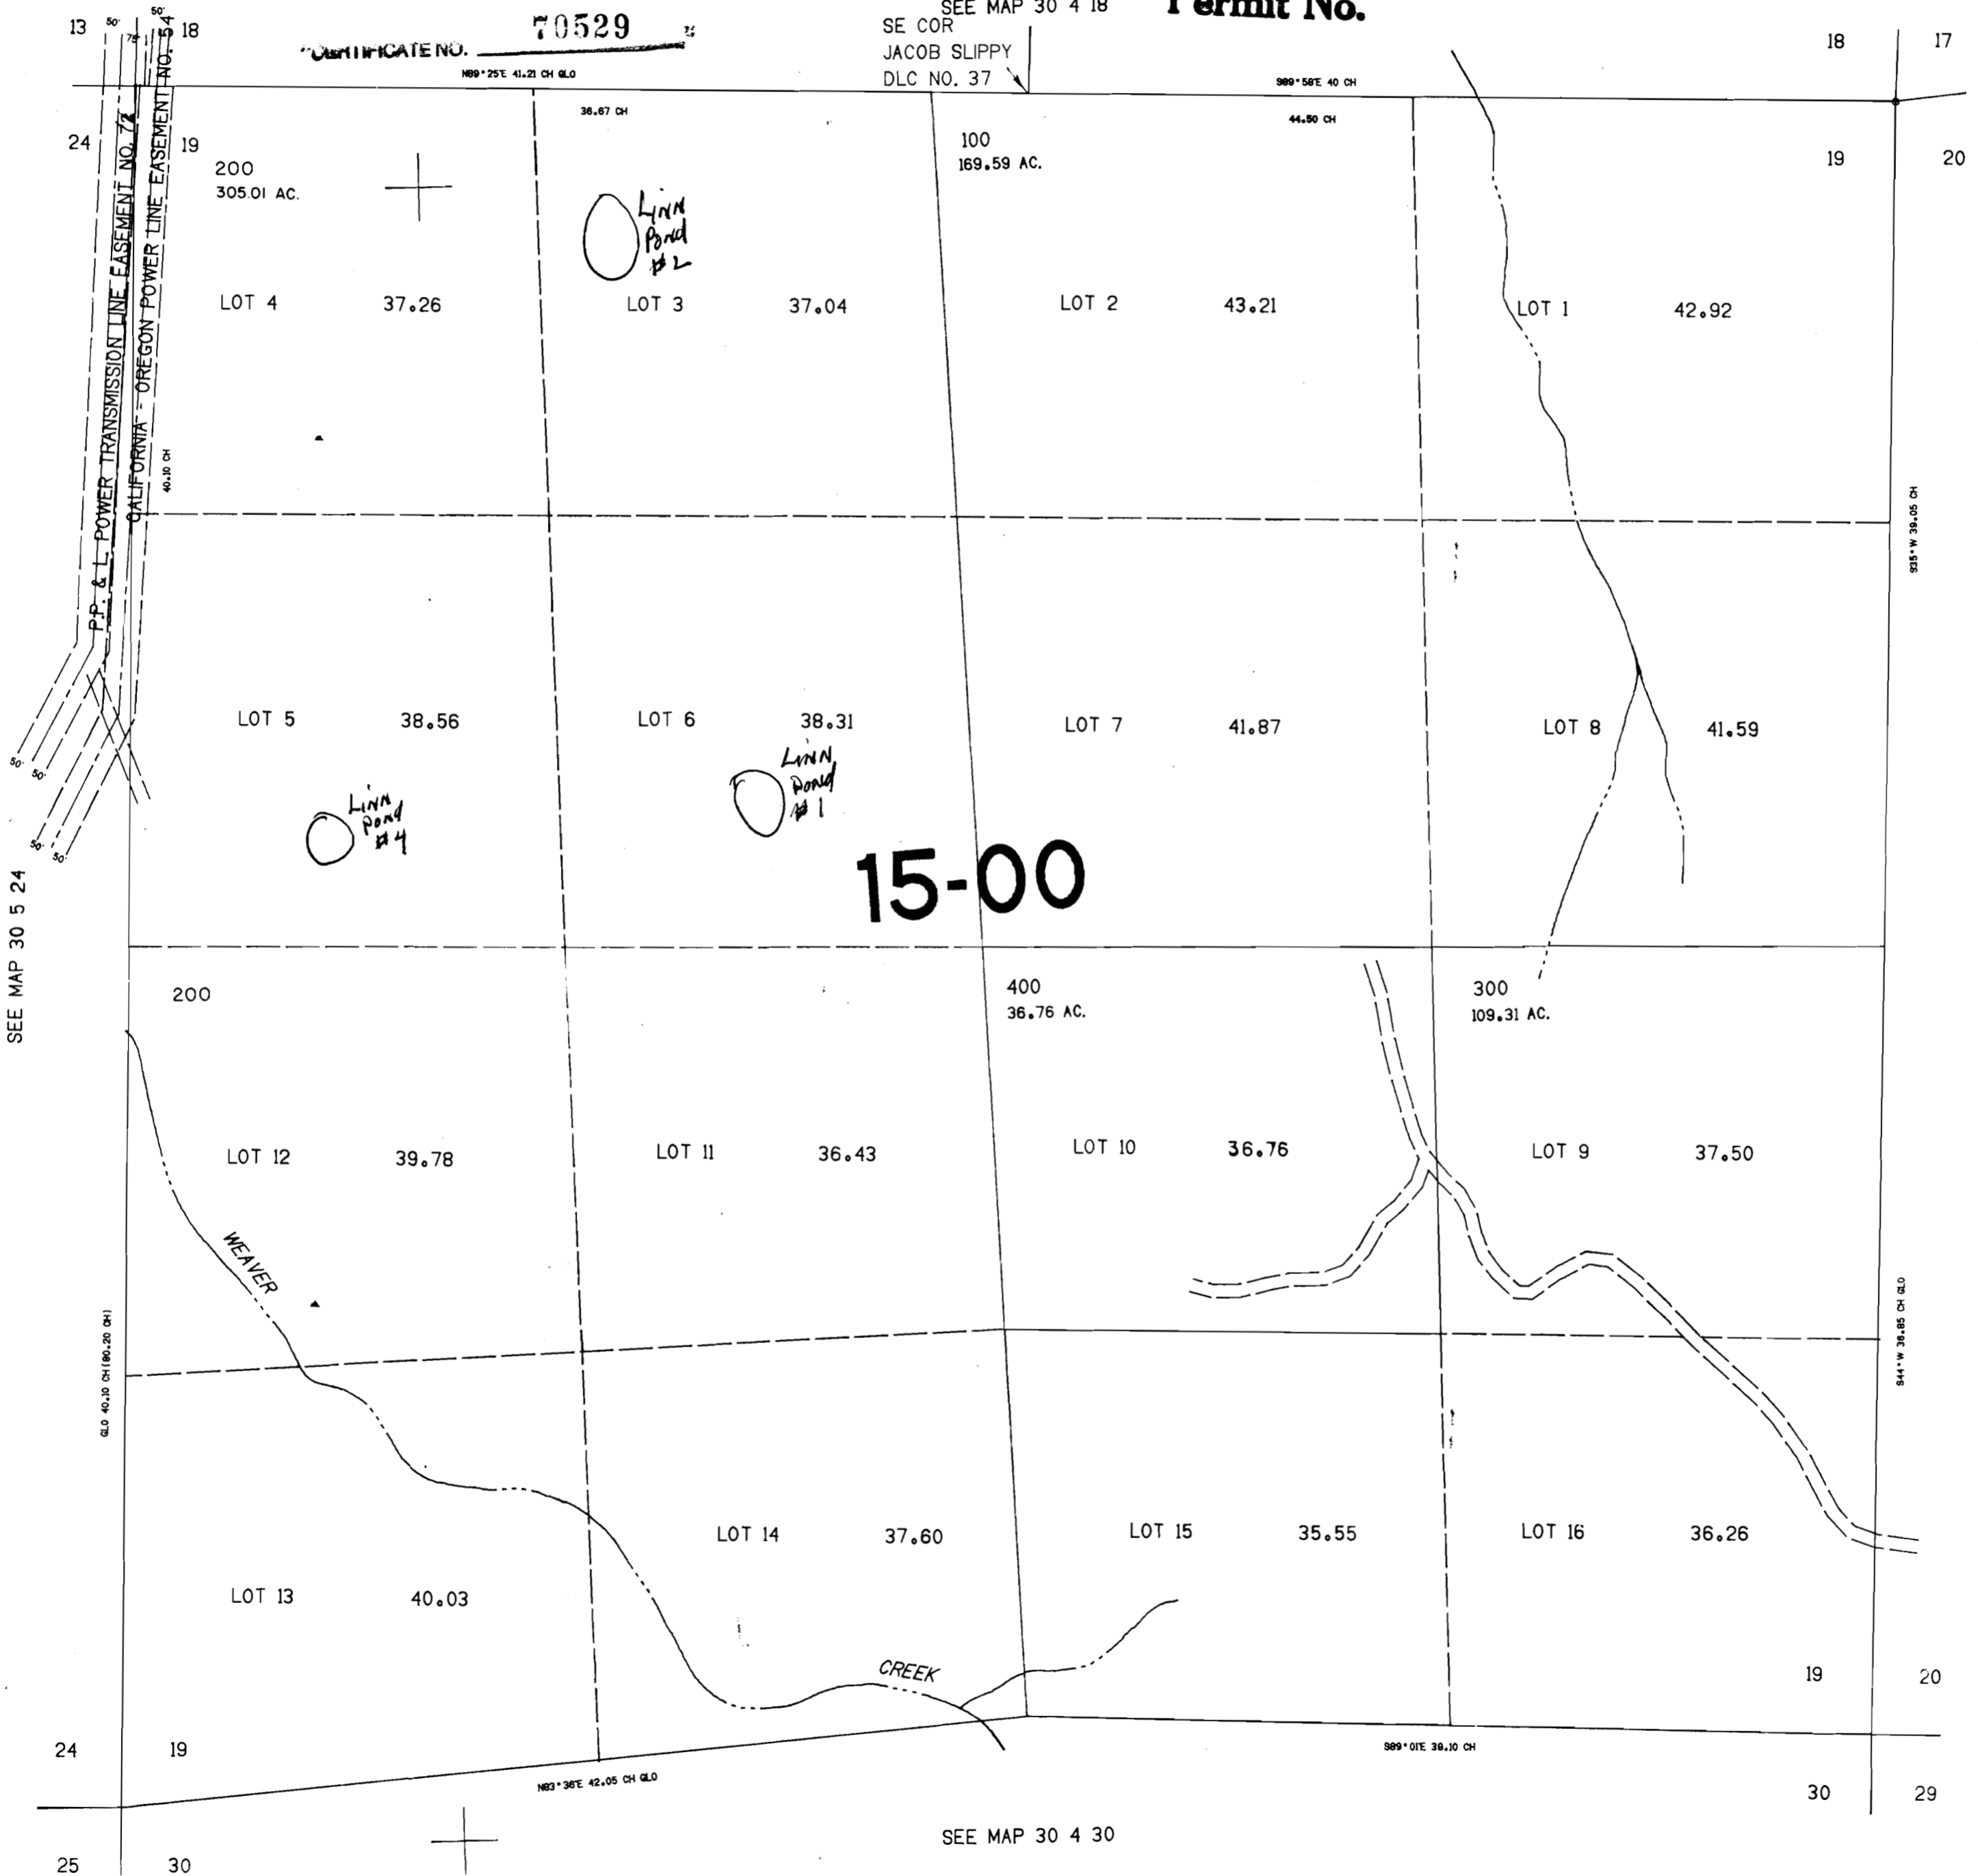

15-00

SEE MAP 30 4 30

SEE MAP 30 4 20

476.000

30 4 19

No Final Proof Map available

No Permit Map available