

Application No. R-76605

Permit No.

RECEIVED

CERTIFICATE NO. 70536


JAN - 3 1995

PINE 16 MILES R. 9 E. 37'30"

R. 10 E. 121'30"

LA PINE 14 MILES

R. 11 E. 22'30"

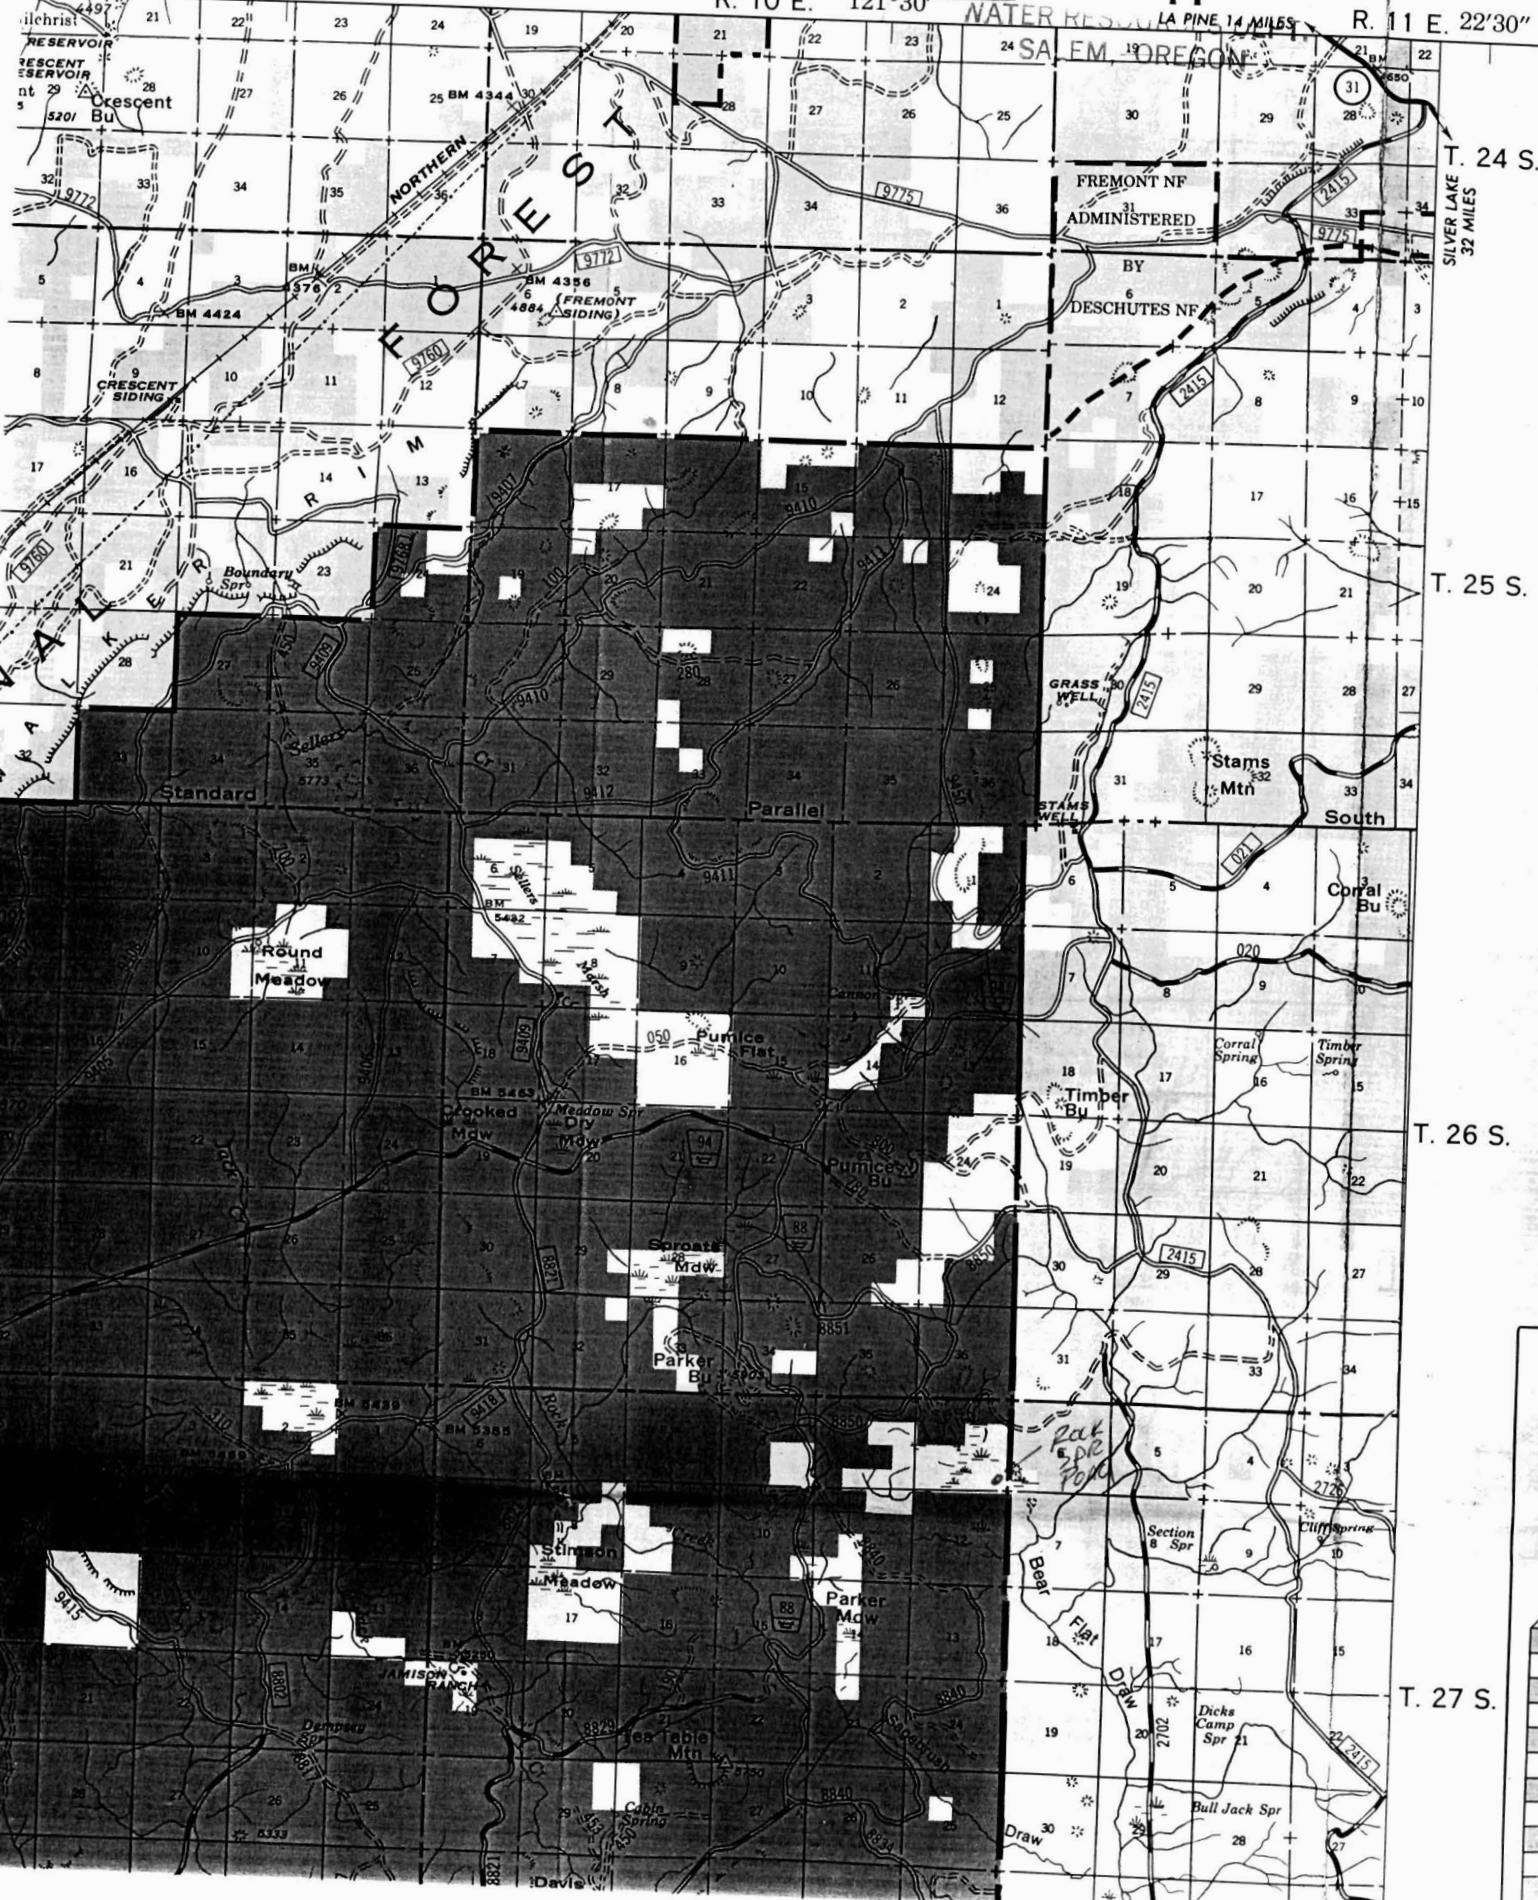

T. 24 S.

T. 25 S.

T. 26 S.

T. 27 S.