


Application No. R-76612
Permit No. 70542

RECEIVED

JAN - 3 1995

WATER RESOURCES DEPT
SALEM, OREGON

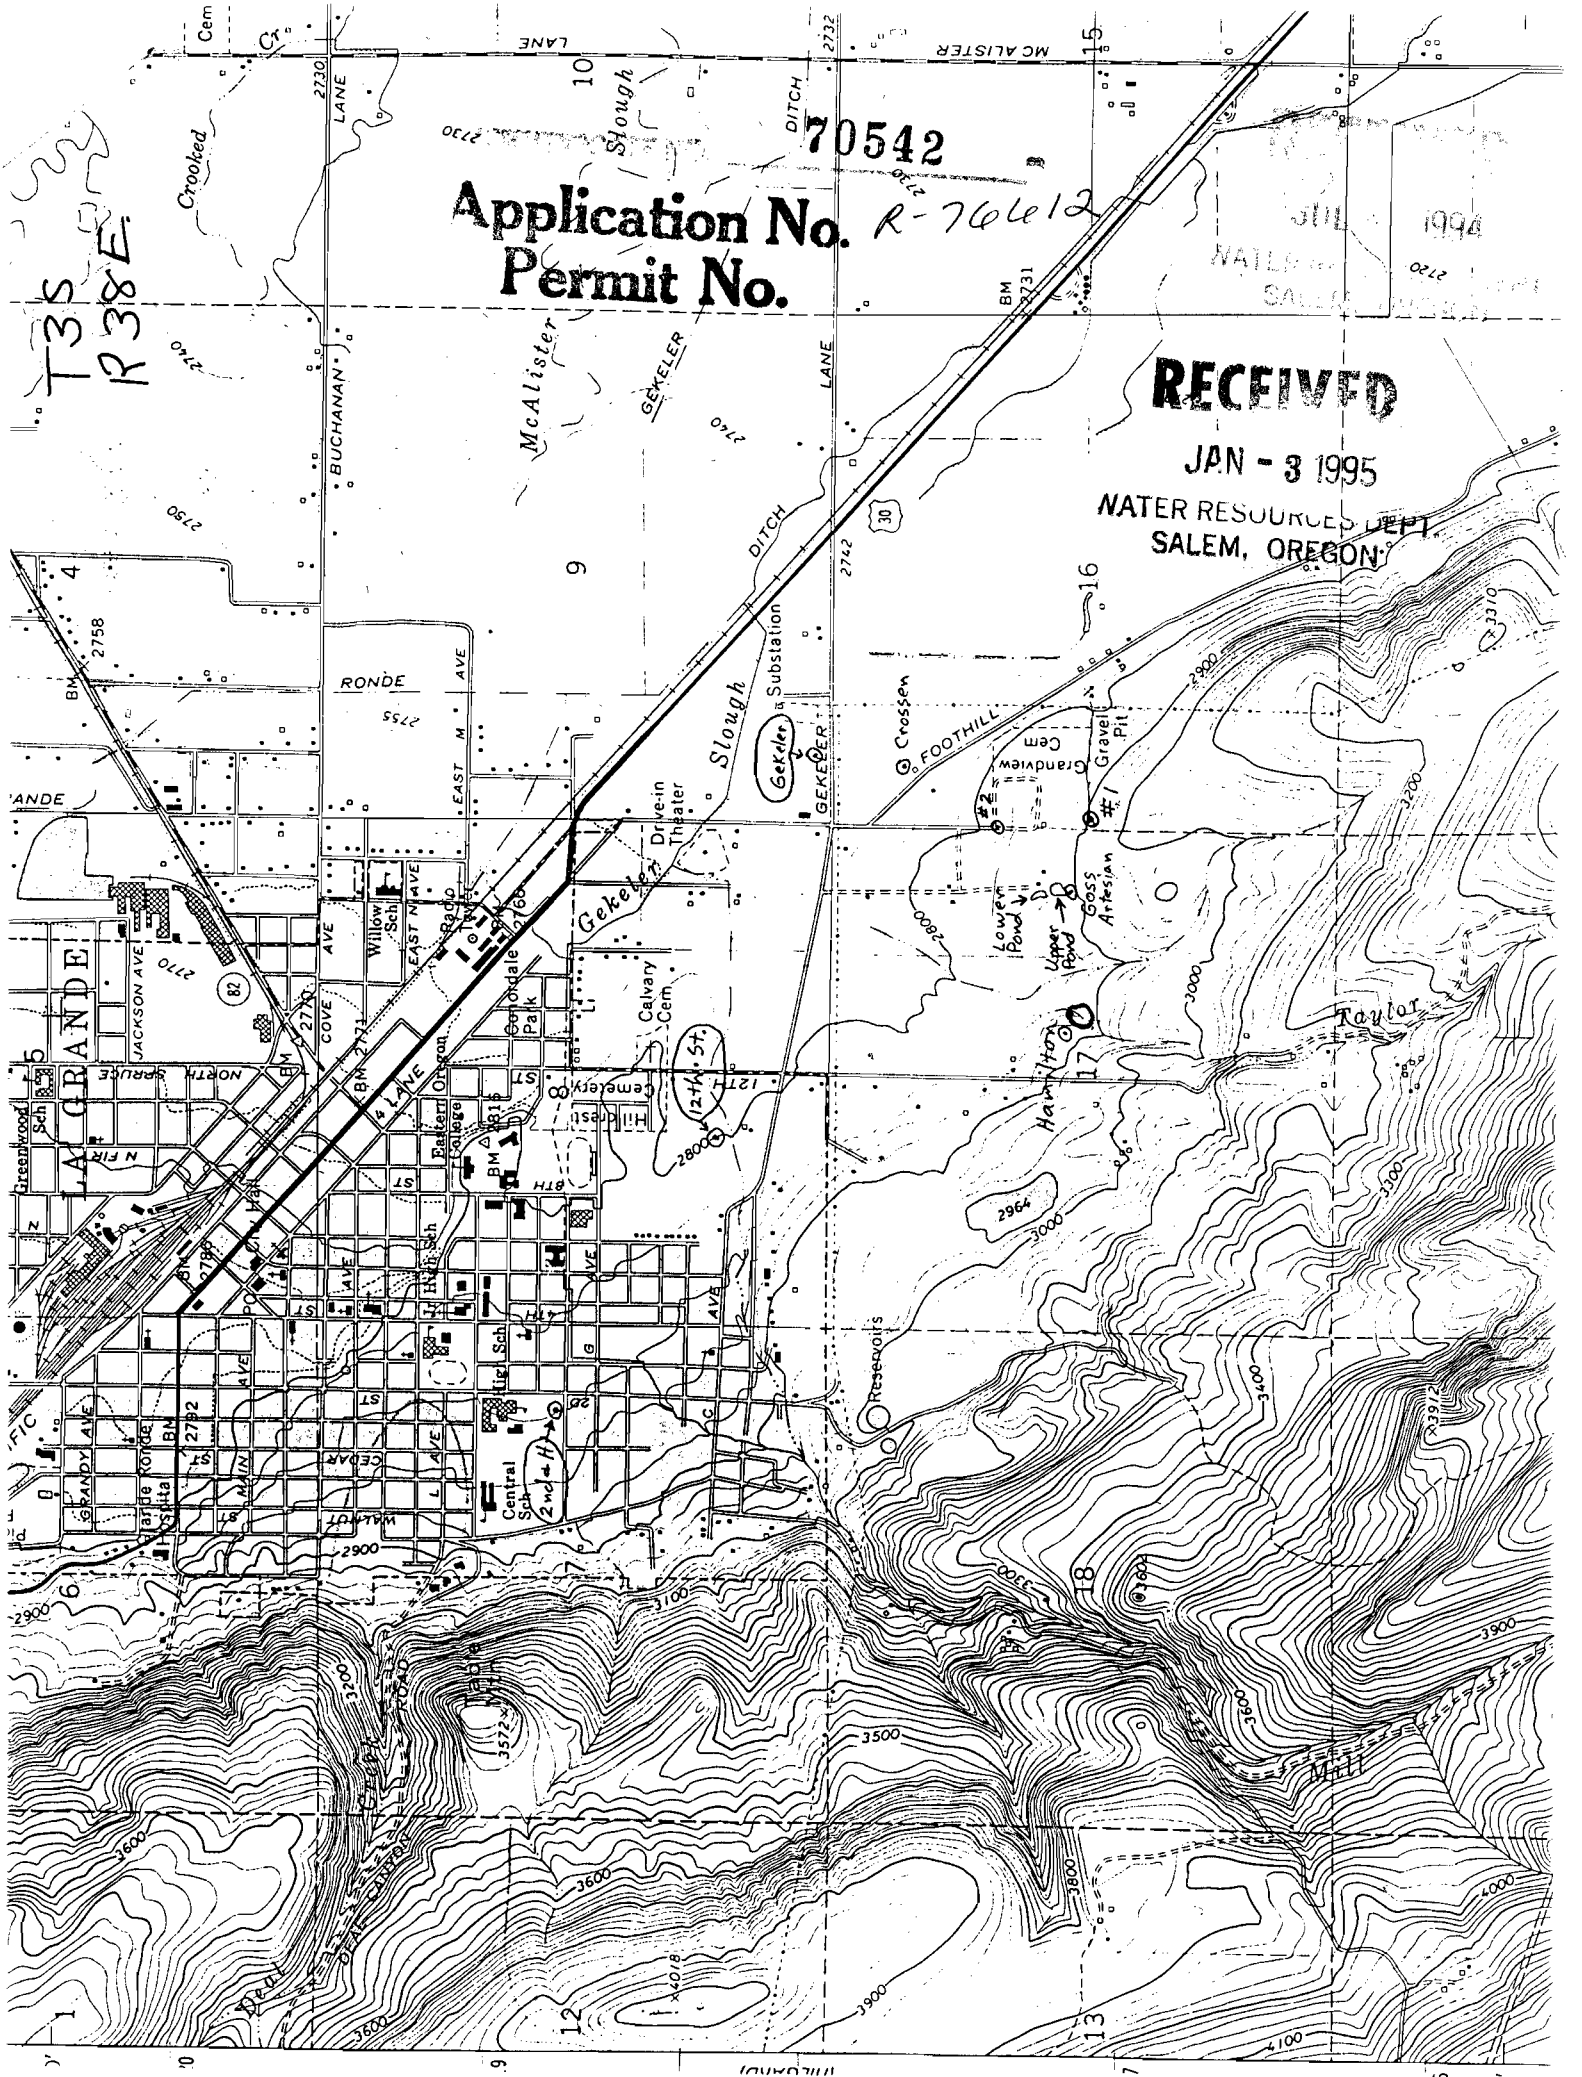

No Final Proof Map available

No Permit Map available