


T.7S. R.46E. W.M.

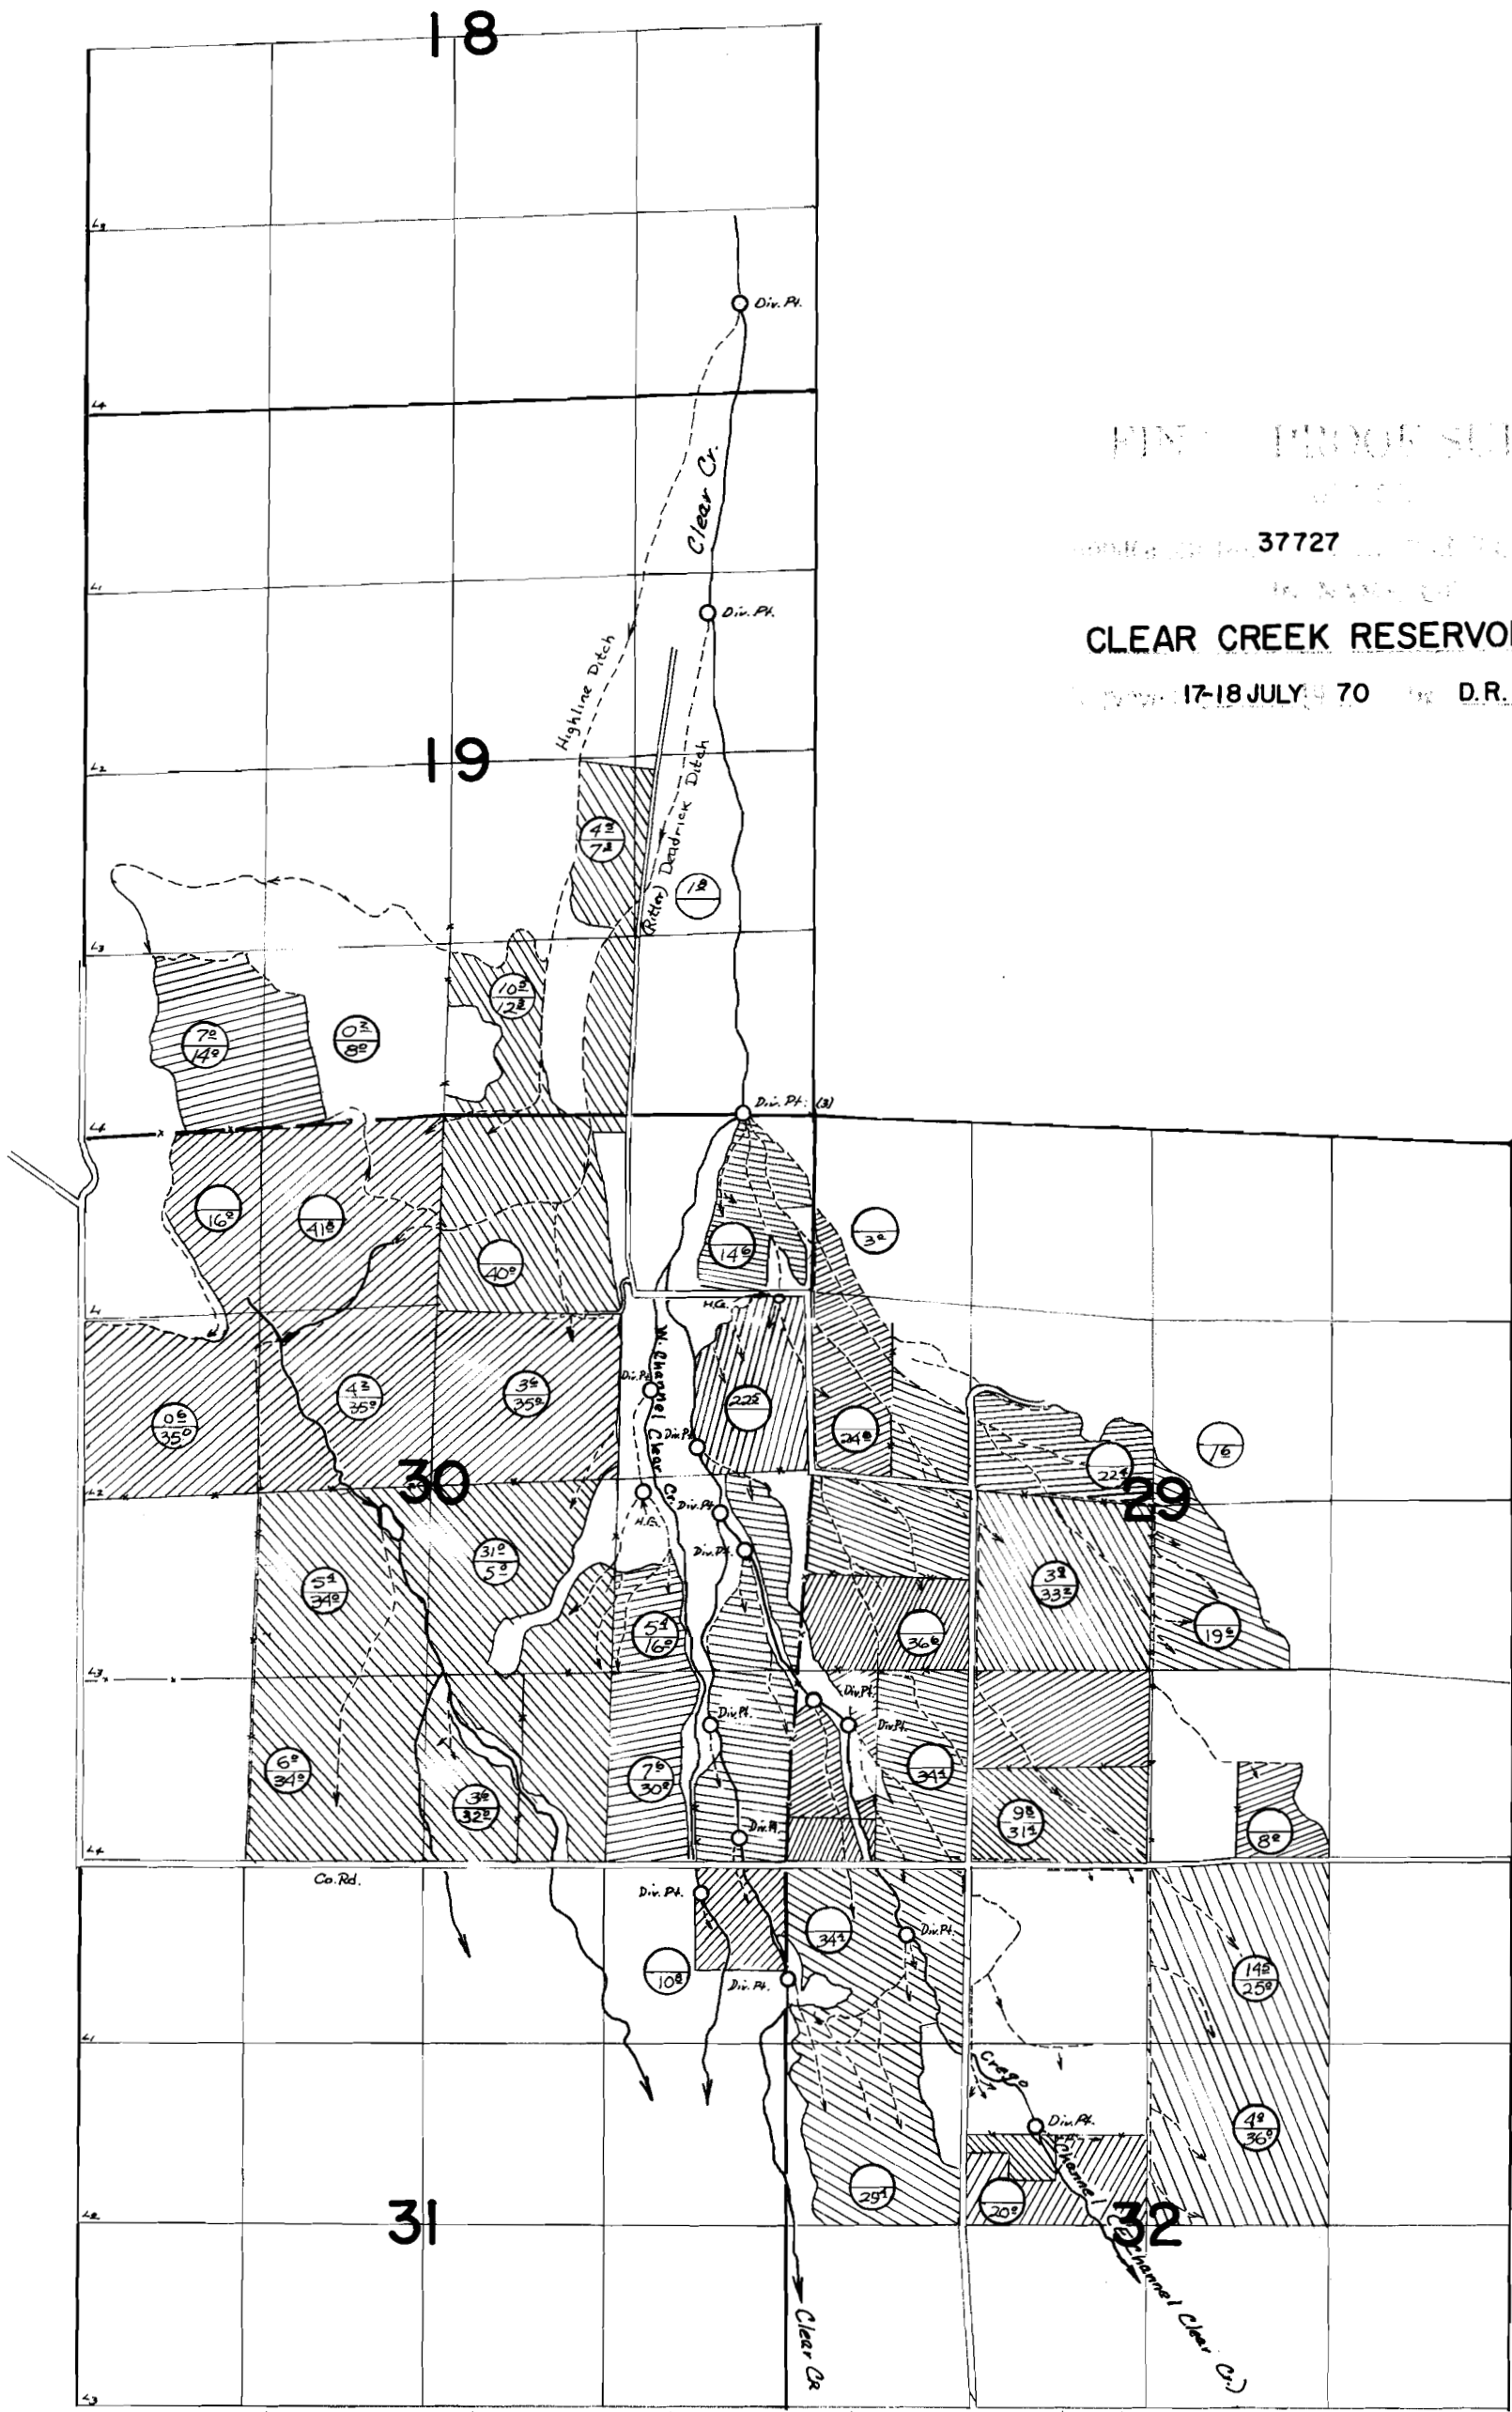

FINAL PROOF SURVEY  
 37727 28549  
**CLEAR CREEK RESERVOIR CO.**  
 17-18 JULY 70 D.R. BUELL

Div. Pts. Loc.: Main Channel Clear Cr. 11370'N & 4760'E.; 9110'N & 4540'E.; 5480'N & 4820'E.; 3090'N & 4490'E.; 2560'N & 4660'E.; 1020'N & 4590'E.;  
 200'N & 4810'E.; 820'S & 5160'E. Crego (East) Channel Clear Cr. 2280'N & 4840'E.; 1200'N & 5340'E.; 1020'N & 5990'E.; 500'S & 6020'E.;  
 1900'S & 6980'E. West Channel Clear Cr. 3460'N & 4140'E.; 190'S & 4530'E. all fm. SW. Cor. Sec. 30.

○ Permit 28549  
 Prior Clear Cr. Rts.