


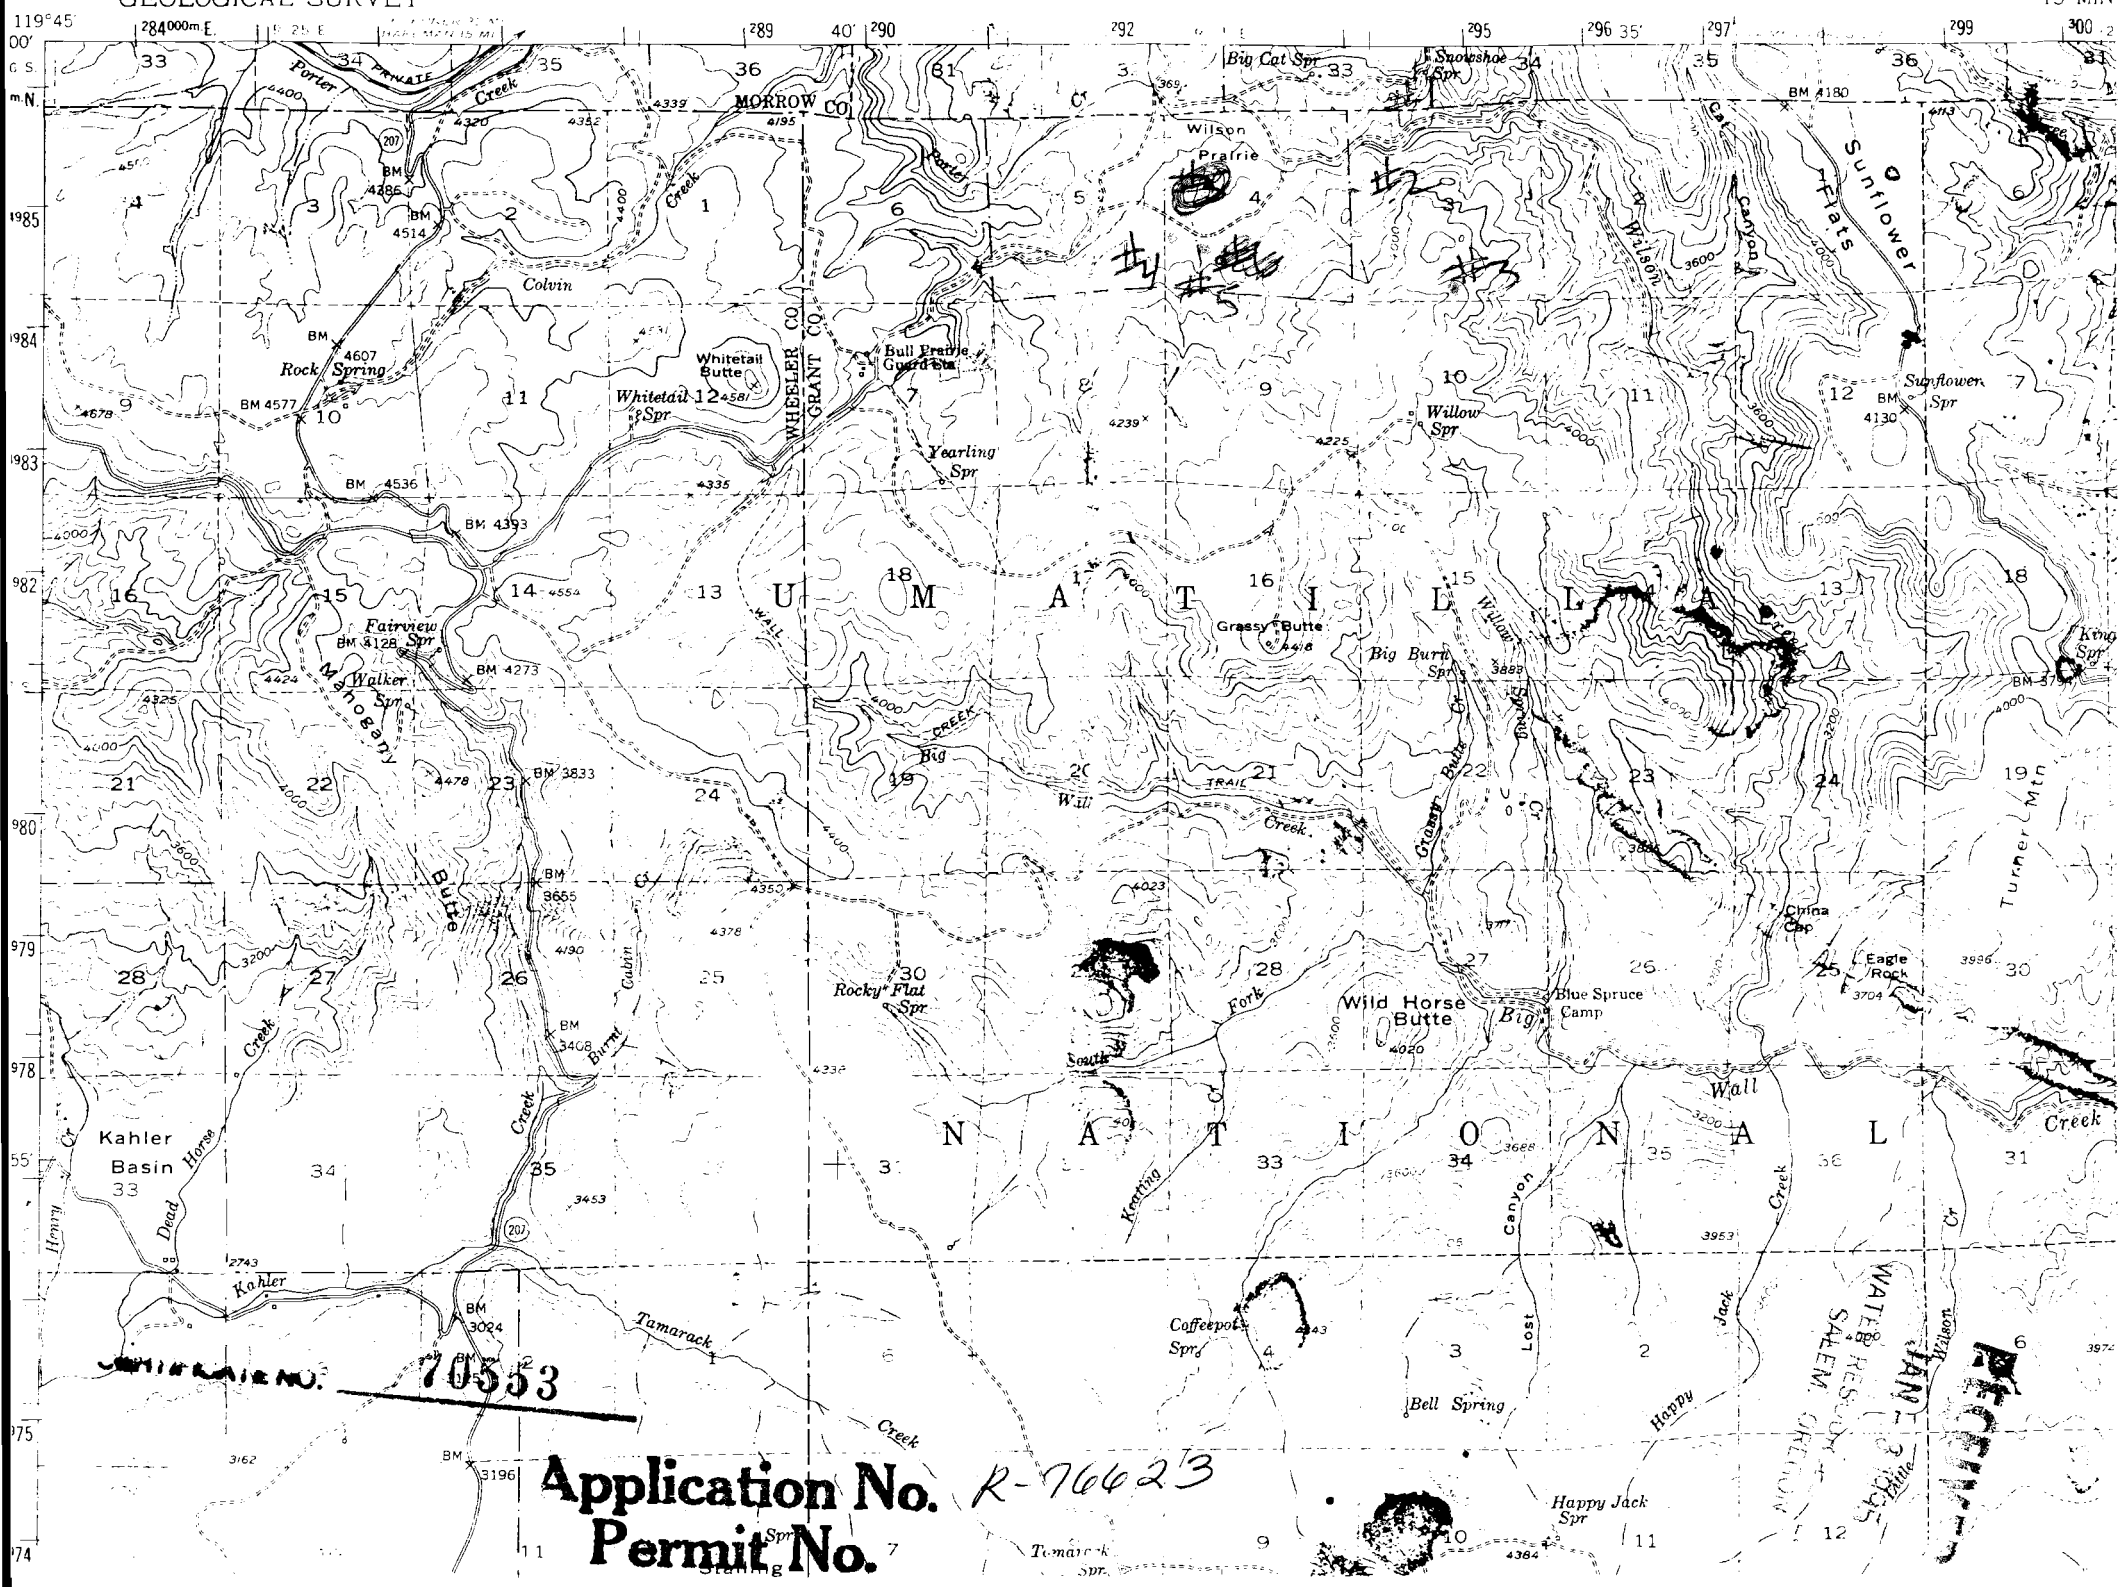

70553

Application No. R-76623
Permit No. 7

WATER RES. DIV.
SALEM, OREGON
JAN 3 1945
RECEIVED

No Final Proof Map available

No Permit Map available