

Application No. R-76624
Permit No.


RECEIVED

JAN - 3 1995

WATER RESOURCES DEPT.
SALEM, OREGON

CERTIFICATE NO. 70554

T. 30S., R. 37E., W.M.

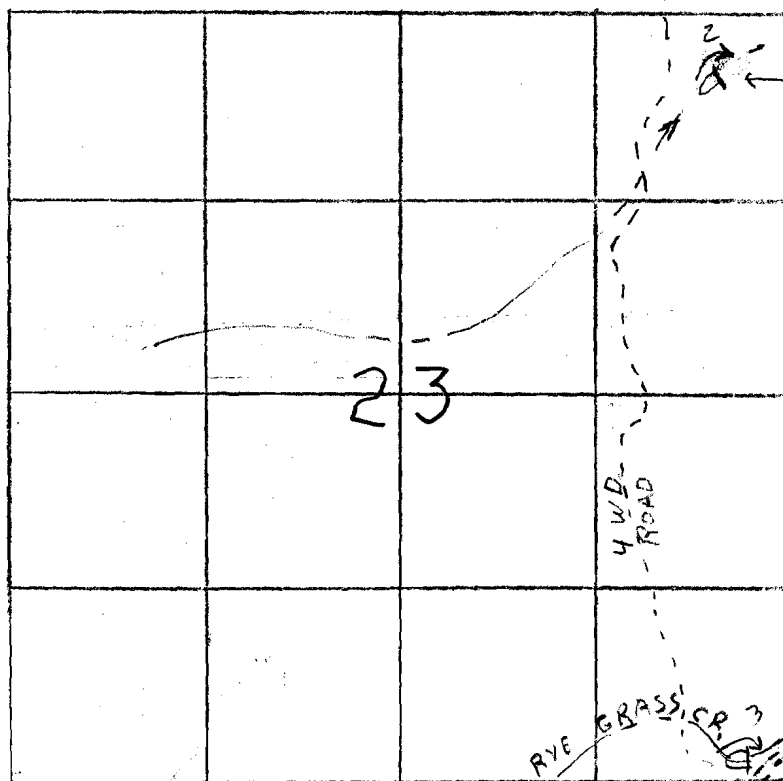

TERRY RES.

1. SOURCE; SNOWMELT
2. DAM HT.: 10', EARTH FILL
4. 1 ACRE FT. STORAGE
- 1 1/3 ACRE SUBMERGED
MAX DEPTH 10'
5. SPILLWAY: AROUND
THE DAM, NORTH SIDE
2' DEEP x 12' WIDE x
20' LONG

ARAMBERRU RES.

1. SOURCE - RYE GRASS CREEK,
SNOWMELT
2. DAM HT. 8', EARTH FILL
4. 1 ACRE FT. STORAGE
- 1 1/4 ACRE SUBMERGED
MAX DEPTH 8'
5. SPILLWAY: AROUND THE DAM,
NORTHSIDE 3' DEEP x 6' WIDE x
50' LONG

Application No. R-70624
Permit No.


CERTIFICATE NO. 70554

RECEIVED

JAN - 3 1995

T. 30 S., R. 37 E., W. M.

WATER RESOURCES DIVISION
SALEM, OREGON

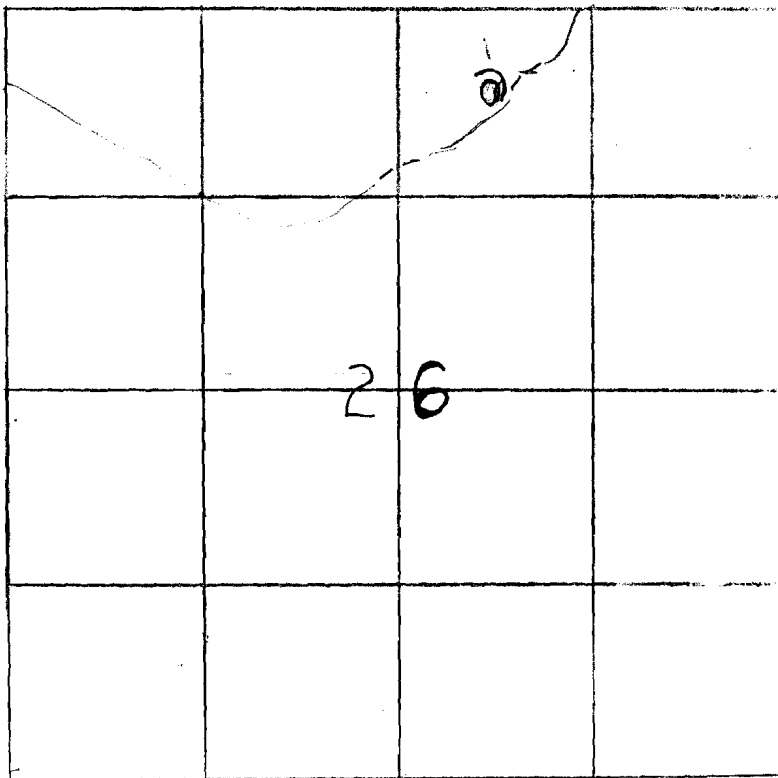

RYE GRASS SPRING

1. SOURCE : RYE GRASS SPRING
2. DAM HT, 4' ABOVE GROUND LEVEL,
EARTH FILL
4. 1/25 ACRE FT. STORAGE
1/62 ACRES SUBMERGED
MAX. DEPTH 6'
5. OFF CHANNEL, NO SPILLWAY

No Final Proof Map available

No Permit Map available