


JAN - 3 1995
WATER RESOURCES CENTER
SALEM, OREGON

Application No. R-76634
Permit No. 701

70566

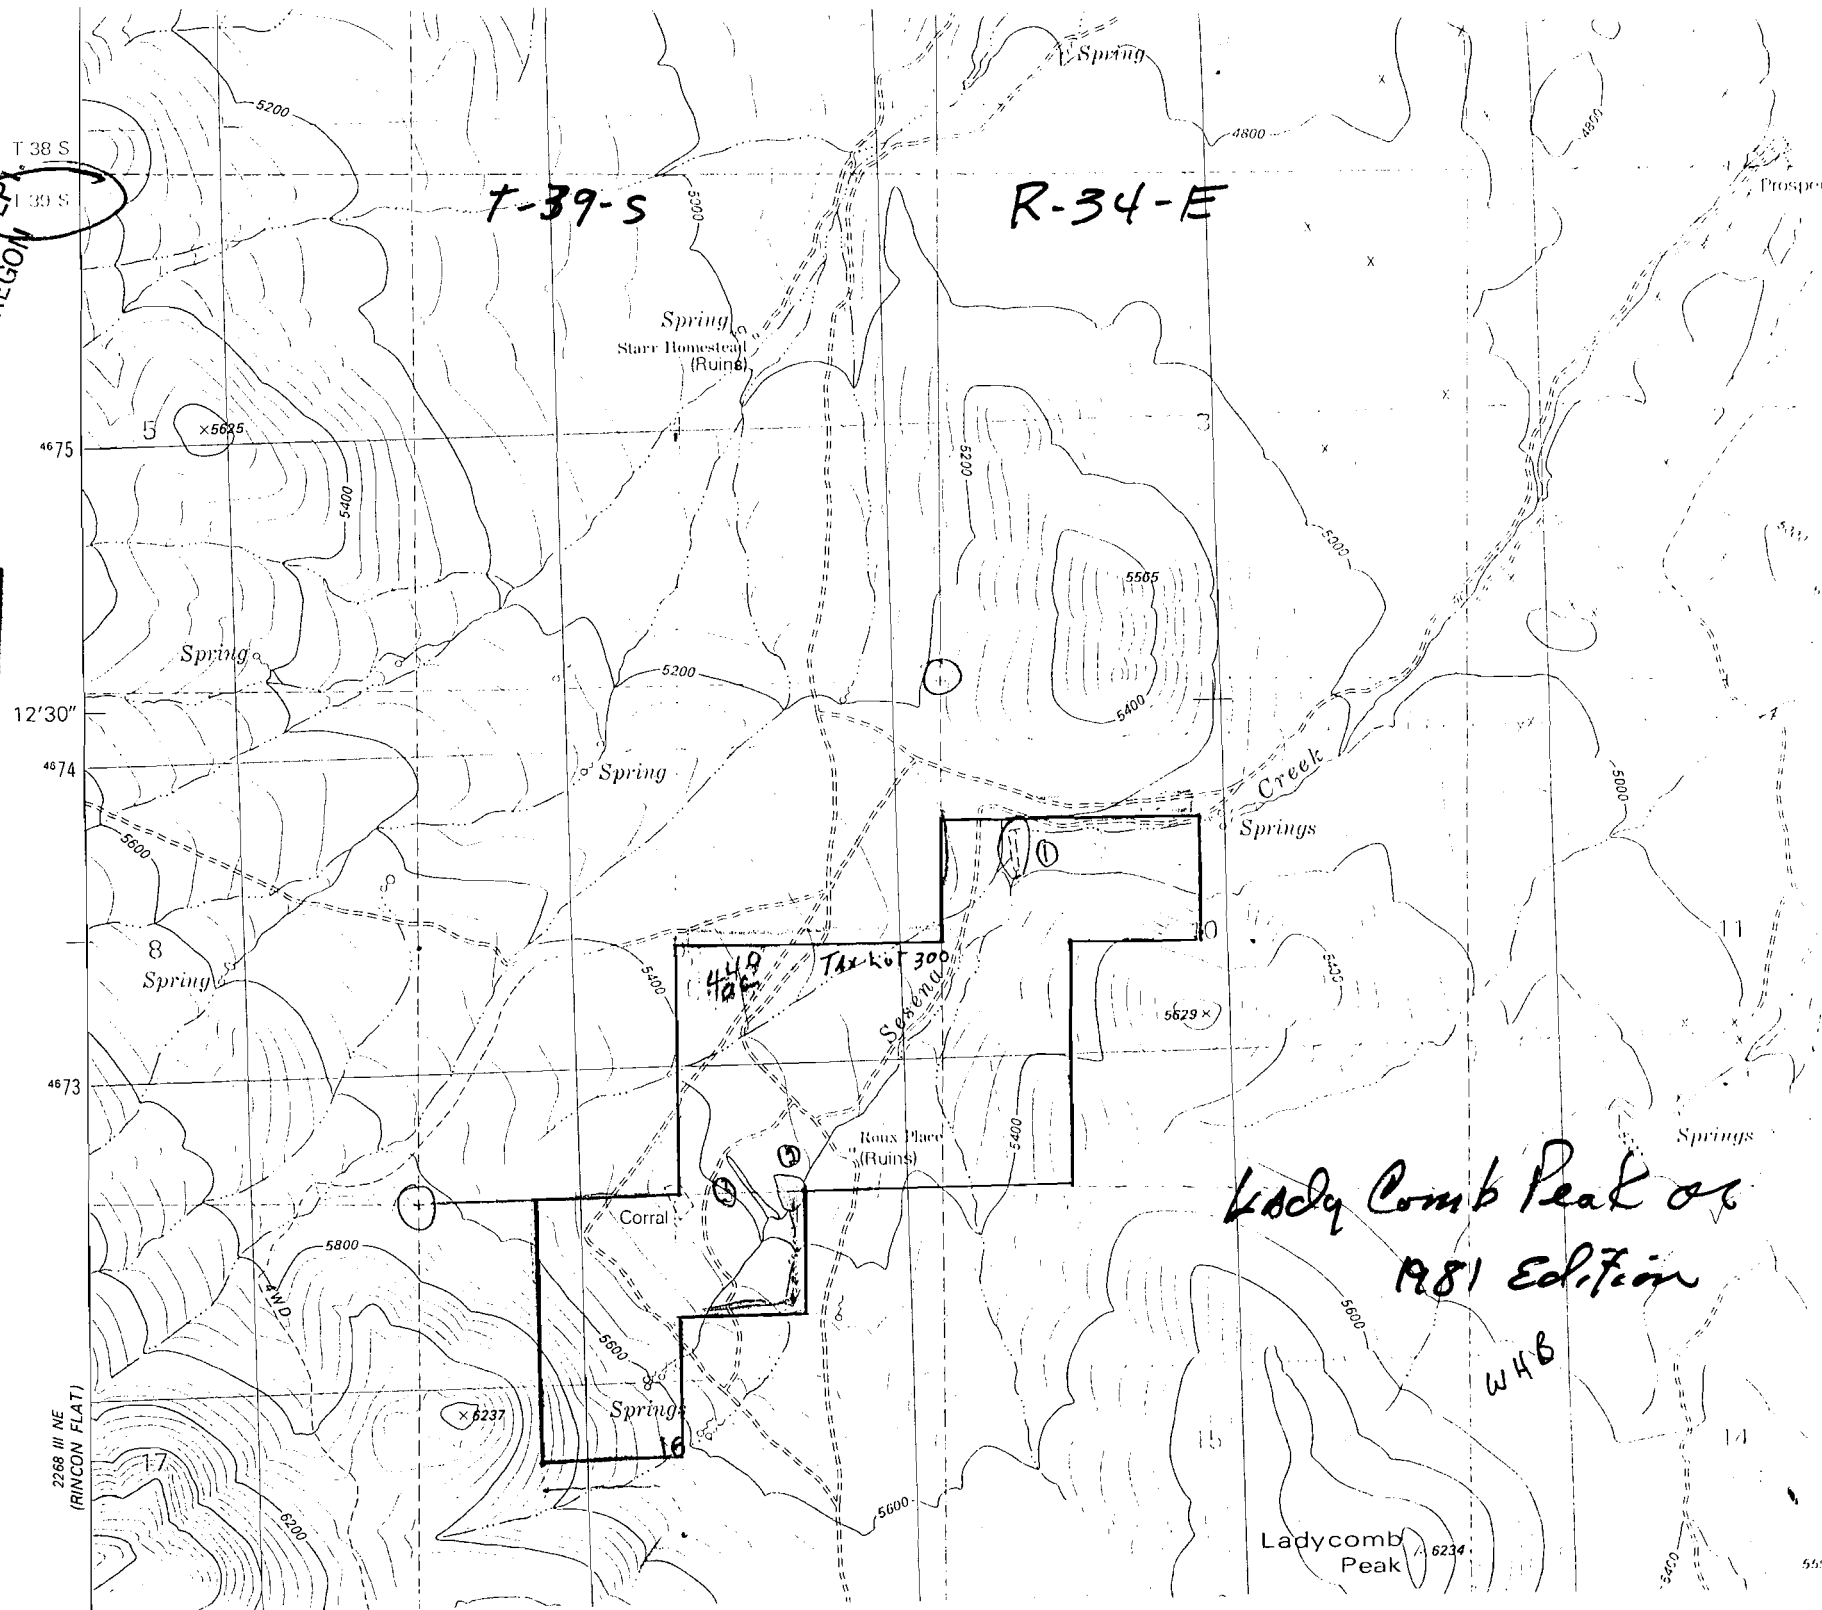

No Final Proof Map available

No Permit Map available