


T 6N R 37E Sec 23

Application No. R-70571
Permit No.

70571


PETERSON RIDGE QUADRANGLE
OREGON
7.5 MINUTE SERIES (TOPOGRAPHIC)

UNITED STATES
DEPARTMENT OF THE INTERIOR
GEOLOGICAL SURVEY

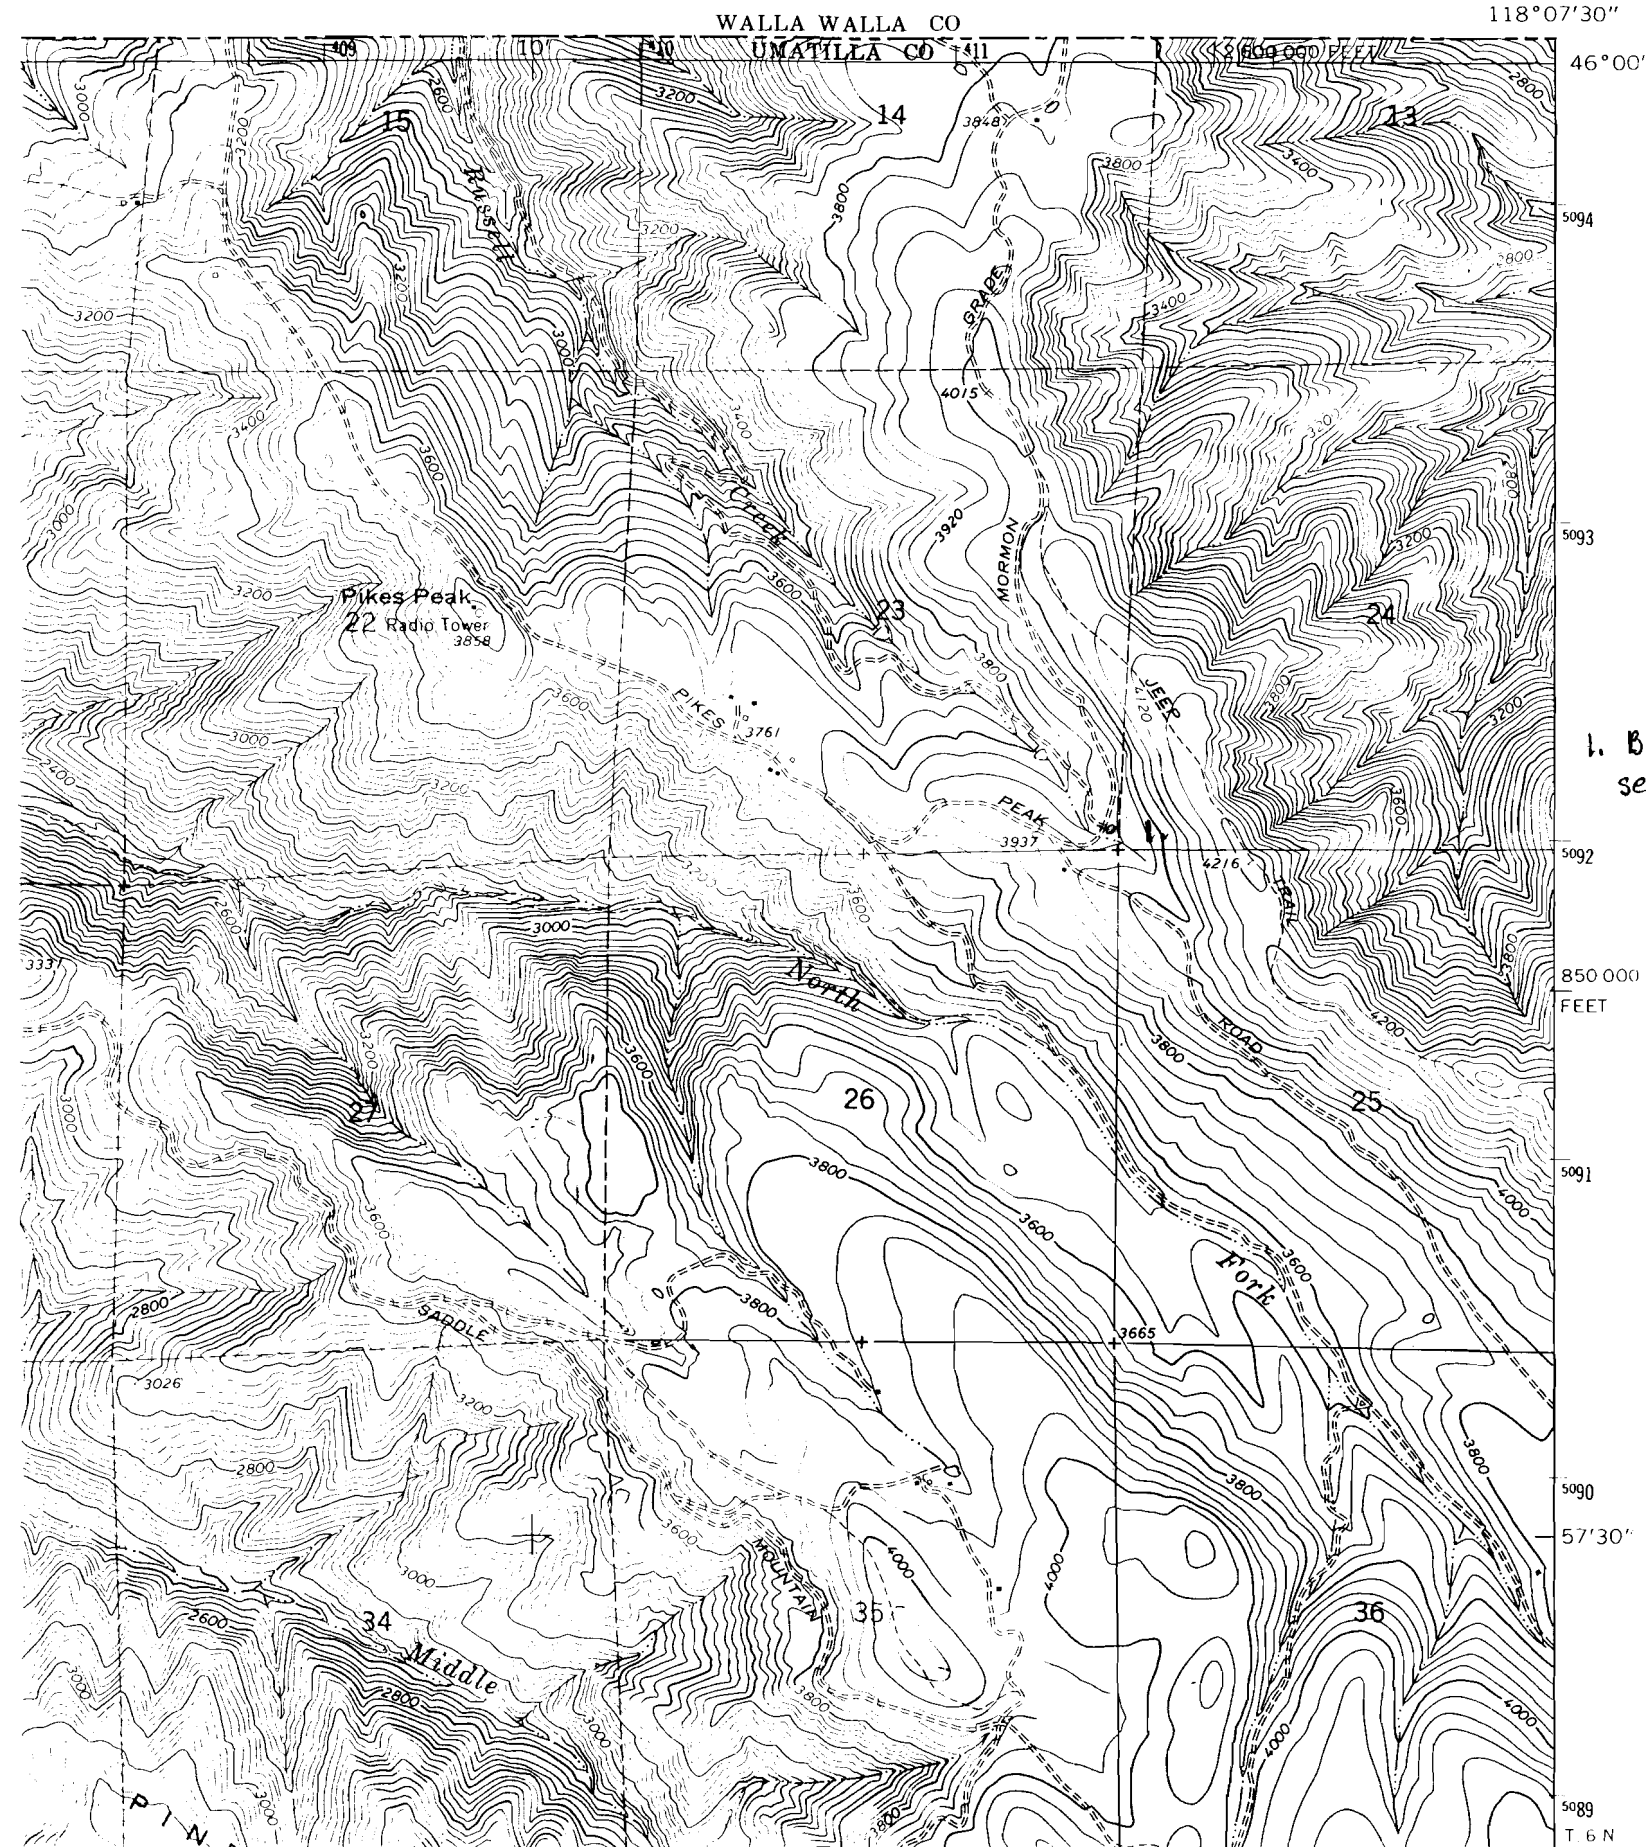

2. Reynolds Berry
Patch Pond
SEC 19 NW 1/4 NE 1/4
Range 38

1. Birdsell Spring Pond
SEC. 23 SE 1/4 SE 1/4

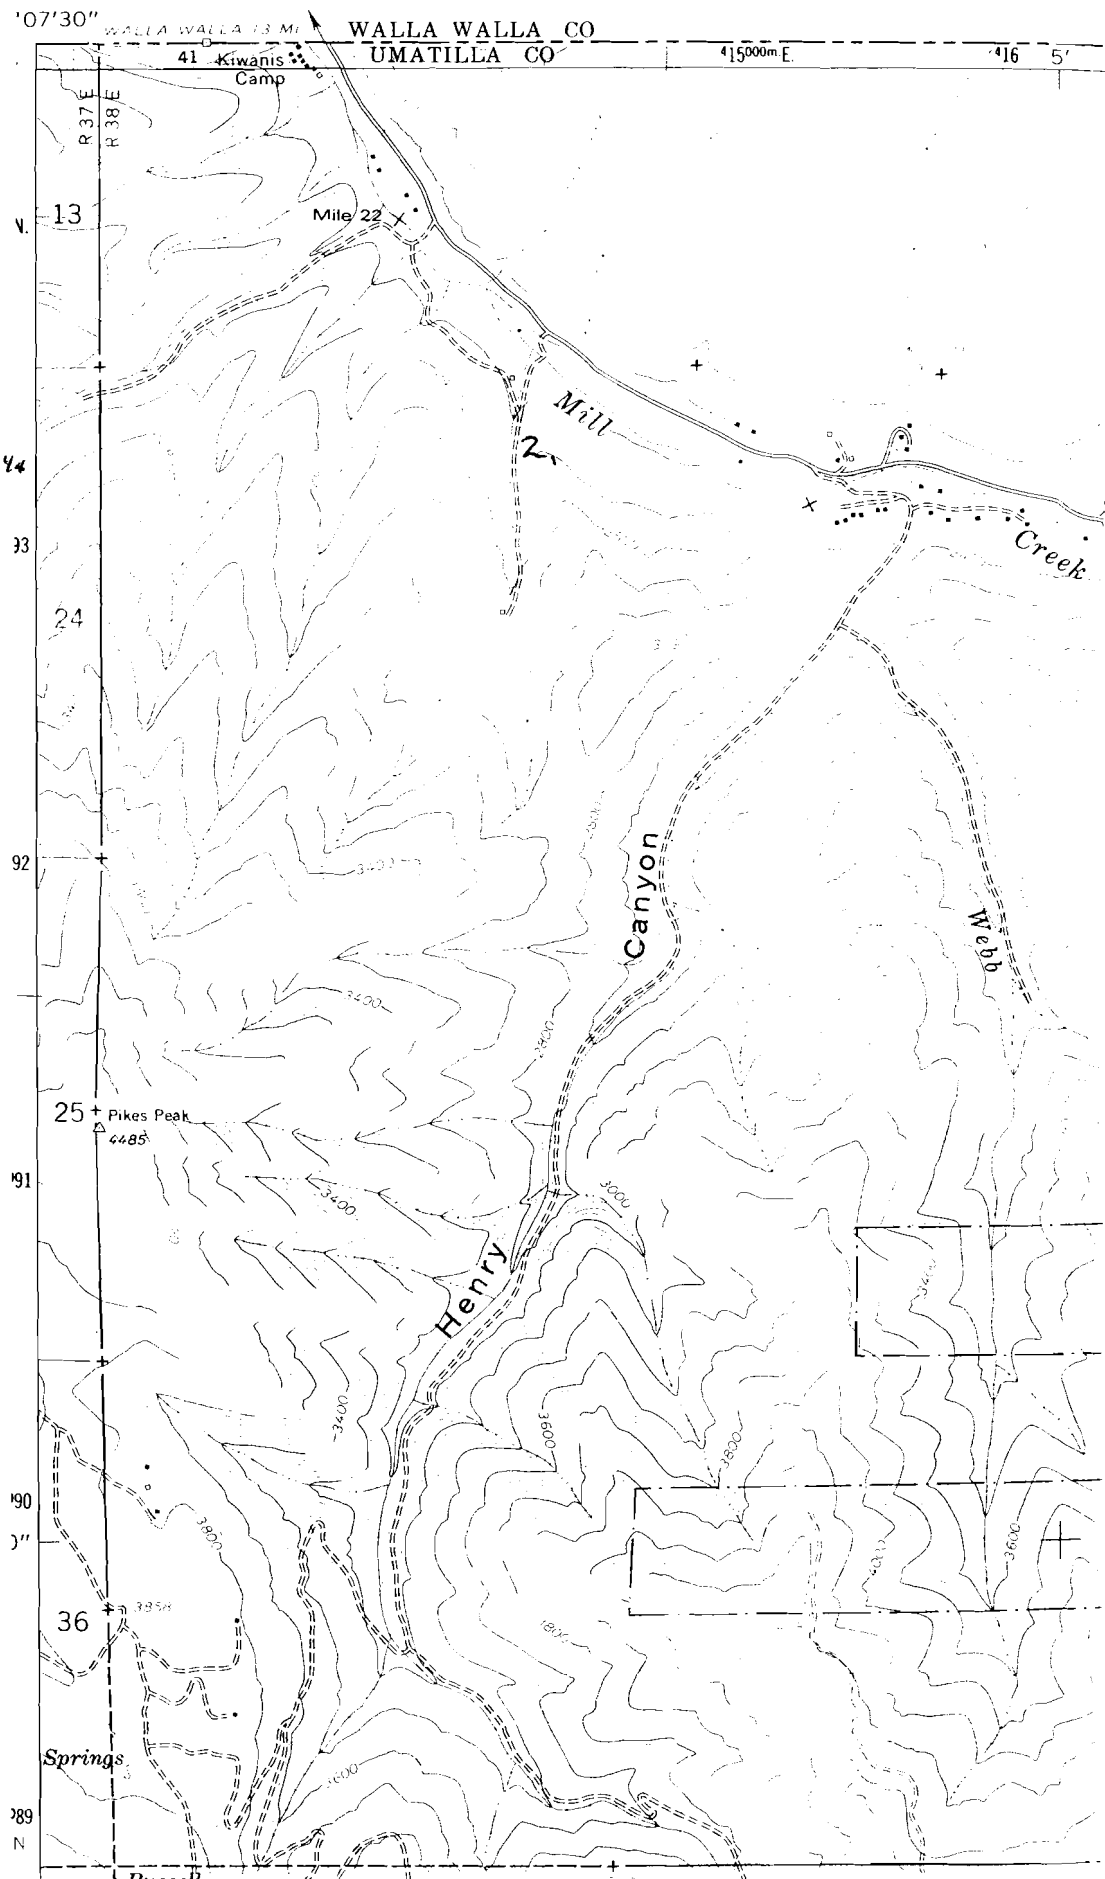

No Final Proof Map available

No Permit Map available