


T6N/R37E/Sec 19

UNITED STATES
DEPARTMENT OF THE INTERIOR
GEOLOGICAL SURVEY

70572

Application No. R-7667
Permit No.

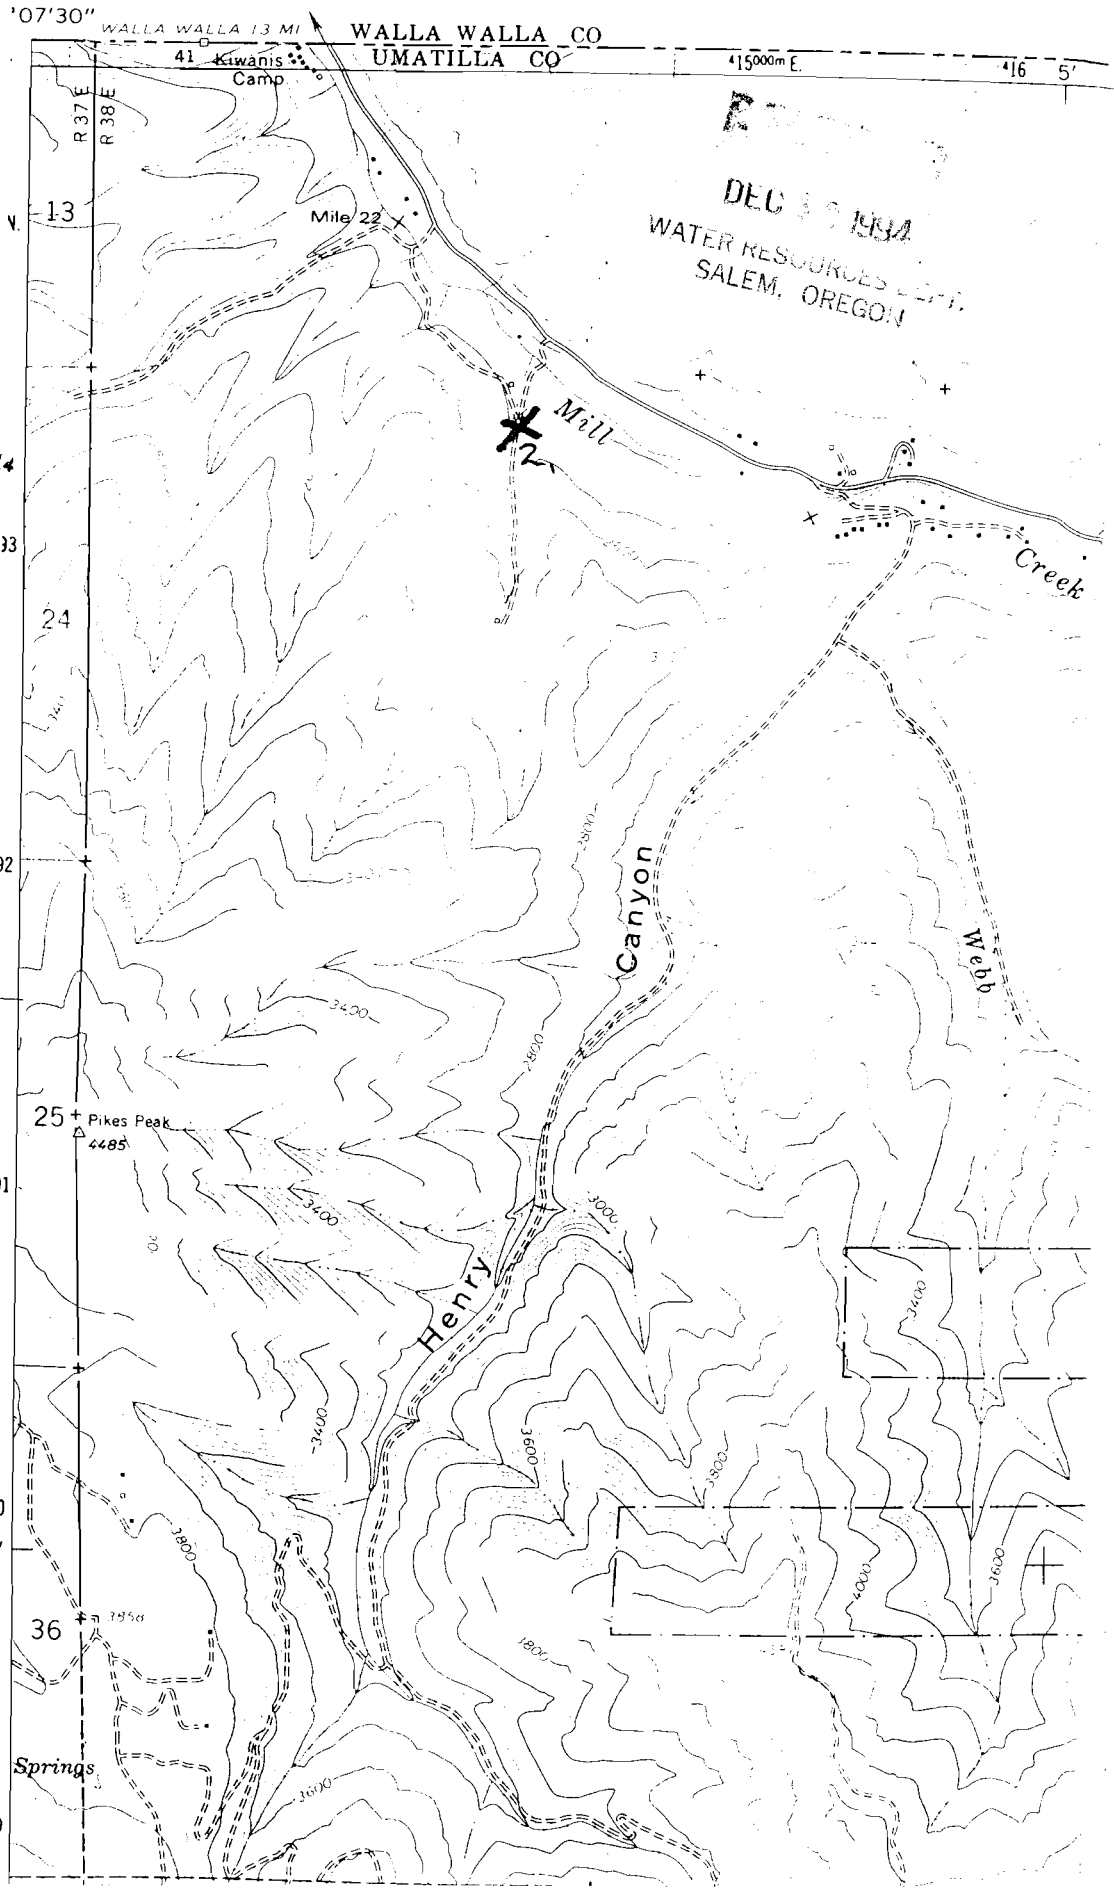

2. Reynolds Berry
Patch Pond
Sec 19 NW 1/4 NE 1/4
Range 38

dsell Spring Pond
. 23 SE 1/4 SE 1/4

No Final Proof Map available

No Permit Map available