

This map was prepared for assessment purpose only.

T.2N. R.46E. W.M. 70574


Application No. R-76647
Permit No.

2N 46

WALLOWA COUNTY

SEE MAP 3N 46

DEC 1994

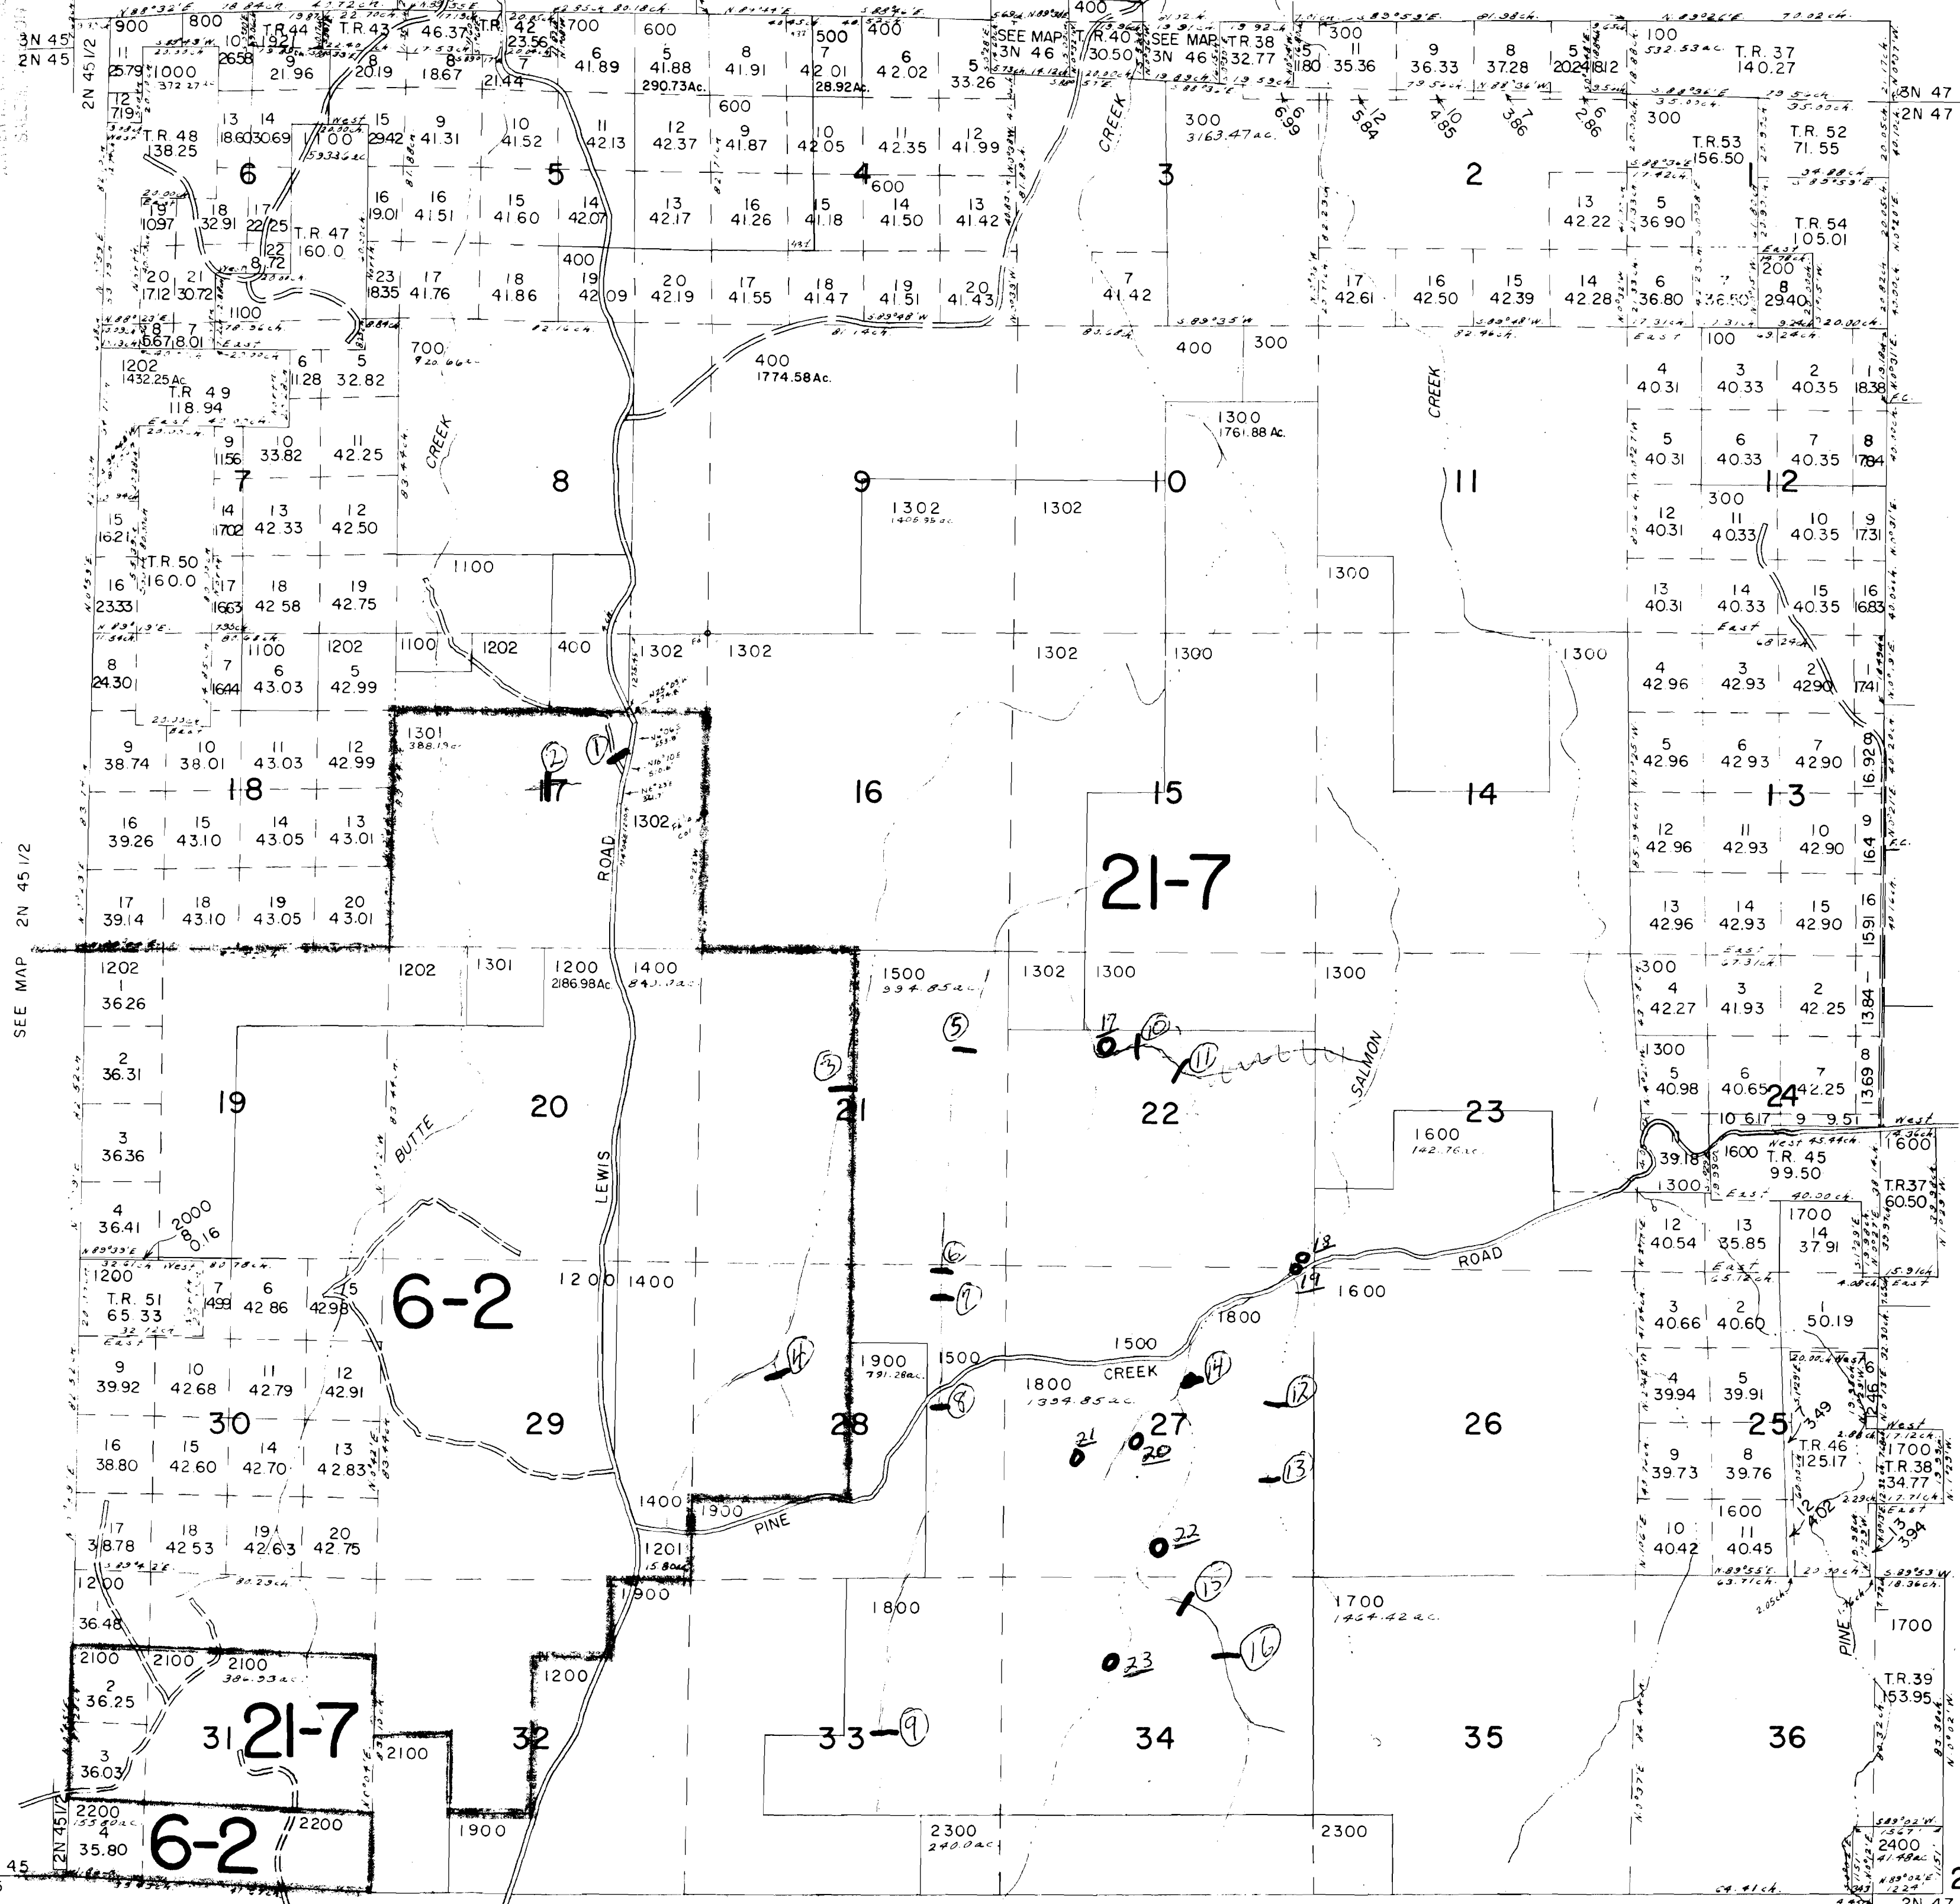

1/2N 45
IN 45

2N 46

No Final Proof Map available

No Permit Map available