

Application No. R-76648  
Permit No.

Mahon Ck, or  
1973  
Edition


R-34-E  
W.H. Beard

710 000  
FEET

DEC 30 1994

WATER RESOURCES DEPT.  
SALEM, OREGON

DATE REVISION NO. 70578

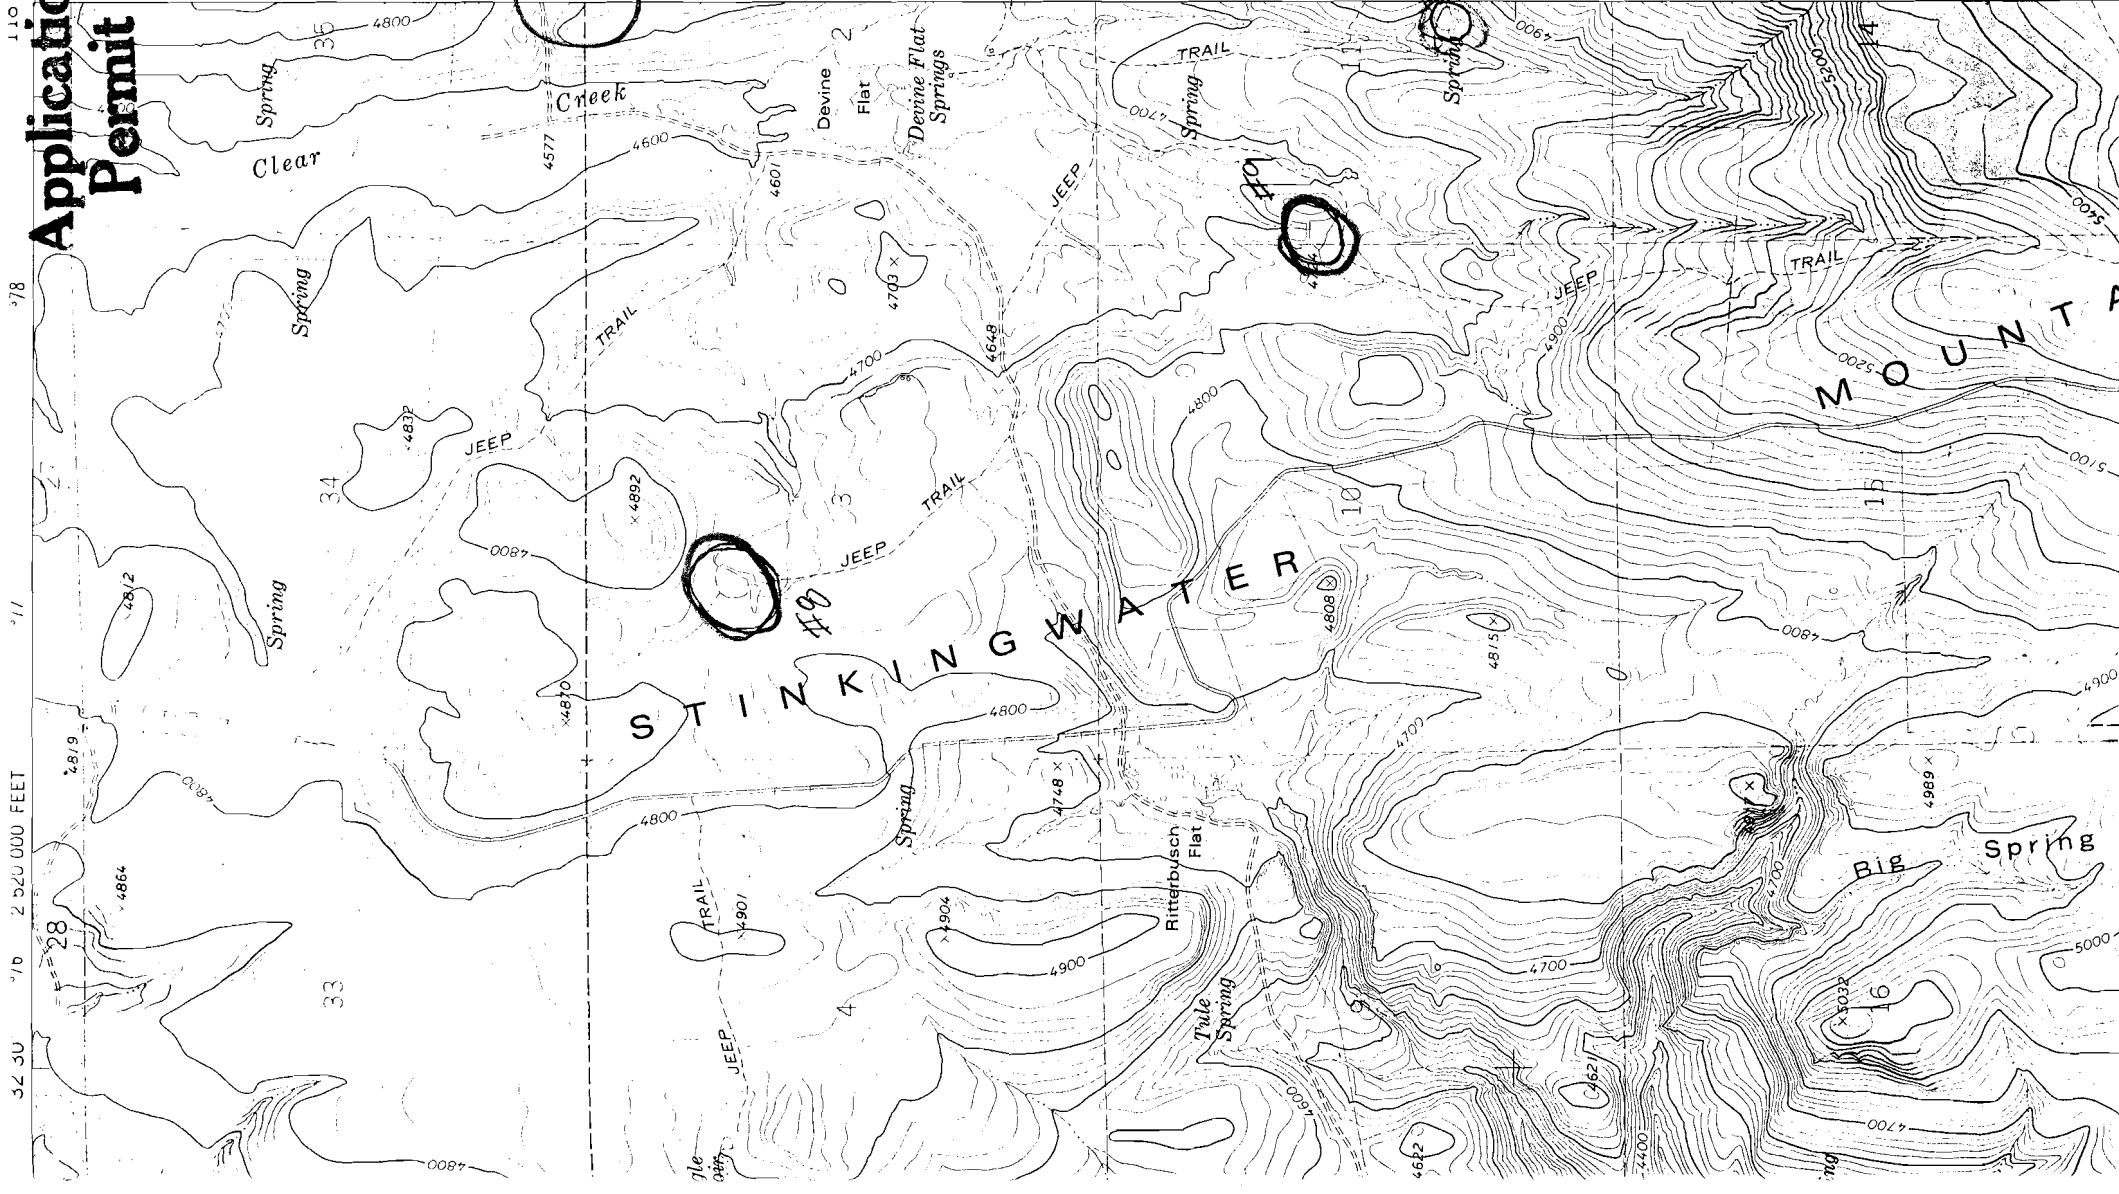

Application No. R-76648  
Permit No.

RECEIVED


DEC 30 1994

WATER RESOURCES DEPT.  
SALEM, OREGON

UNITED STATES  
DEPARTMENT OF THE INTERIOR  
GEOLOGICAL SURVEY



221 (LINE PASS)  
STINKING WATER PASS

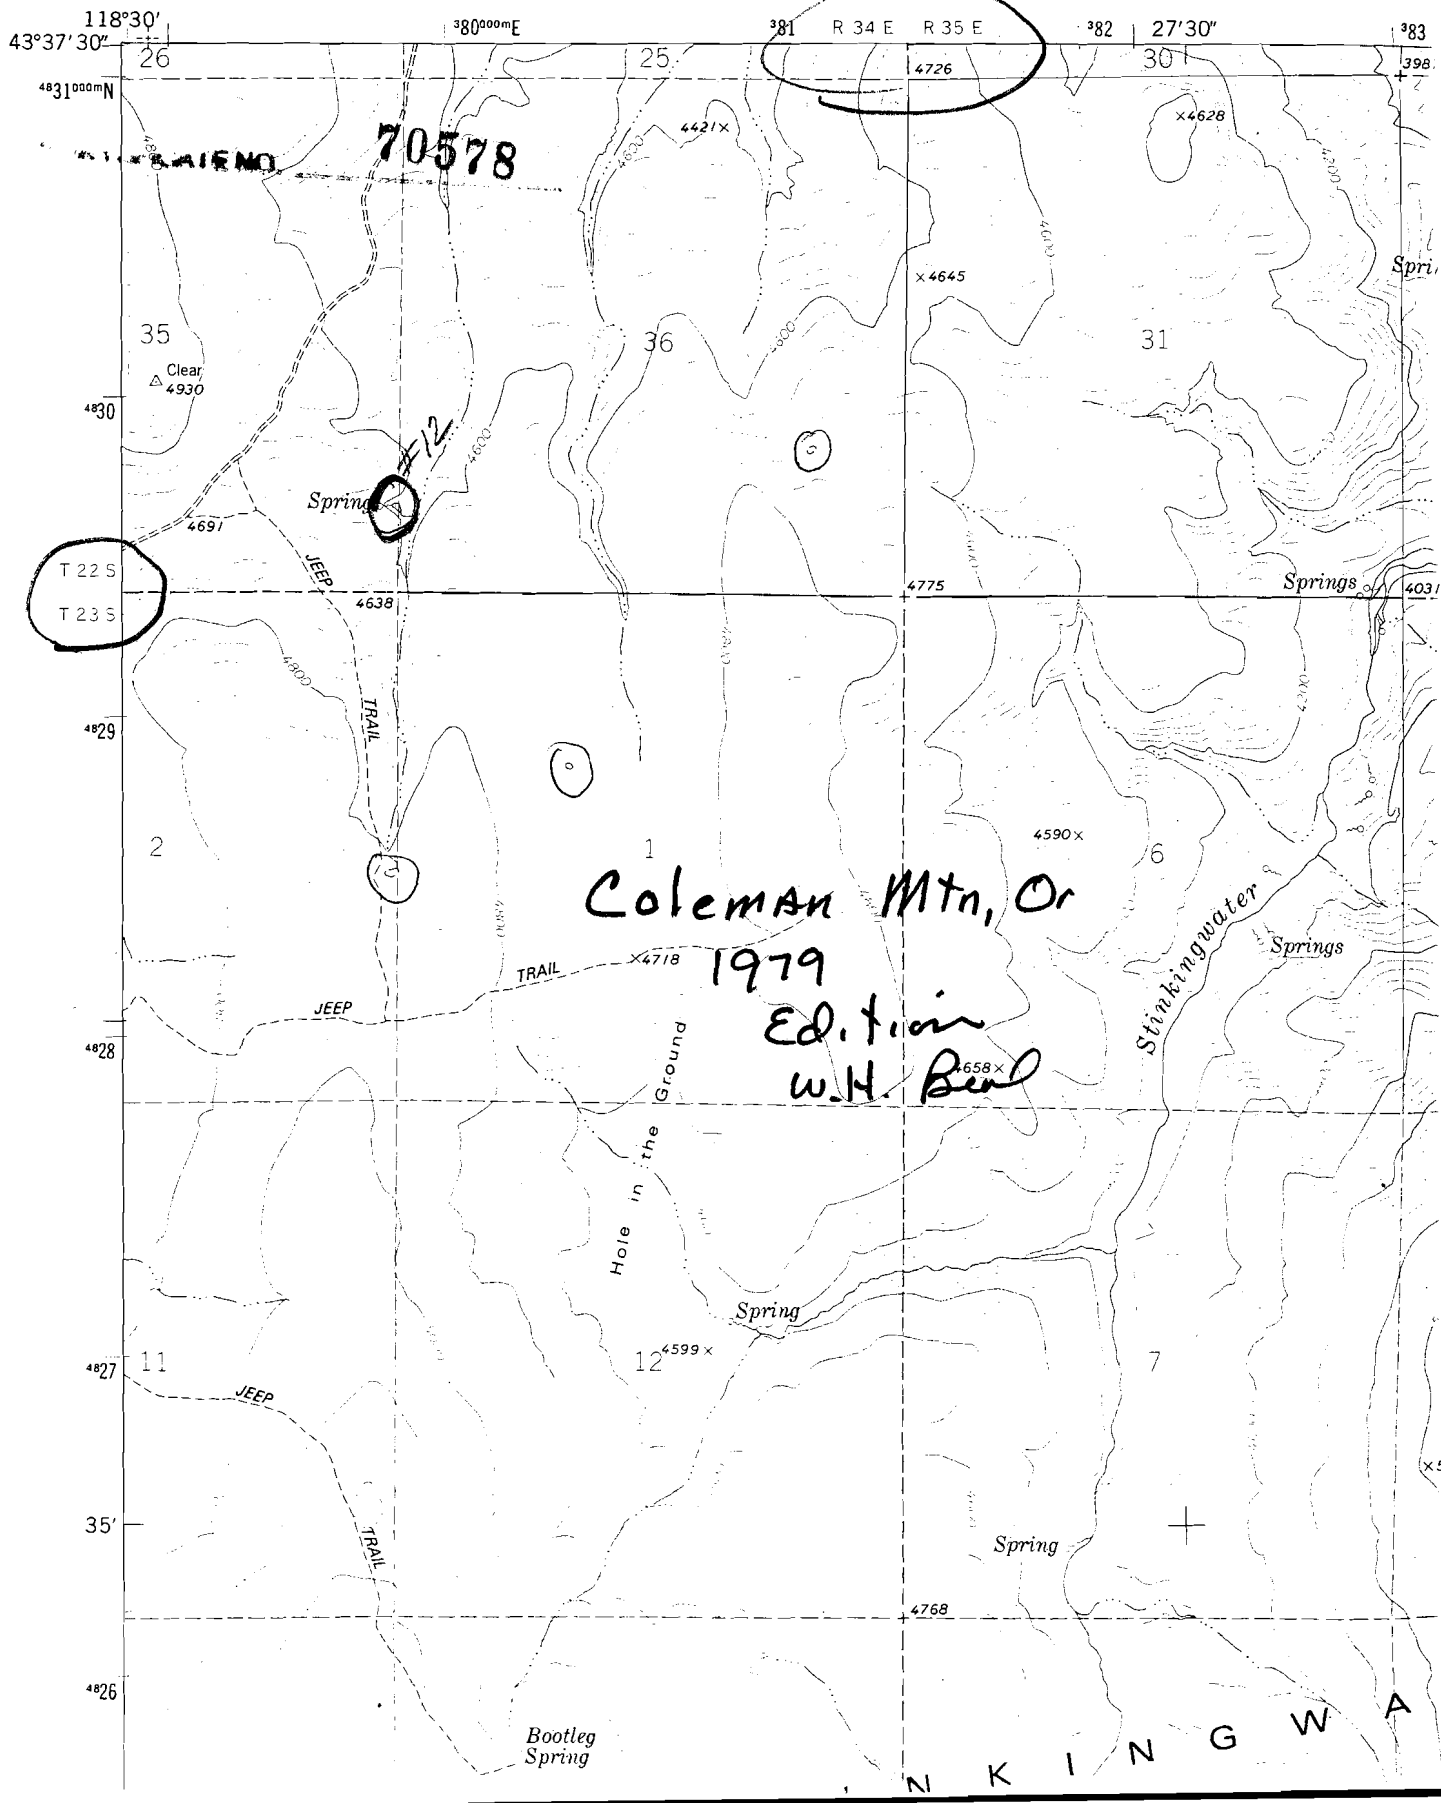


Application No. R-766418  
Permit No.

DEC 30 1994

WATER RESOURCES DEPT  
SALEM, OREGON

70578

Drinking Water Pass or  
1990 Edition  
W+1 Bear

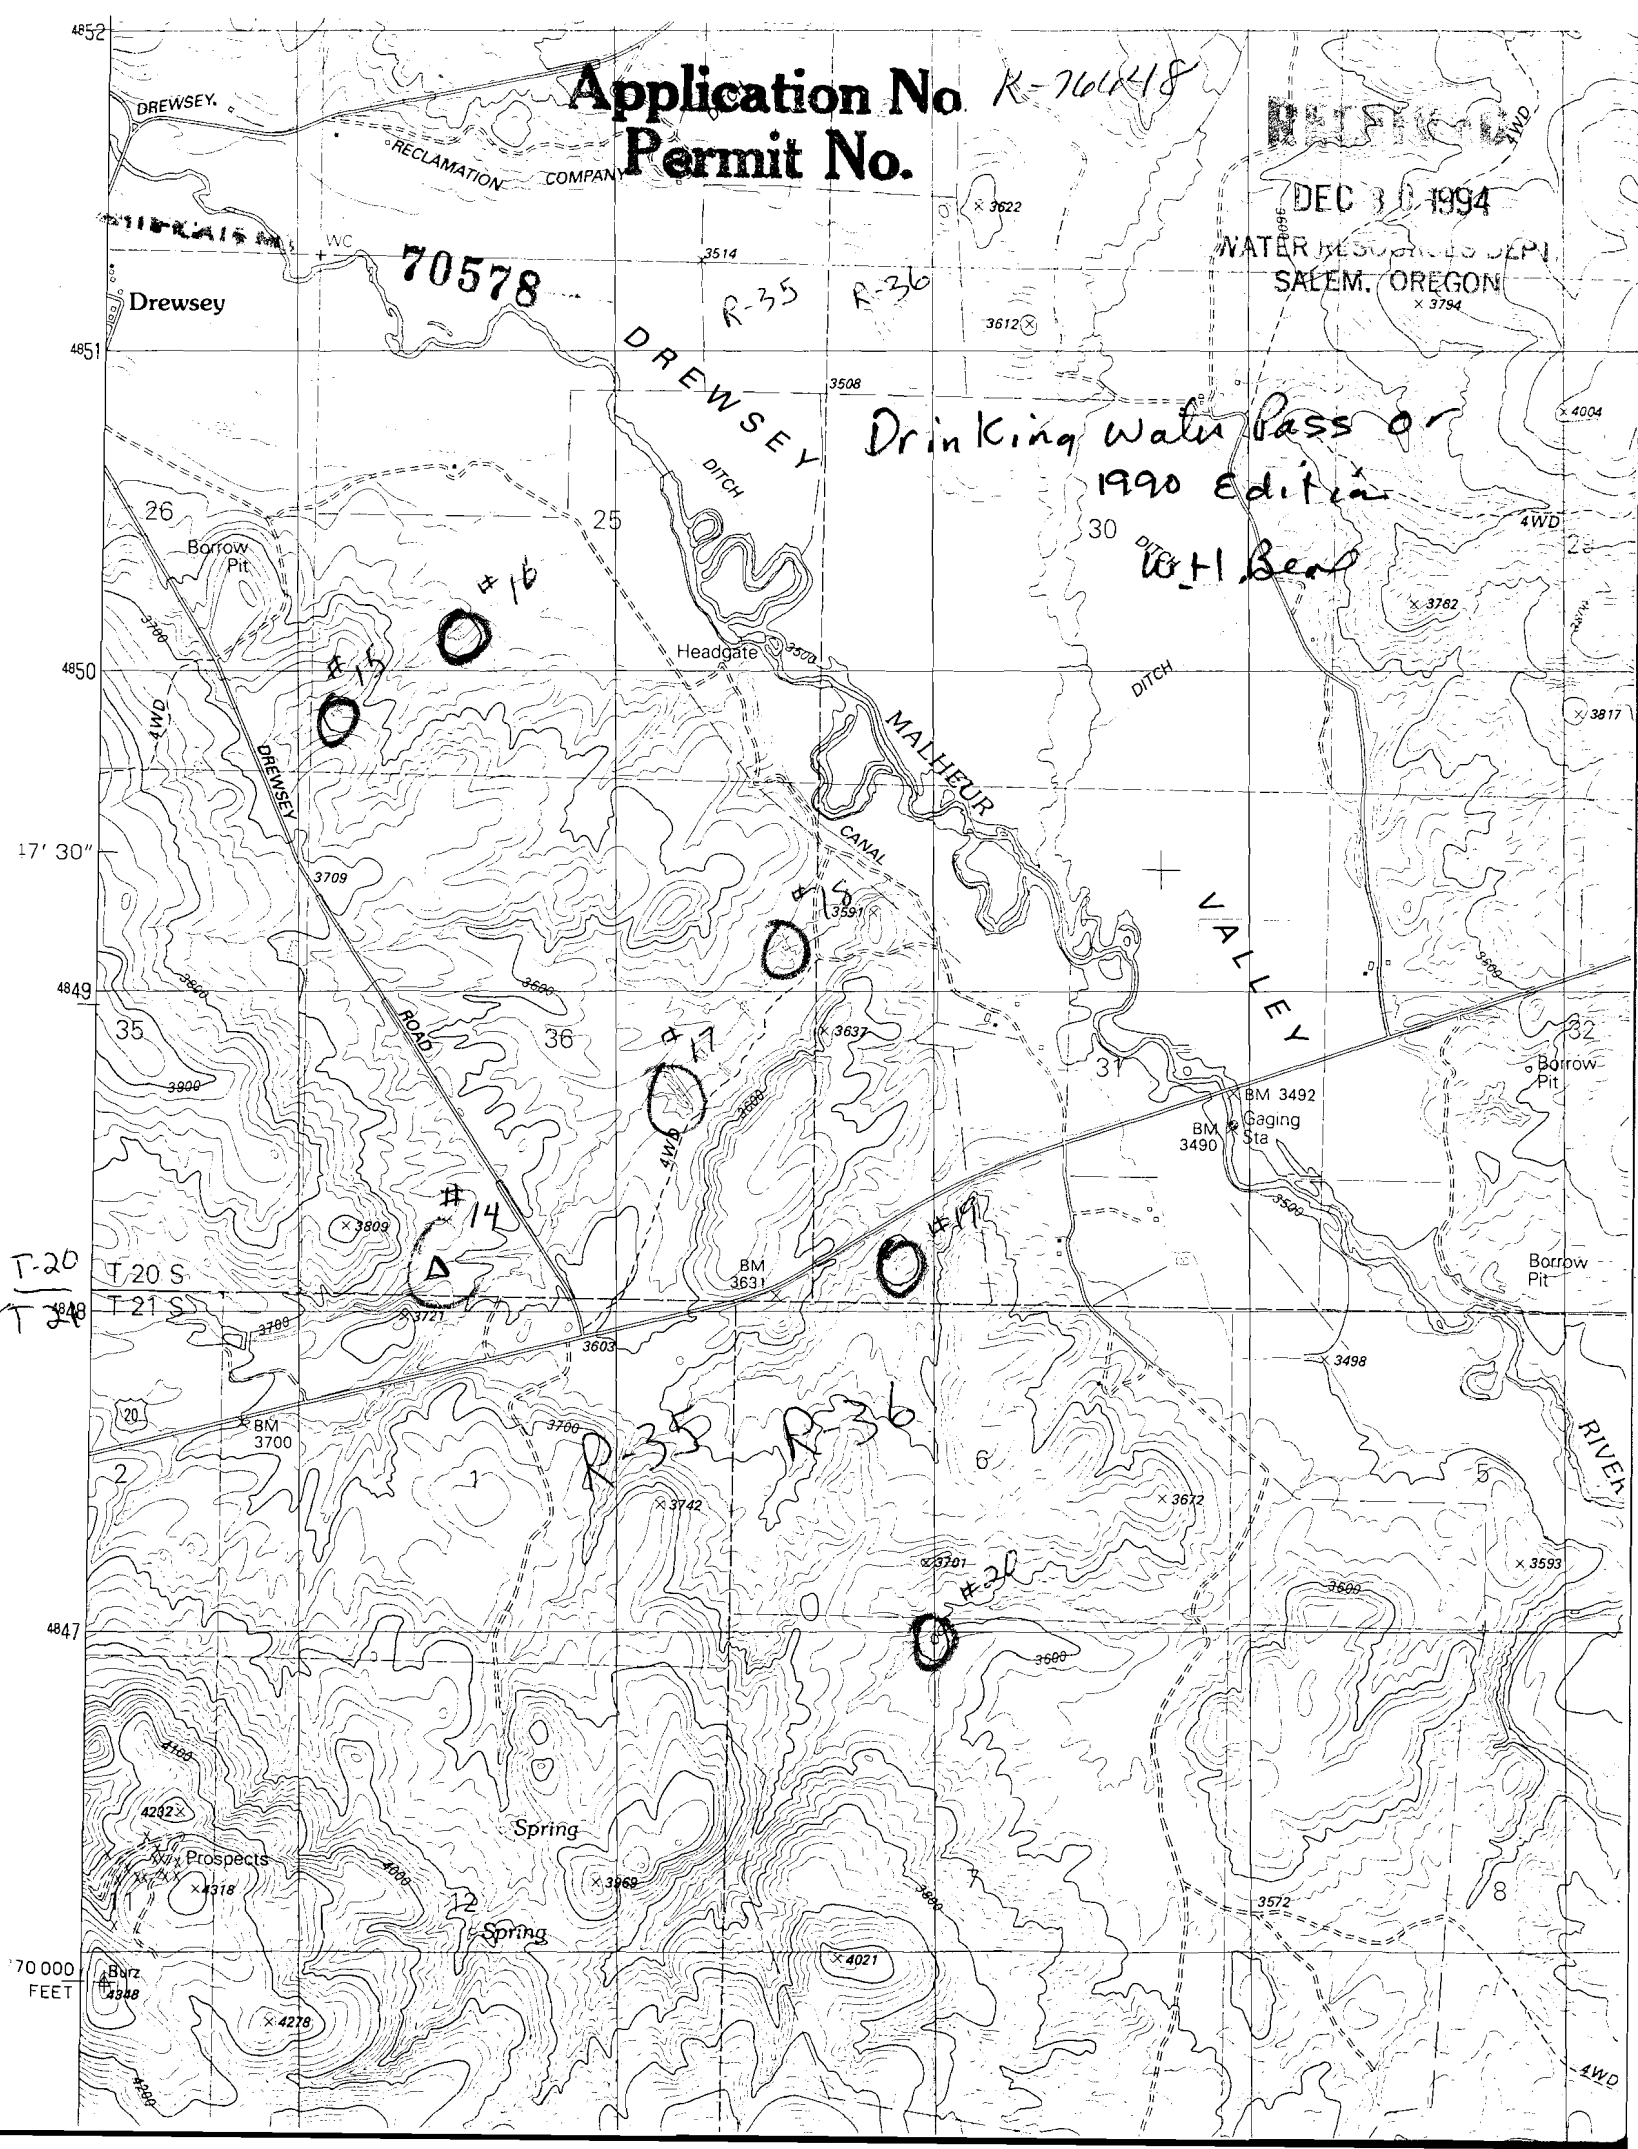

T-20  
T-21

70 000  
FEET

No Final Proof Map available

No Permit Map available