

Application No. 70579

T1882

21.7

NH&L NW
 $\frac{2}{41.3}$

$\frac{1}{17.0}$

9.8

$\frac{4}{5.5}$

NH&L

$\frac{6}{18.8}$

22.5

T1886

$\frac{3}{10.9}$

NH&L NW

$\frac{3}{13.7}$

T1889

NH&L

$\frac{3}{38.2}$

$\frac{4}{5.5}$

T1890

70579

$\frac{15}{26.9}$

$\frac{13}{20.2}$

$\frac{14}{22.1}$

T2761

$\frac{2}{5.0}$

$\frac{5}{10.1}$

$\frac{7}{10.2}$

$\frac{1}{10.0}$

$\frac{2}{5.0}$

$\frac{8}{8.5}$

$\frac{1}{1.6}$


$\frac{2}{3.9}$

$\frac{1}{1.1}$

$\frac{2}{7}$

T2634


$\frac{6}{21}$

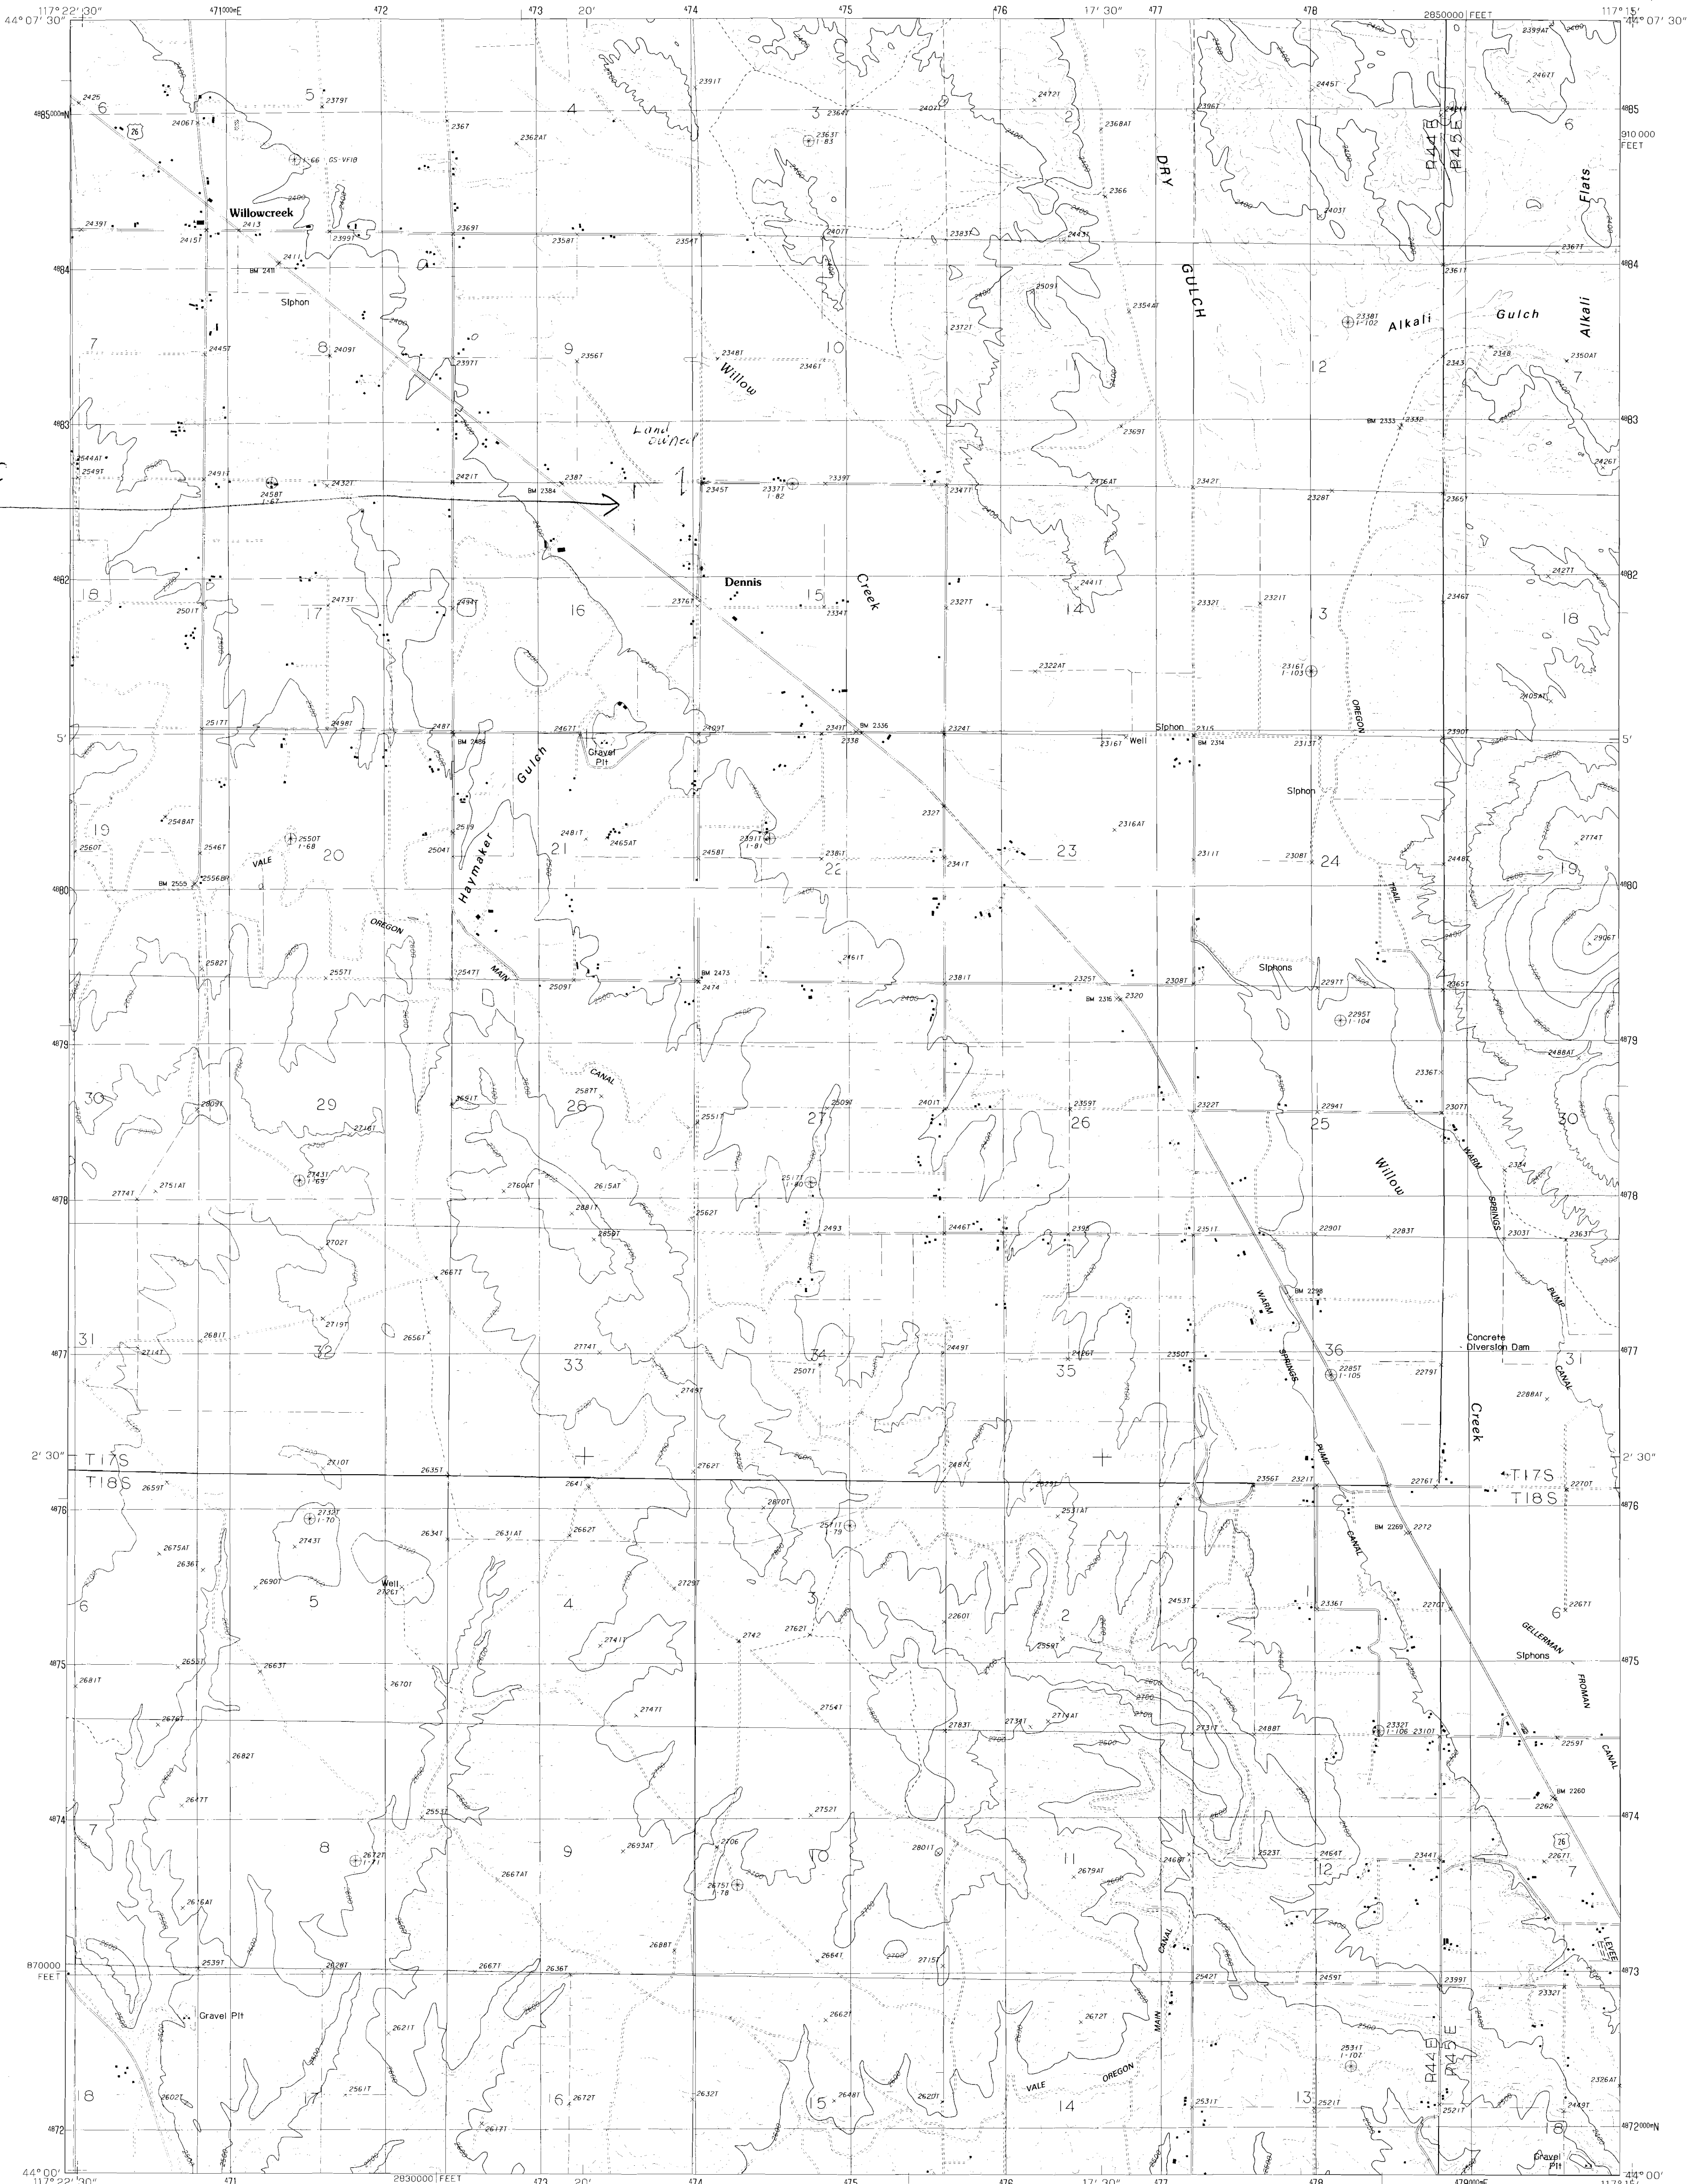

Location of Reservoir

PRODUCED BY THE UNITED STATES GEOLOGICAL SURVEY
CONTROL BY USGS AND NOS/NOKIA
COMPILED FROM AERIAL PHOTOGRAPHS TAKEN 1984
FIELD CHECKED 1985. MAP EDITED 1988
PROJECTION LAMBERT CONFORMAL CONIC
GRID 1000-METER UNIVERSAL TRANSVERSE MERCATOR ZONE 11
10,000-FOOT STATE GRID TICKS OREGON SOUTH ZONE
UTM GRID DECLINATION 013° WEST
1988 MAGNETIC NORTH DECLINATION 1700° EAST
VERTICAL DATUM NATIONAL GEODETIC VERTICAL DATUM OF 1929
HORIZONTAL DATUM 1927 NORTH AMERICAN DATUM
To place on the predicted North American Datum of 1983,
move the projection lines as shown by dashed corner ticks
(16 meters north and 79 meters east)
There may be private inholdings within the boundaries of any
Federal or State reservations shown on this map
No distinction made between houses, barns, and other buildings

PROVISIONAL MAP
Produced from original
manuscript drawings. Infor-
mation shown as of date of
photography.

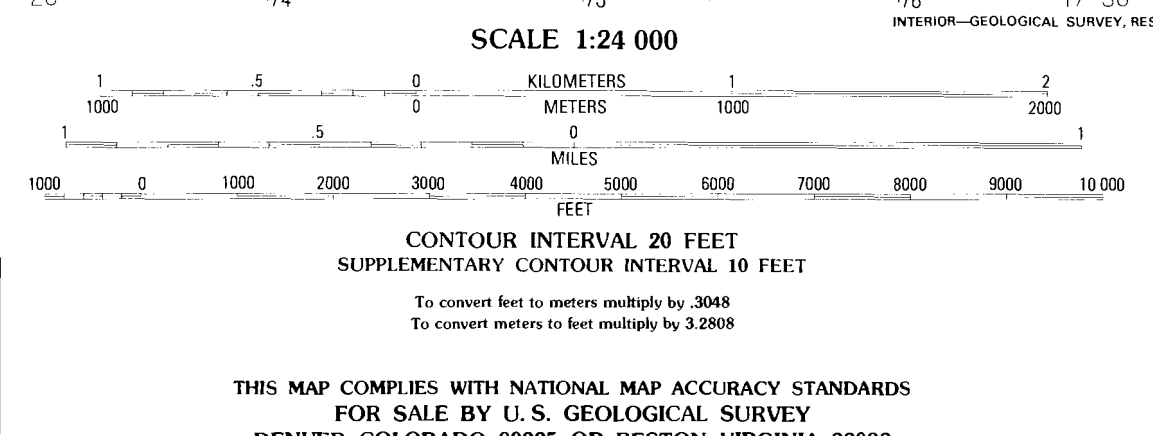

ROAD LEGEND

Improved Road
Unimproved Road
Trail

Interstate Route U.S. Route State Route

QUADRANGLE LOCATION

1	2	3	1 Jamieson
2	3	4	2 McCarthy Ridge
3	4	5	3 Tub Mountain
4	5	6	4 Hope Butte
5	6	7	5 Henry Gulch
6	7	8	6 Vines Hill
7	8		7 Vale West
8			8 Vale East

ADJOINING 7.5 QUADRANGLE NAMES

WILLOWCREEK, OREGON
PROVISIONAL EDITION 1988
44117-A3-TF-024

No Final Proof Map available

No Permit Map available