


Application No.  
Permit No.

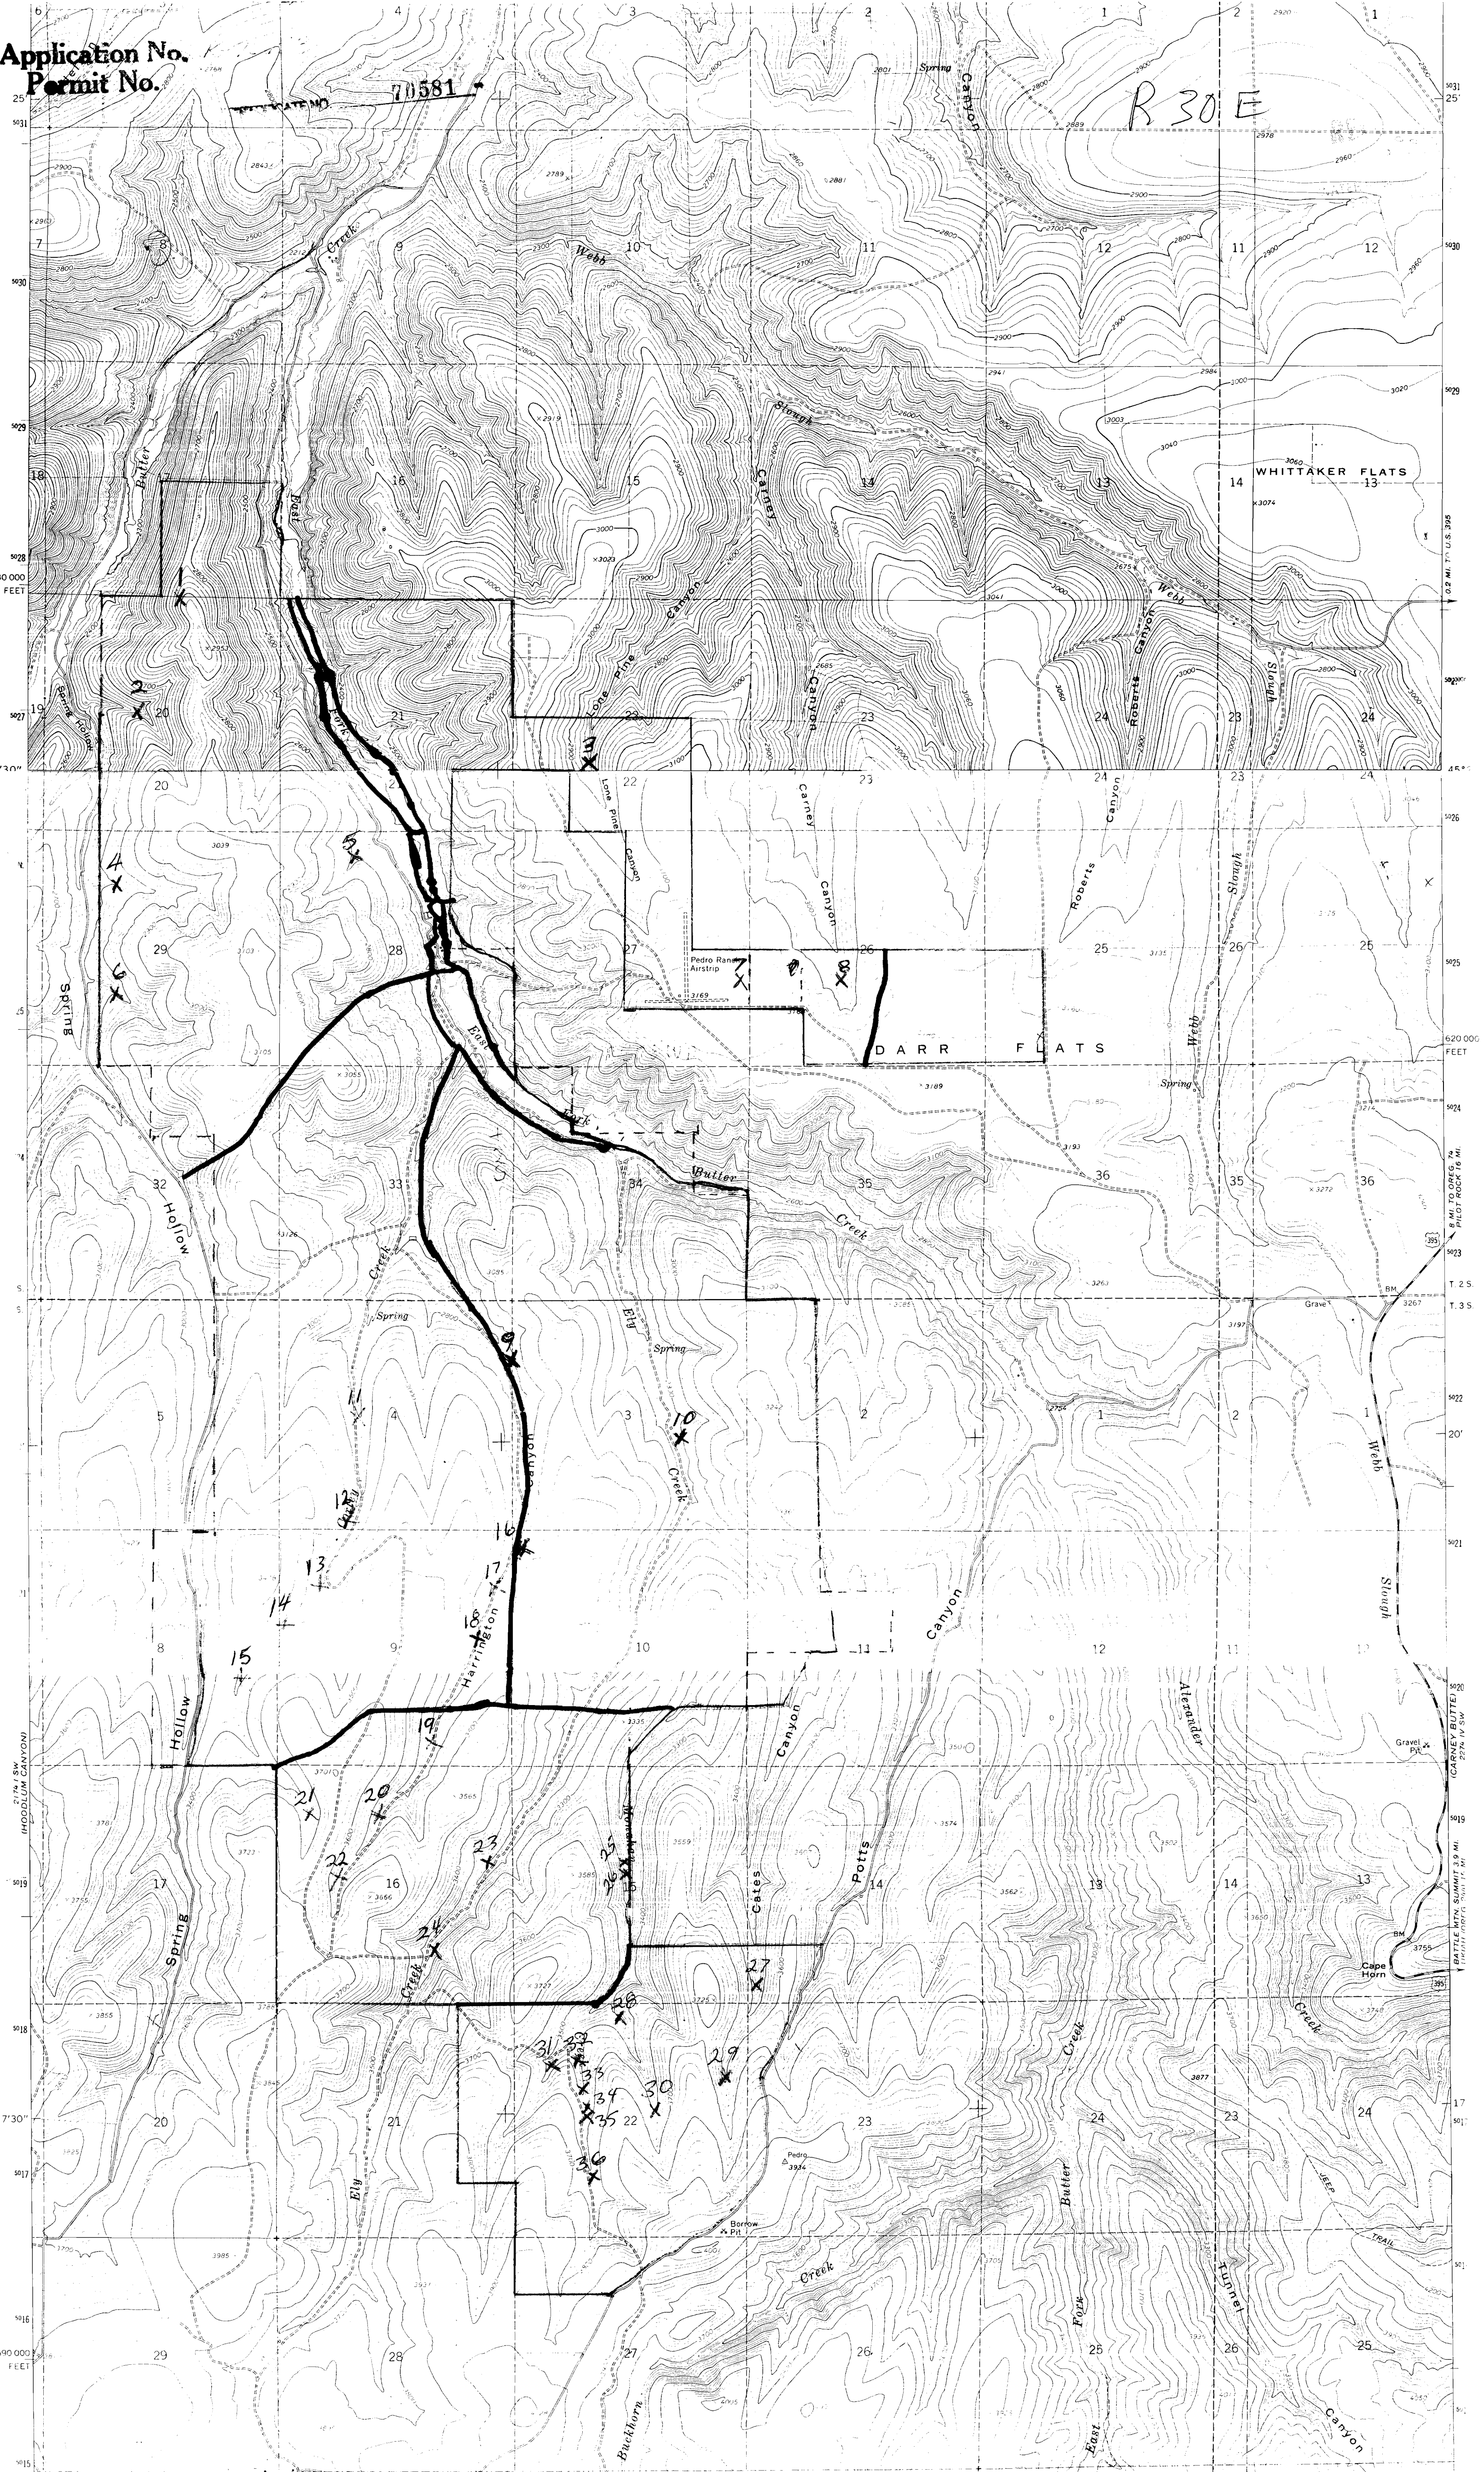

No Final Proof Map available

No Permit Map available