


Application No.
Permit No.

2754 ~~CONFIDENTIAL~~ NO. 70582

T 35
R 30 E

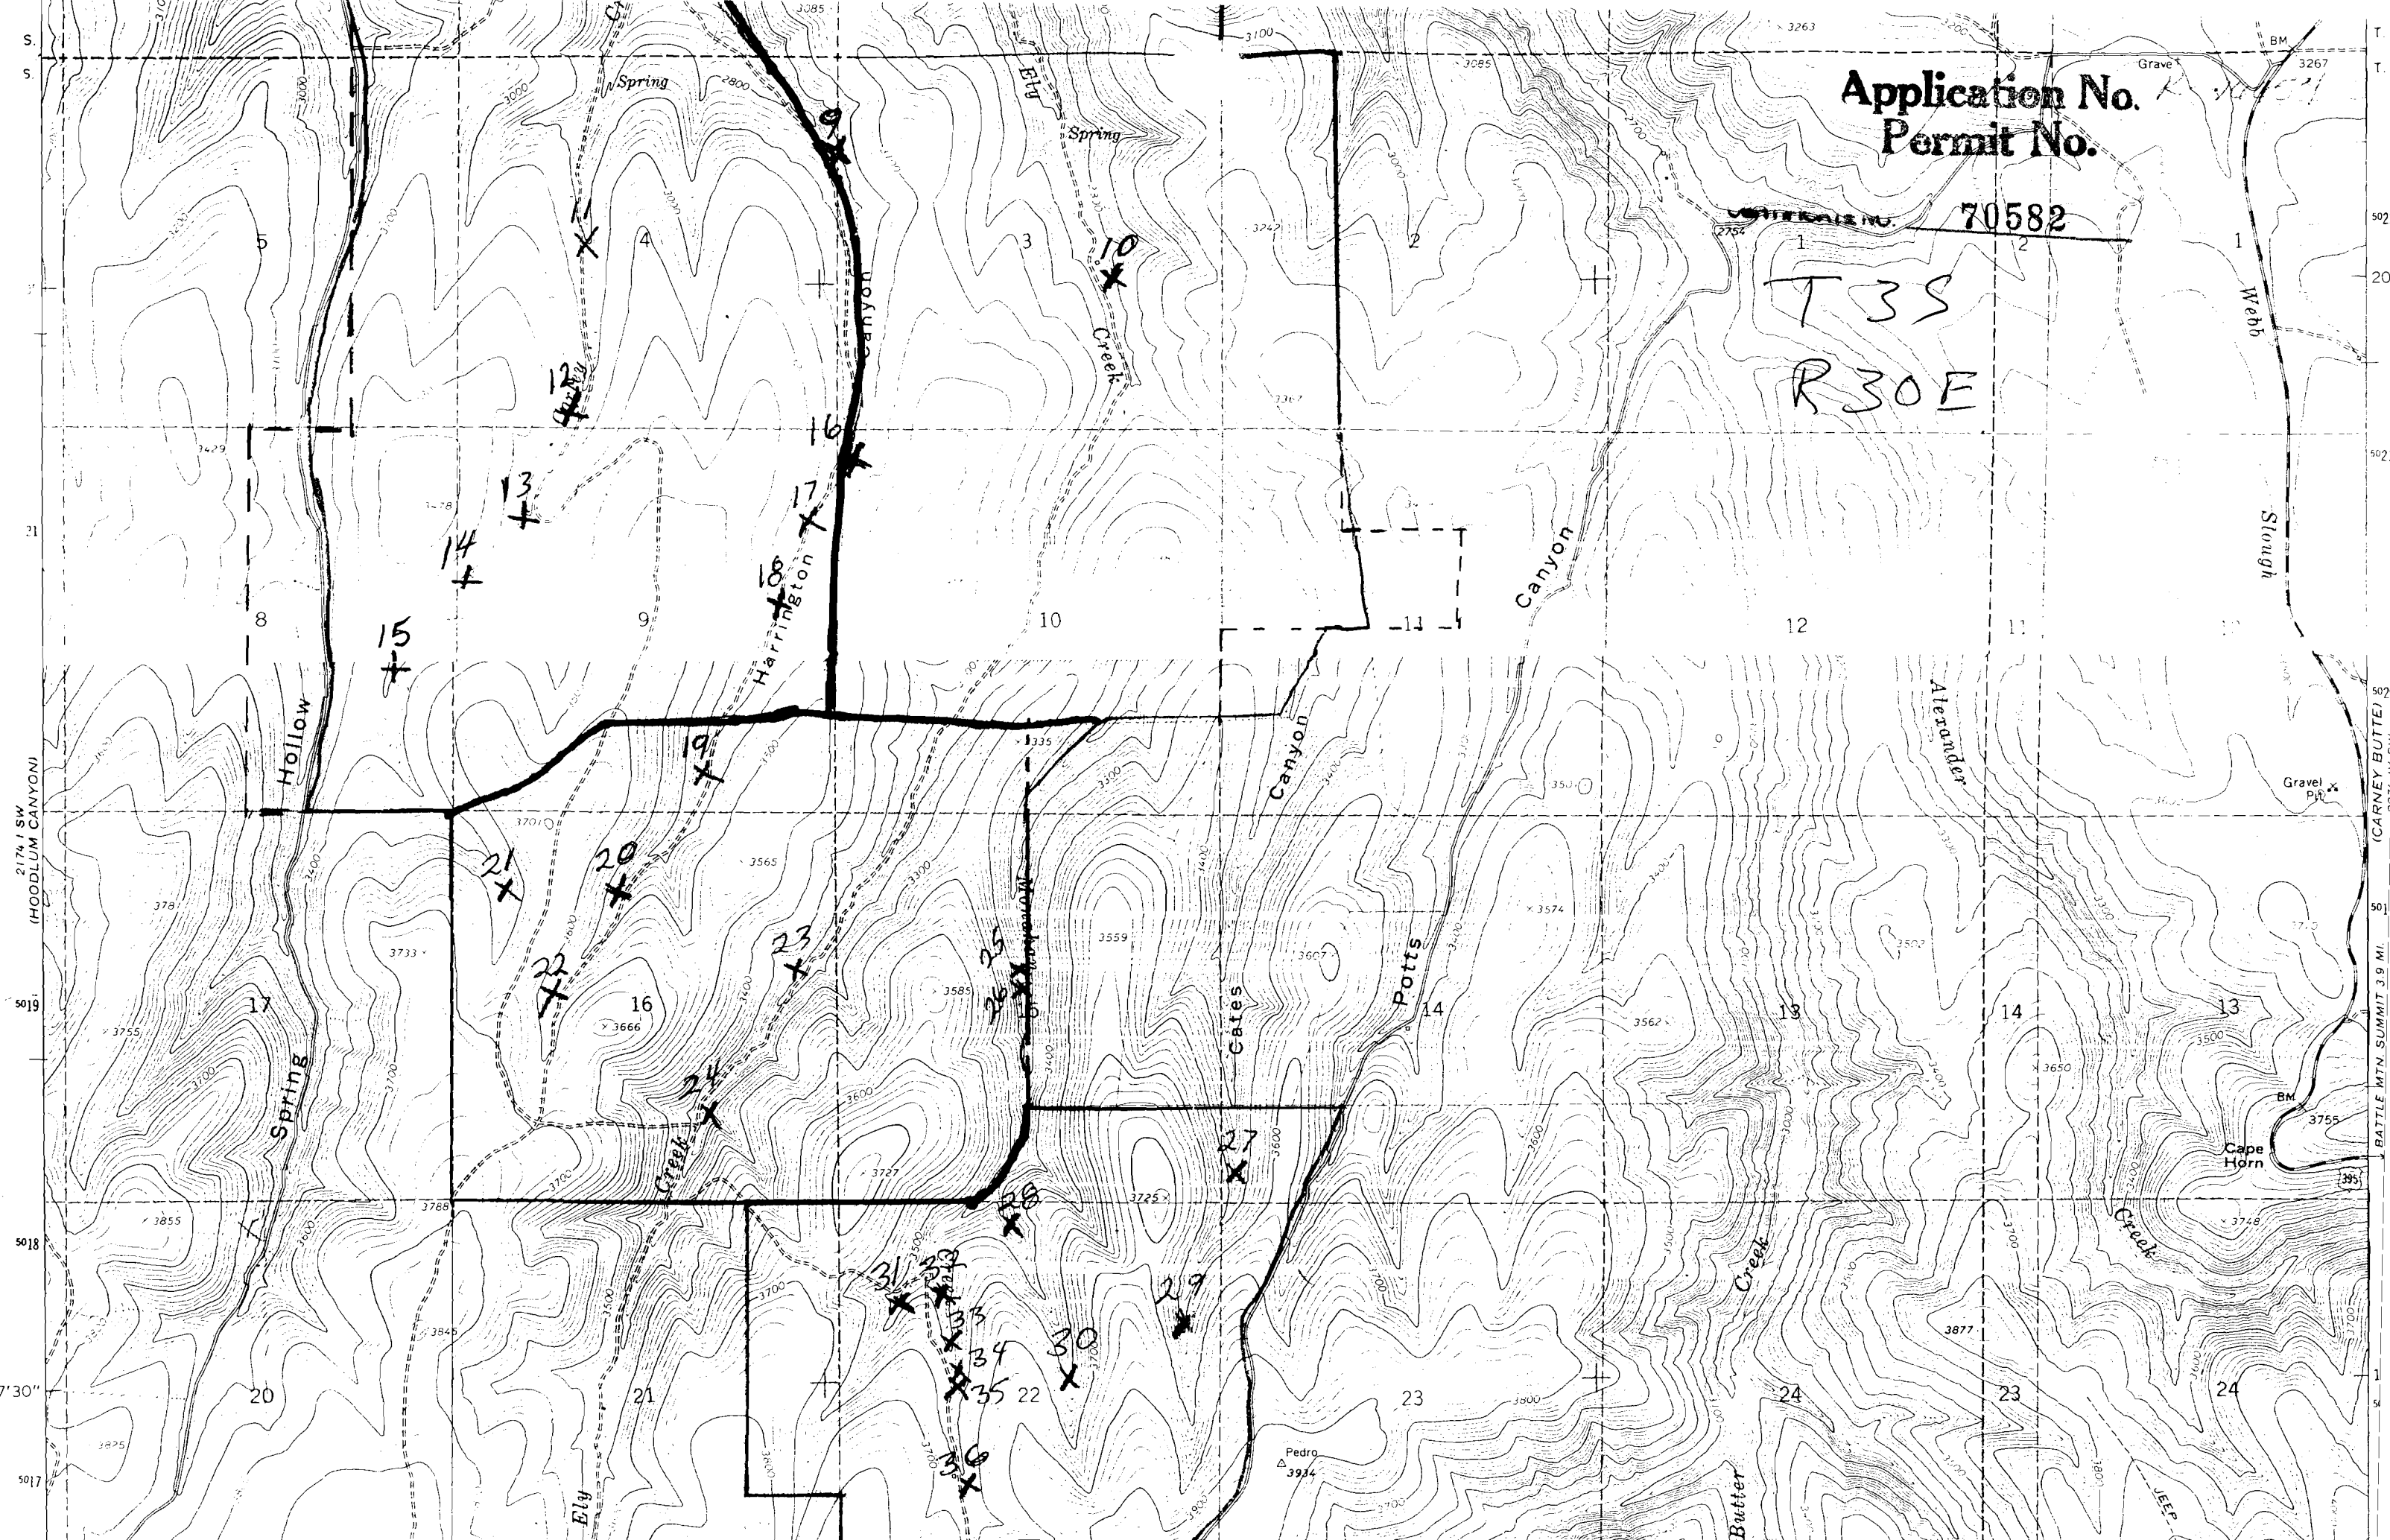

No Final Proof Map available

No Permit Map available