


Application No. 70583
Permit No.

33
R 30 E

70583

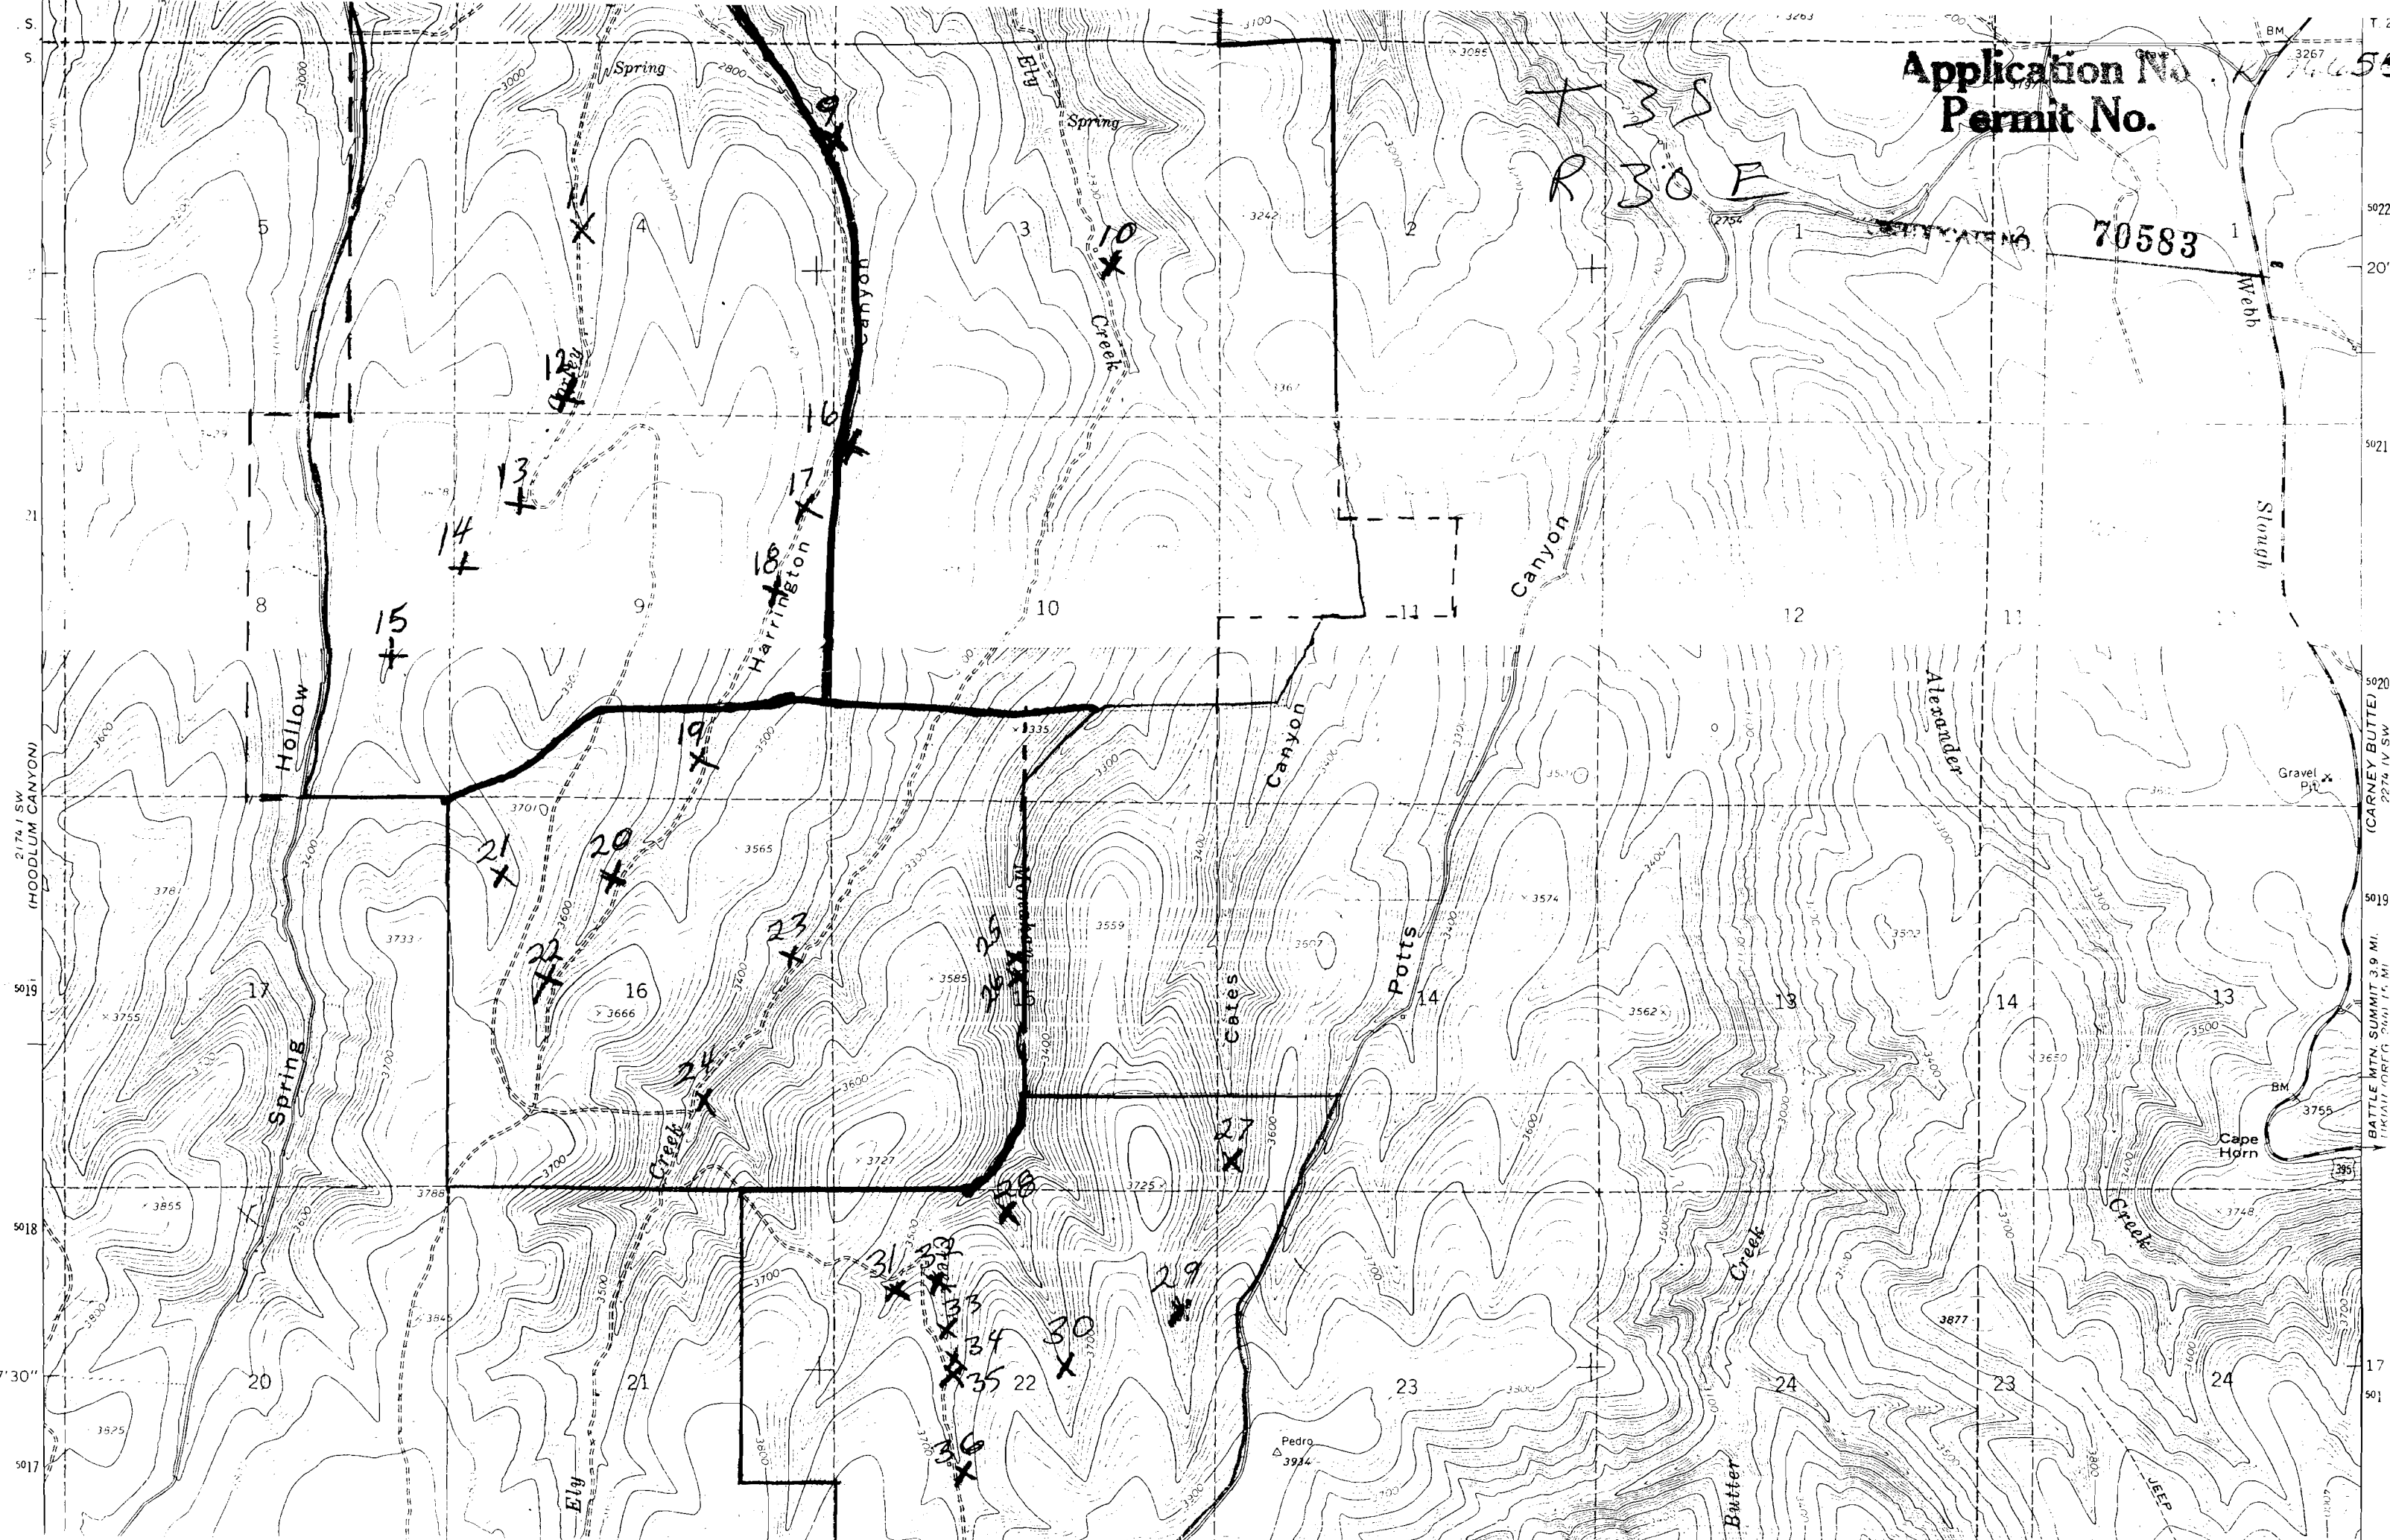

No Final Proof Map available

No Permit Map available