


Application No. ~~70584~~
Permit No.

70584

T3S
R30E

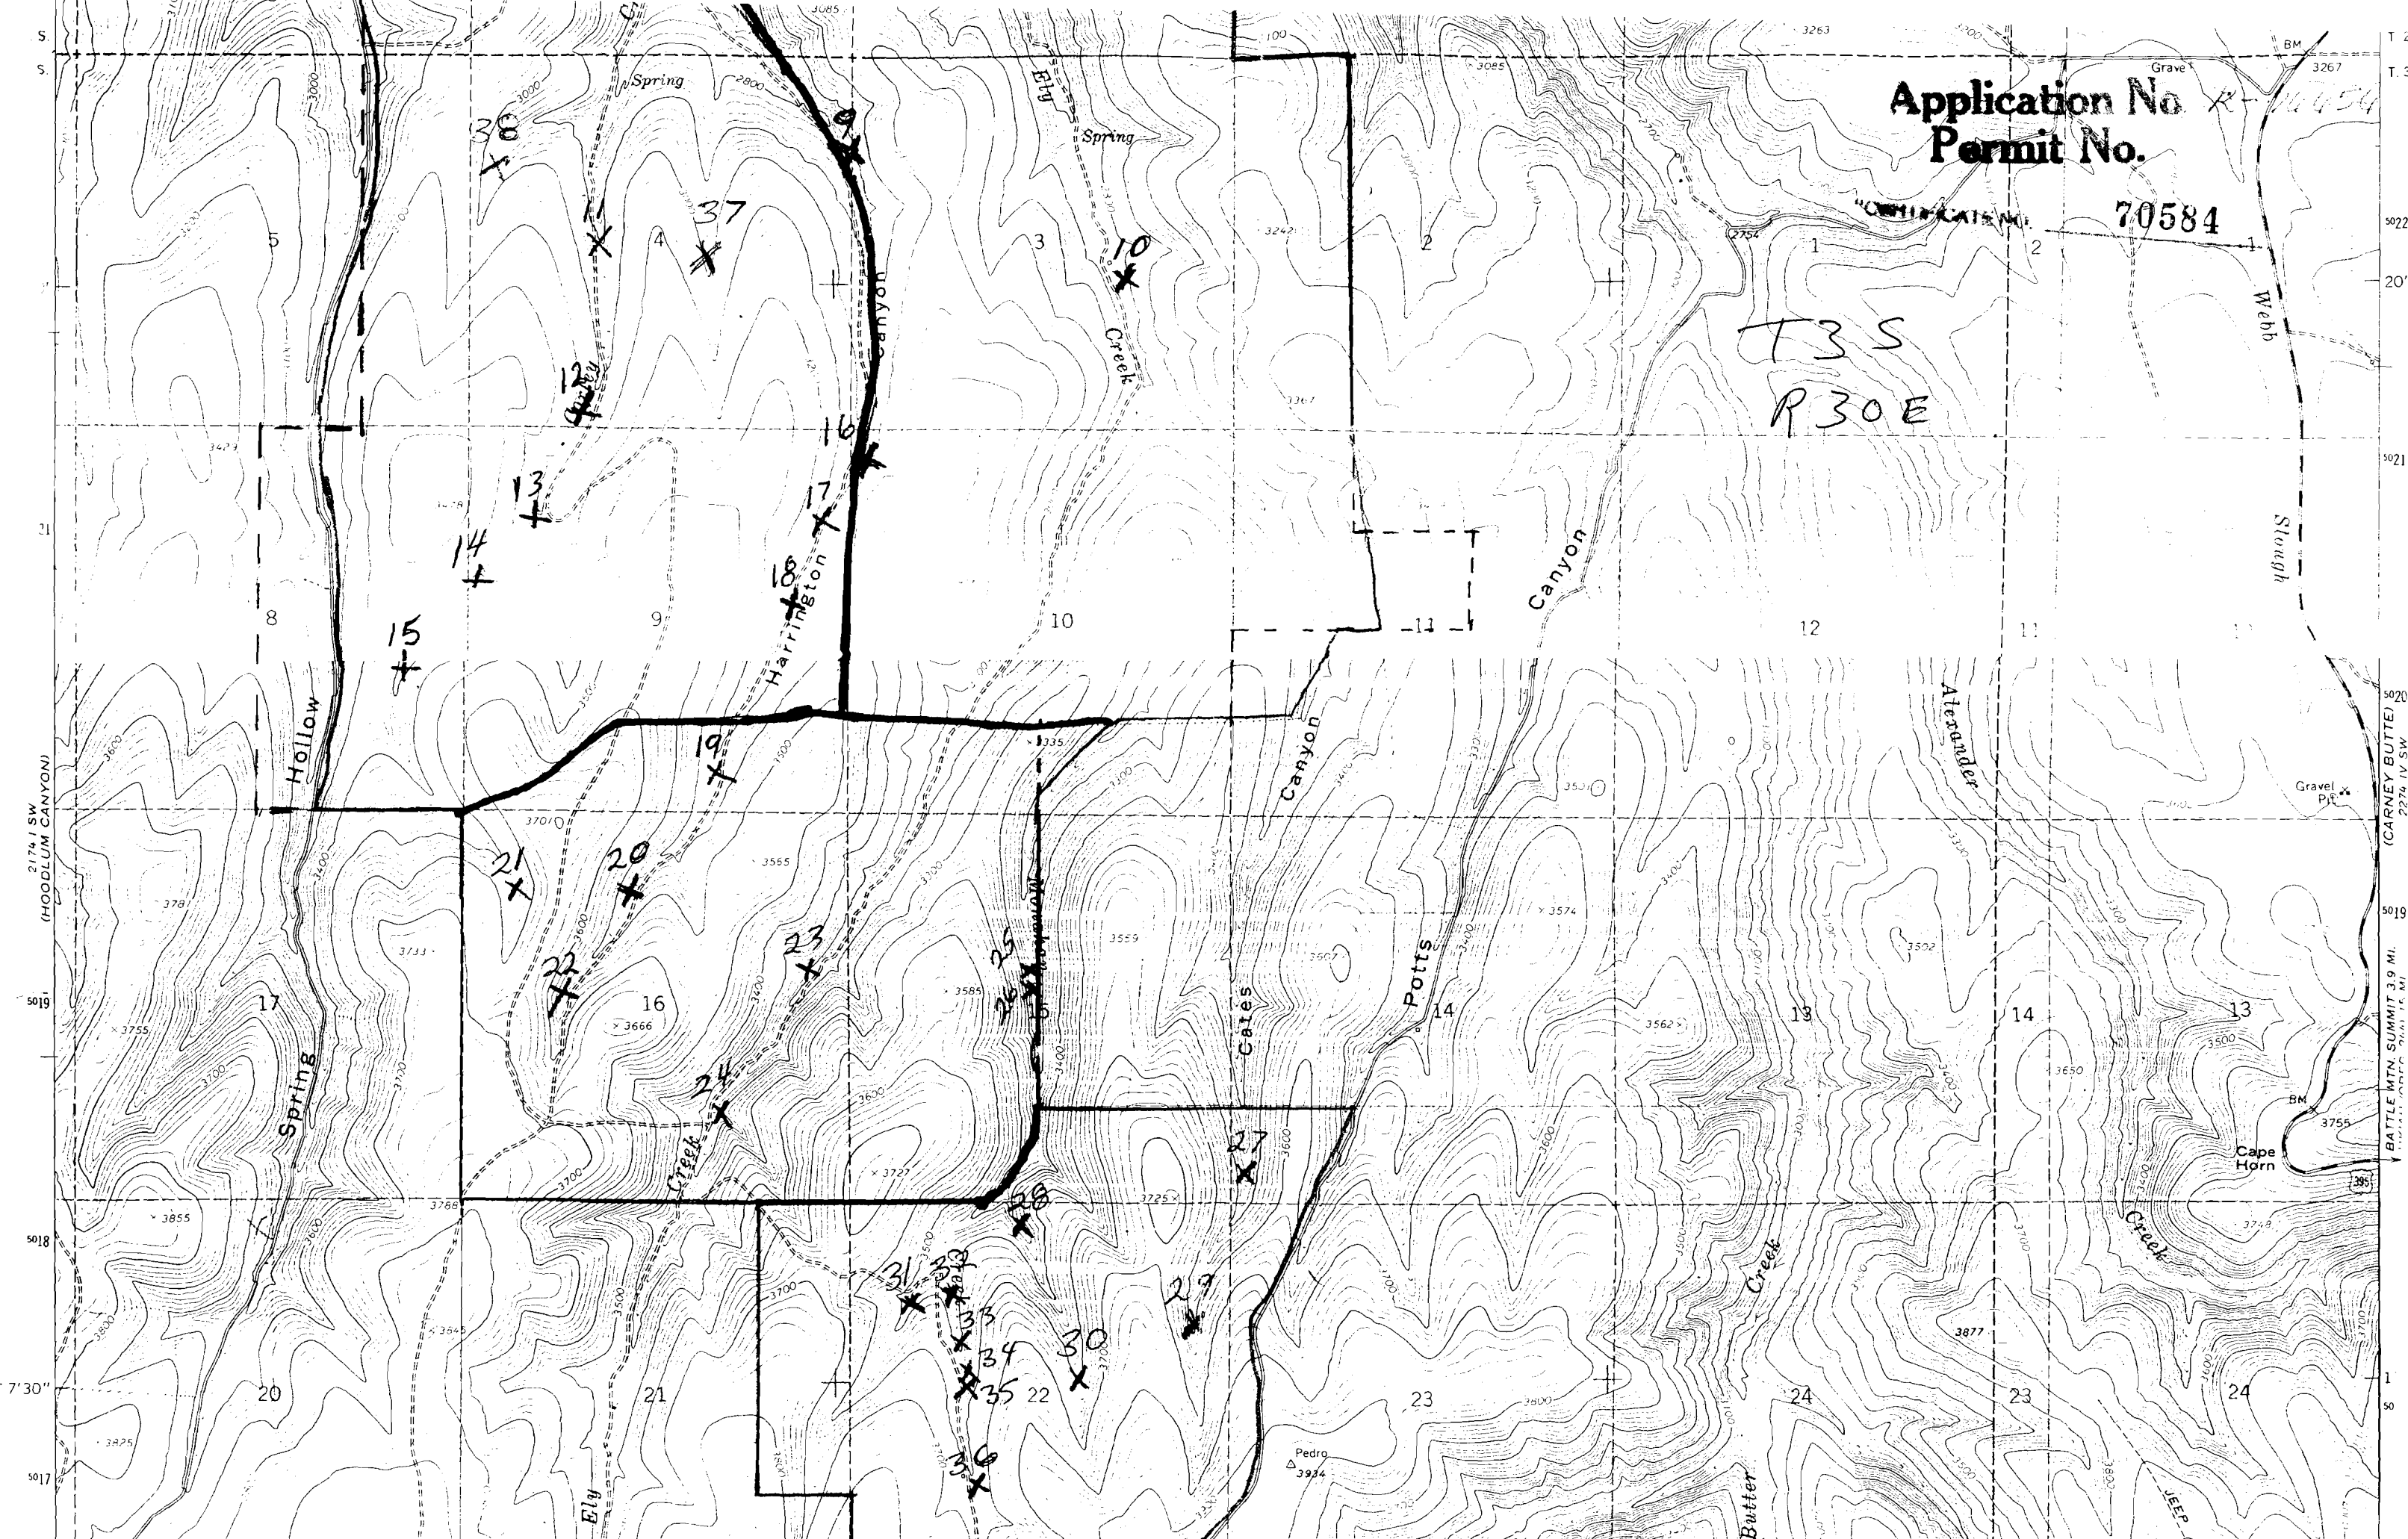

No Final Proof Map available

No Permit Map available