


WATER RESOURCES DEPT
SALEM, OREGON

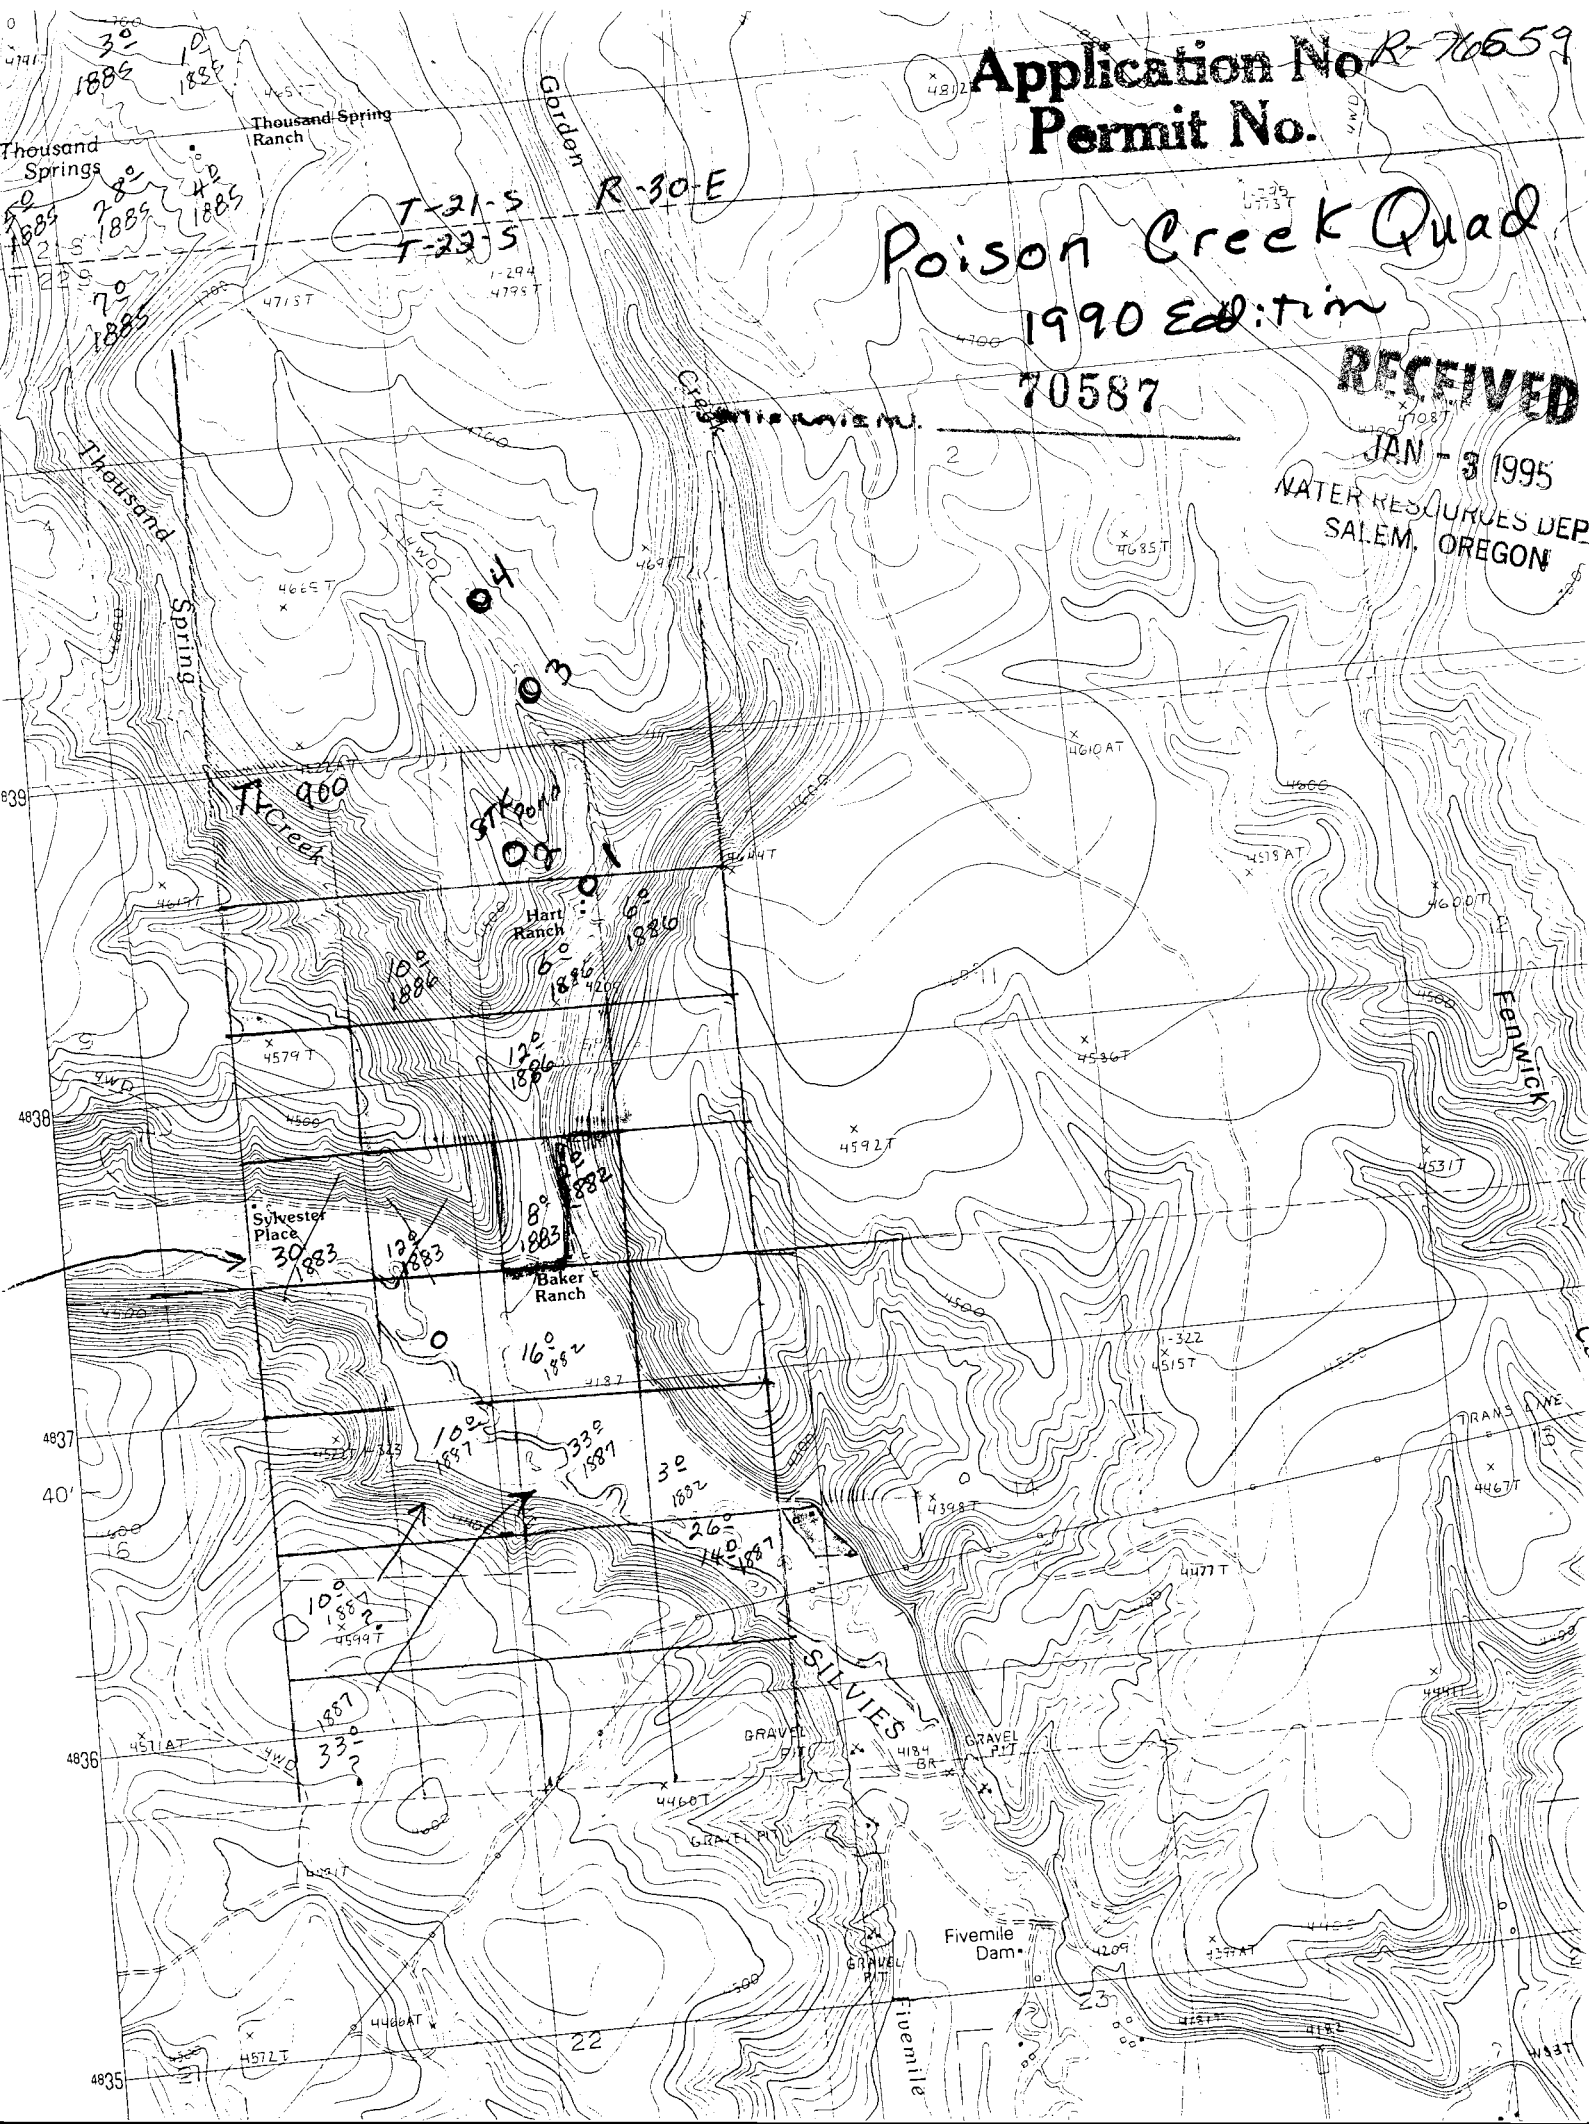

No Final Proof Map available

No Permit Map available