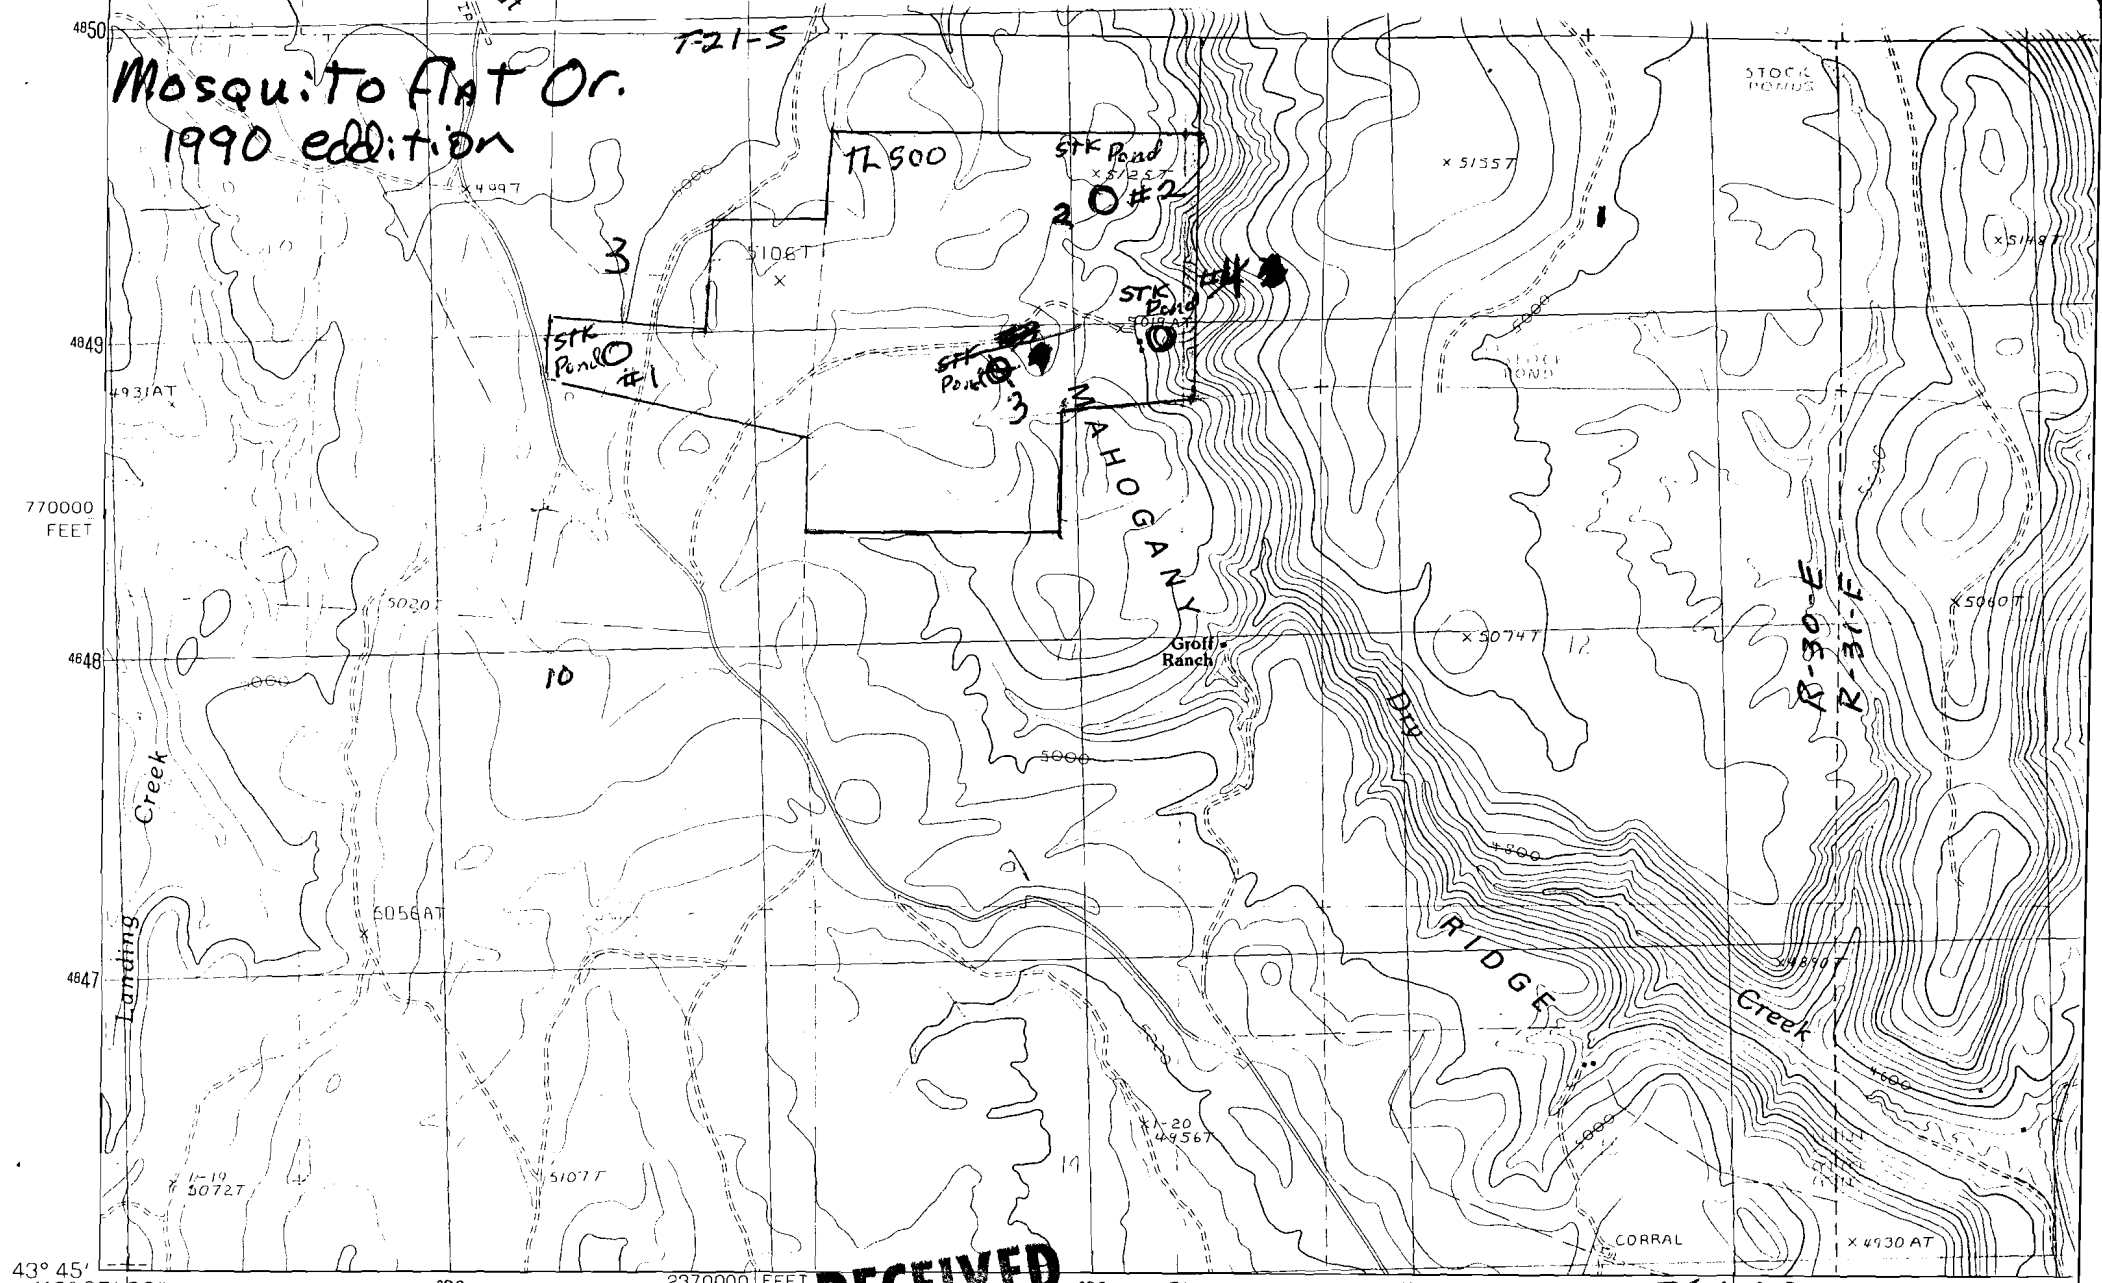


PRODUCED BY THE UNITED STATES GEOLOGICAL SURVEY
CONTROL BY.....USGS AND NOS/NOAA
COMPILED FROM AERIAL PHOTOGRAPHS TAKEN.....1984
FIELD CHECKED.....1986. MAP EDITED.....1990
PROJECTION.....LAMBERT CONFORMAL CONIC
GRID: 1000-METER UNIVERSAL TRANSVERSE MERCATOR.....ZONE 11
10,000-FOOT STATE GRID TICKS.....OREGON, SOUTH
UTM GRID DECLINATION.....1°26' WEST
1990 MAGNETIC NORTH DECLINATION.....17°30' EAST
VERTICAL DATUM.....NATIONAL GEODETIC VERTICAL DATUM OF 1929
HORIZONTAL DATUM.....1927 NORTH AMERICAN DATUM

To place on the predicted North American Datum of 1983, move the projection lines as shown by dashed corner ticks

PROVISIONAL MAP

RECEIVED
JAN - 3 1995
WATER RESOURCES DEPT.
SALEM, OREGON

Application No. R-76060
Permit No. 70588

SCALE 1:24 000

0 KILOMETERS 1
0 METERS 1000
.5 0
MILES
1000 0 1000 2000 3000 4000 5000 6000 7000 8000
FEET

CONTOUR INTERVAL 40 FEET

To convert meters to feet multiply by 3.2808