

SECTION 19 T2N R3W W.M.

WASHINGTON COUNTY OREGON

SCALE 1"=400'

Application No. *70589*
Permit No.

SEE MAP

2N 3 18

CERTIFICATE NO. 70589

CANCE

18

17

N.W. SELLERS RD.
WOOLLEN RD.


13

18

24

19

20

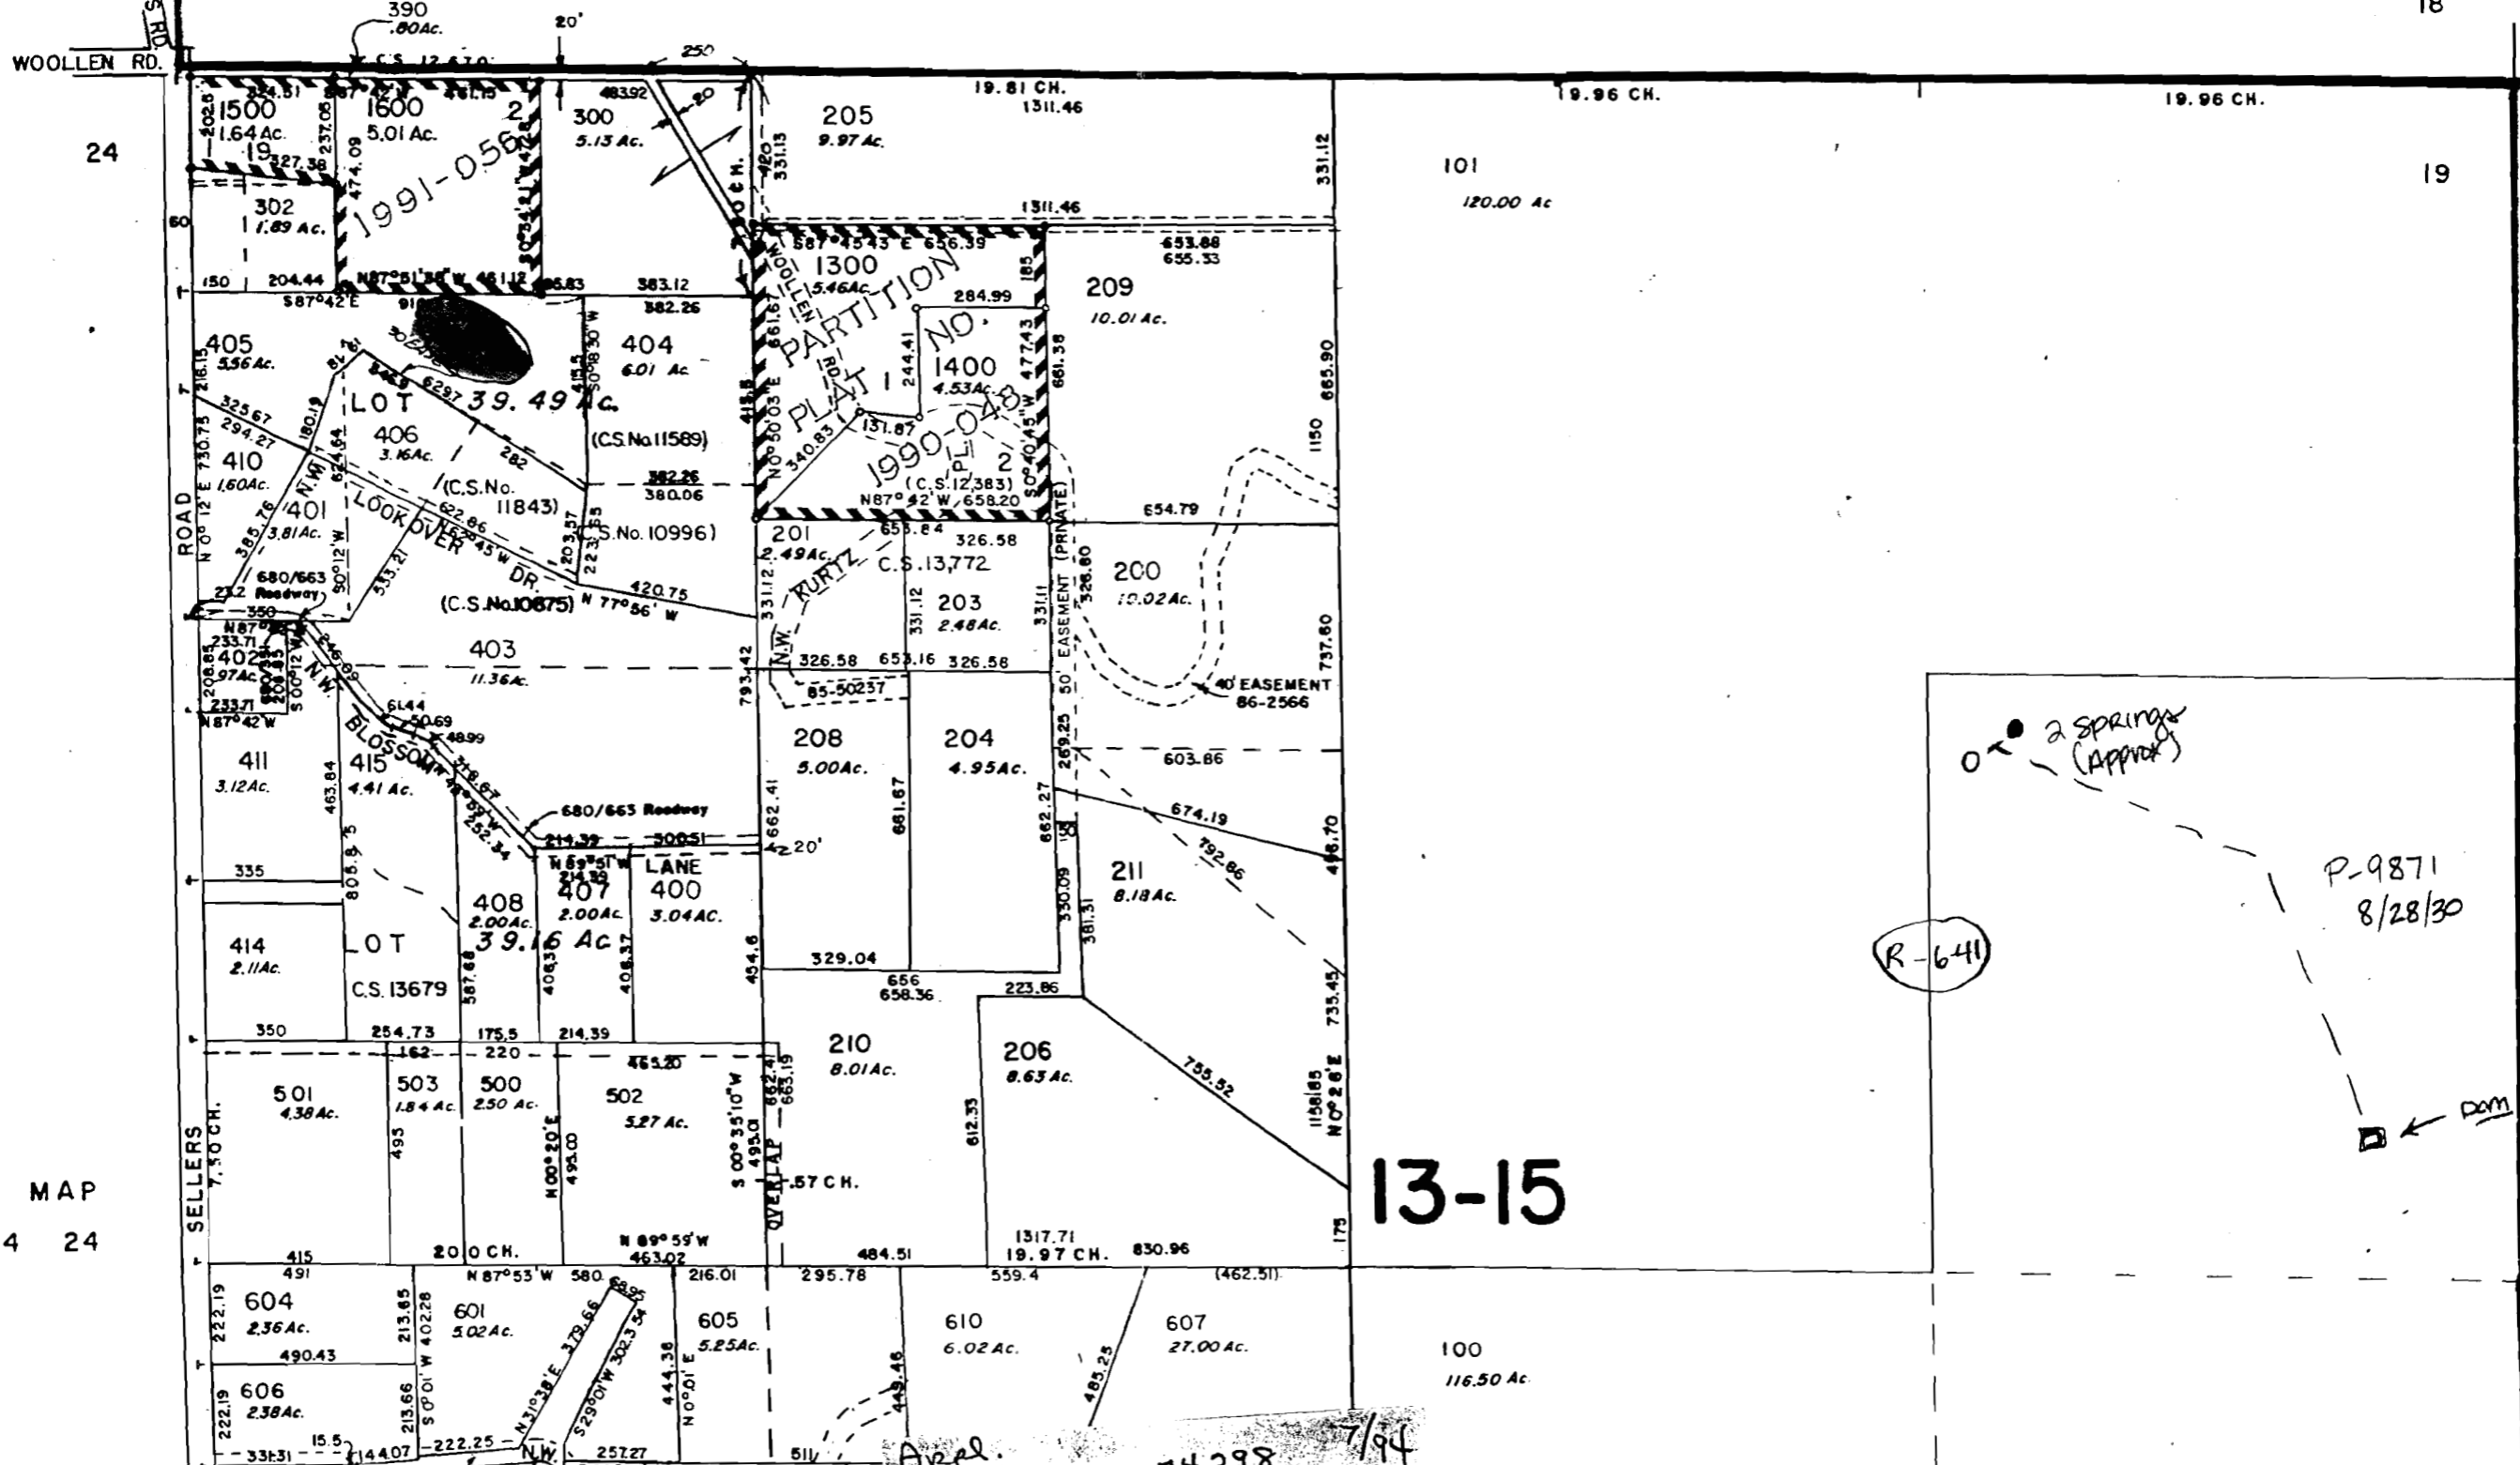

SEE MAP
2N 4 24

SE
2N