

Reservoir Name: Y12

before 1993

"CERTIFICATE NO. 70594 -

T. 15 S

R. 40 E

Sec. 36 Tax Lot 301

NW NW	NE NW	NW NE	NE NE
			36
SW NW	SE NW	36 SW NE	SE NE
NW SW	NE SW	NW SE	NE SE
SW SW	SE SW	SW SE	SE SE

"4" = 1 mile



Reservoir Name: Y 13 before 1993

CERTIFICATE NO. 70594

T. 15S

R. 41E


Sec. 19

Tax Lot 100

NW NW	NE NW	NW NE	NE NE
SW NW	SE NW	SW NE	SE NE
NW SW	NE SW	NW SE	NE SE
SW SW	SE SW	SW SE	SE SE

19

10

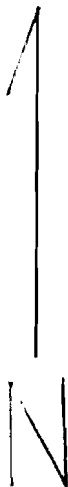

1/4" = 1 mile

Reservoir Name: Y14

before 1993

T. 155

R. 41 E

Sec. 31

70594

Tax Lot 1300

NW NW	NE NW	NW NE	NE NE
SW NW	SE NW	SW NE	SE NE
NW SW	NE SW	NW SE	NE SE
SW SW	SE SW	SW SE	SE SE

31

N
N

4" = 1 mile

Reservoir Name: Y 15 before 1993

T. 15s

R. 41E

Sec. 31

70594

Tax Lot 100

NW NW	NE NW	NW NE 31	NE NE
SW NW	SE NW	(31) SW NE	SE NE
NW SW	NE SW	NW SE	NE SE
SW SW	SE SW	SW SE	SE SE



4" = 1 mile

Reservoir Name: Y16

before 1993.

T. 15S


R. 41E

Sec. 17

Tax Lot 100

70594

NW NW	NE NW	NW NE	NE NE
SW NW	SE NW	(17) SW NE	SE NE
NW SW	NE SW	NW SE	NE SE
SW SW	SE SW	SW SE	SE SE

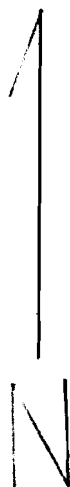

4" = 1 mile

Reservoir Name: Y 17

before 1993

"CERTIFICATE NO.

70594

T. 15S

R. 41E

Sec. 20

Tax Lot 100

NW NW	NE NW	NW NE	NE NE
SW NW	SE NW	20 W NE	SE NE
NW SW	NE SW	NW SE	NE SE
SW SW	SE SW	SW SE	SE SE

4" = 1 mile

Reservoir Name: Y18

before 1993

CERTIFICATE NO

70594

T. 155

R. 41 E

Sec. 9

Tax Lot 100

NW NW	NENW	NW NE	NENE
g			
SW NW	SE NW	⊙ SW NE	SE NE
NW SW	NE SW	NW SE	NE SE
SW SW	SE SW	SW SE	SE SE



4" = 1 mile

Reservoir Name: Y 19

before 1993

70594

T. 15 S

R. 41 E

Sec. 21

Tax Lot 100

NW NW	NE NW	NW NE	NE NE
SW NW	SE NW	SW NE	SE NE
NW SW	NE SW	NW SE	NE SE
SW SW	SE SW	SW SE	SE SE



4" = 1 mile

Reservoir Name: Y 20

before 1993

70594

T. 15S

R. 41 E

Sec. 3

Tax Lot 100

NW NW ⊗	NENW	NW NE	NENE
SW NW	SE NW	⊗ SW NE	SE NE
NW SW	NE SW	NW SE	NE SE
SW SW	SE SW	SW SE	SE SE



4" = 1 mile

Reservoir Name: Y11

before 1993

70594

T. 15 S

R. 40 E

Sec. 13

Tax Lot 301

NW NW	NE NW	NW NE	NE NE
SW NW	SE NW	SW NE	SE NE
NW SW	NE SW	NW SE	NE SE
SW SW	SE SW	SW SE	SE SE



18



4" = 1 mile

No Final Proof Map available

No Permit Map available