
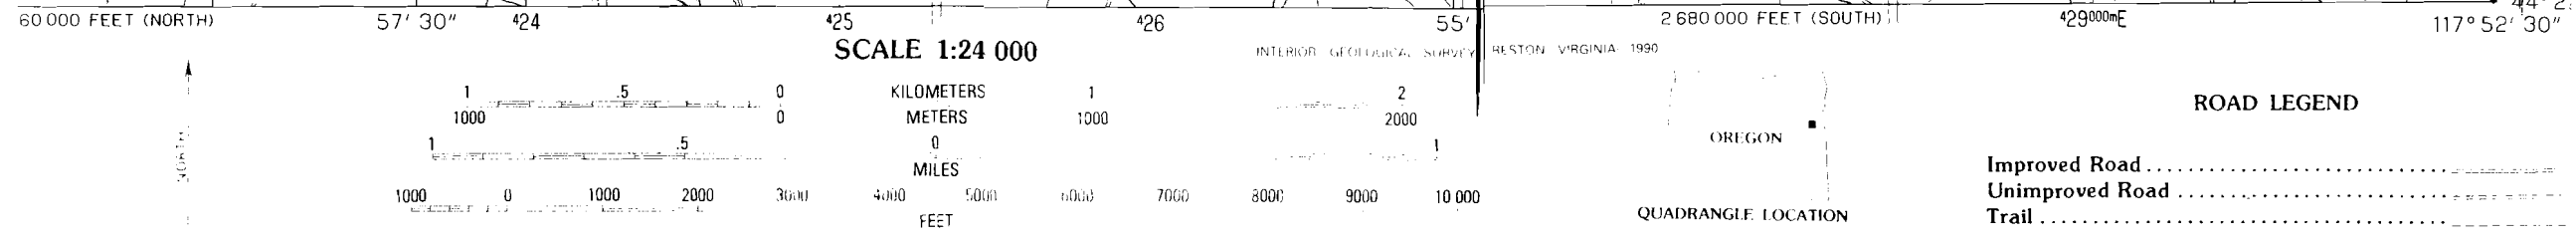


Application No. R-76661
 Permit No. 70597

COMMERCIAL NO. 70597

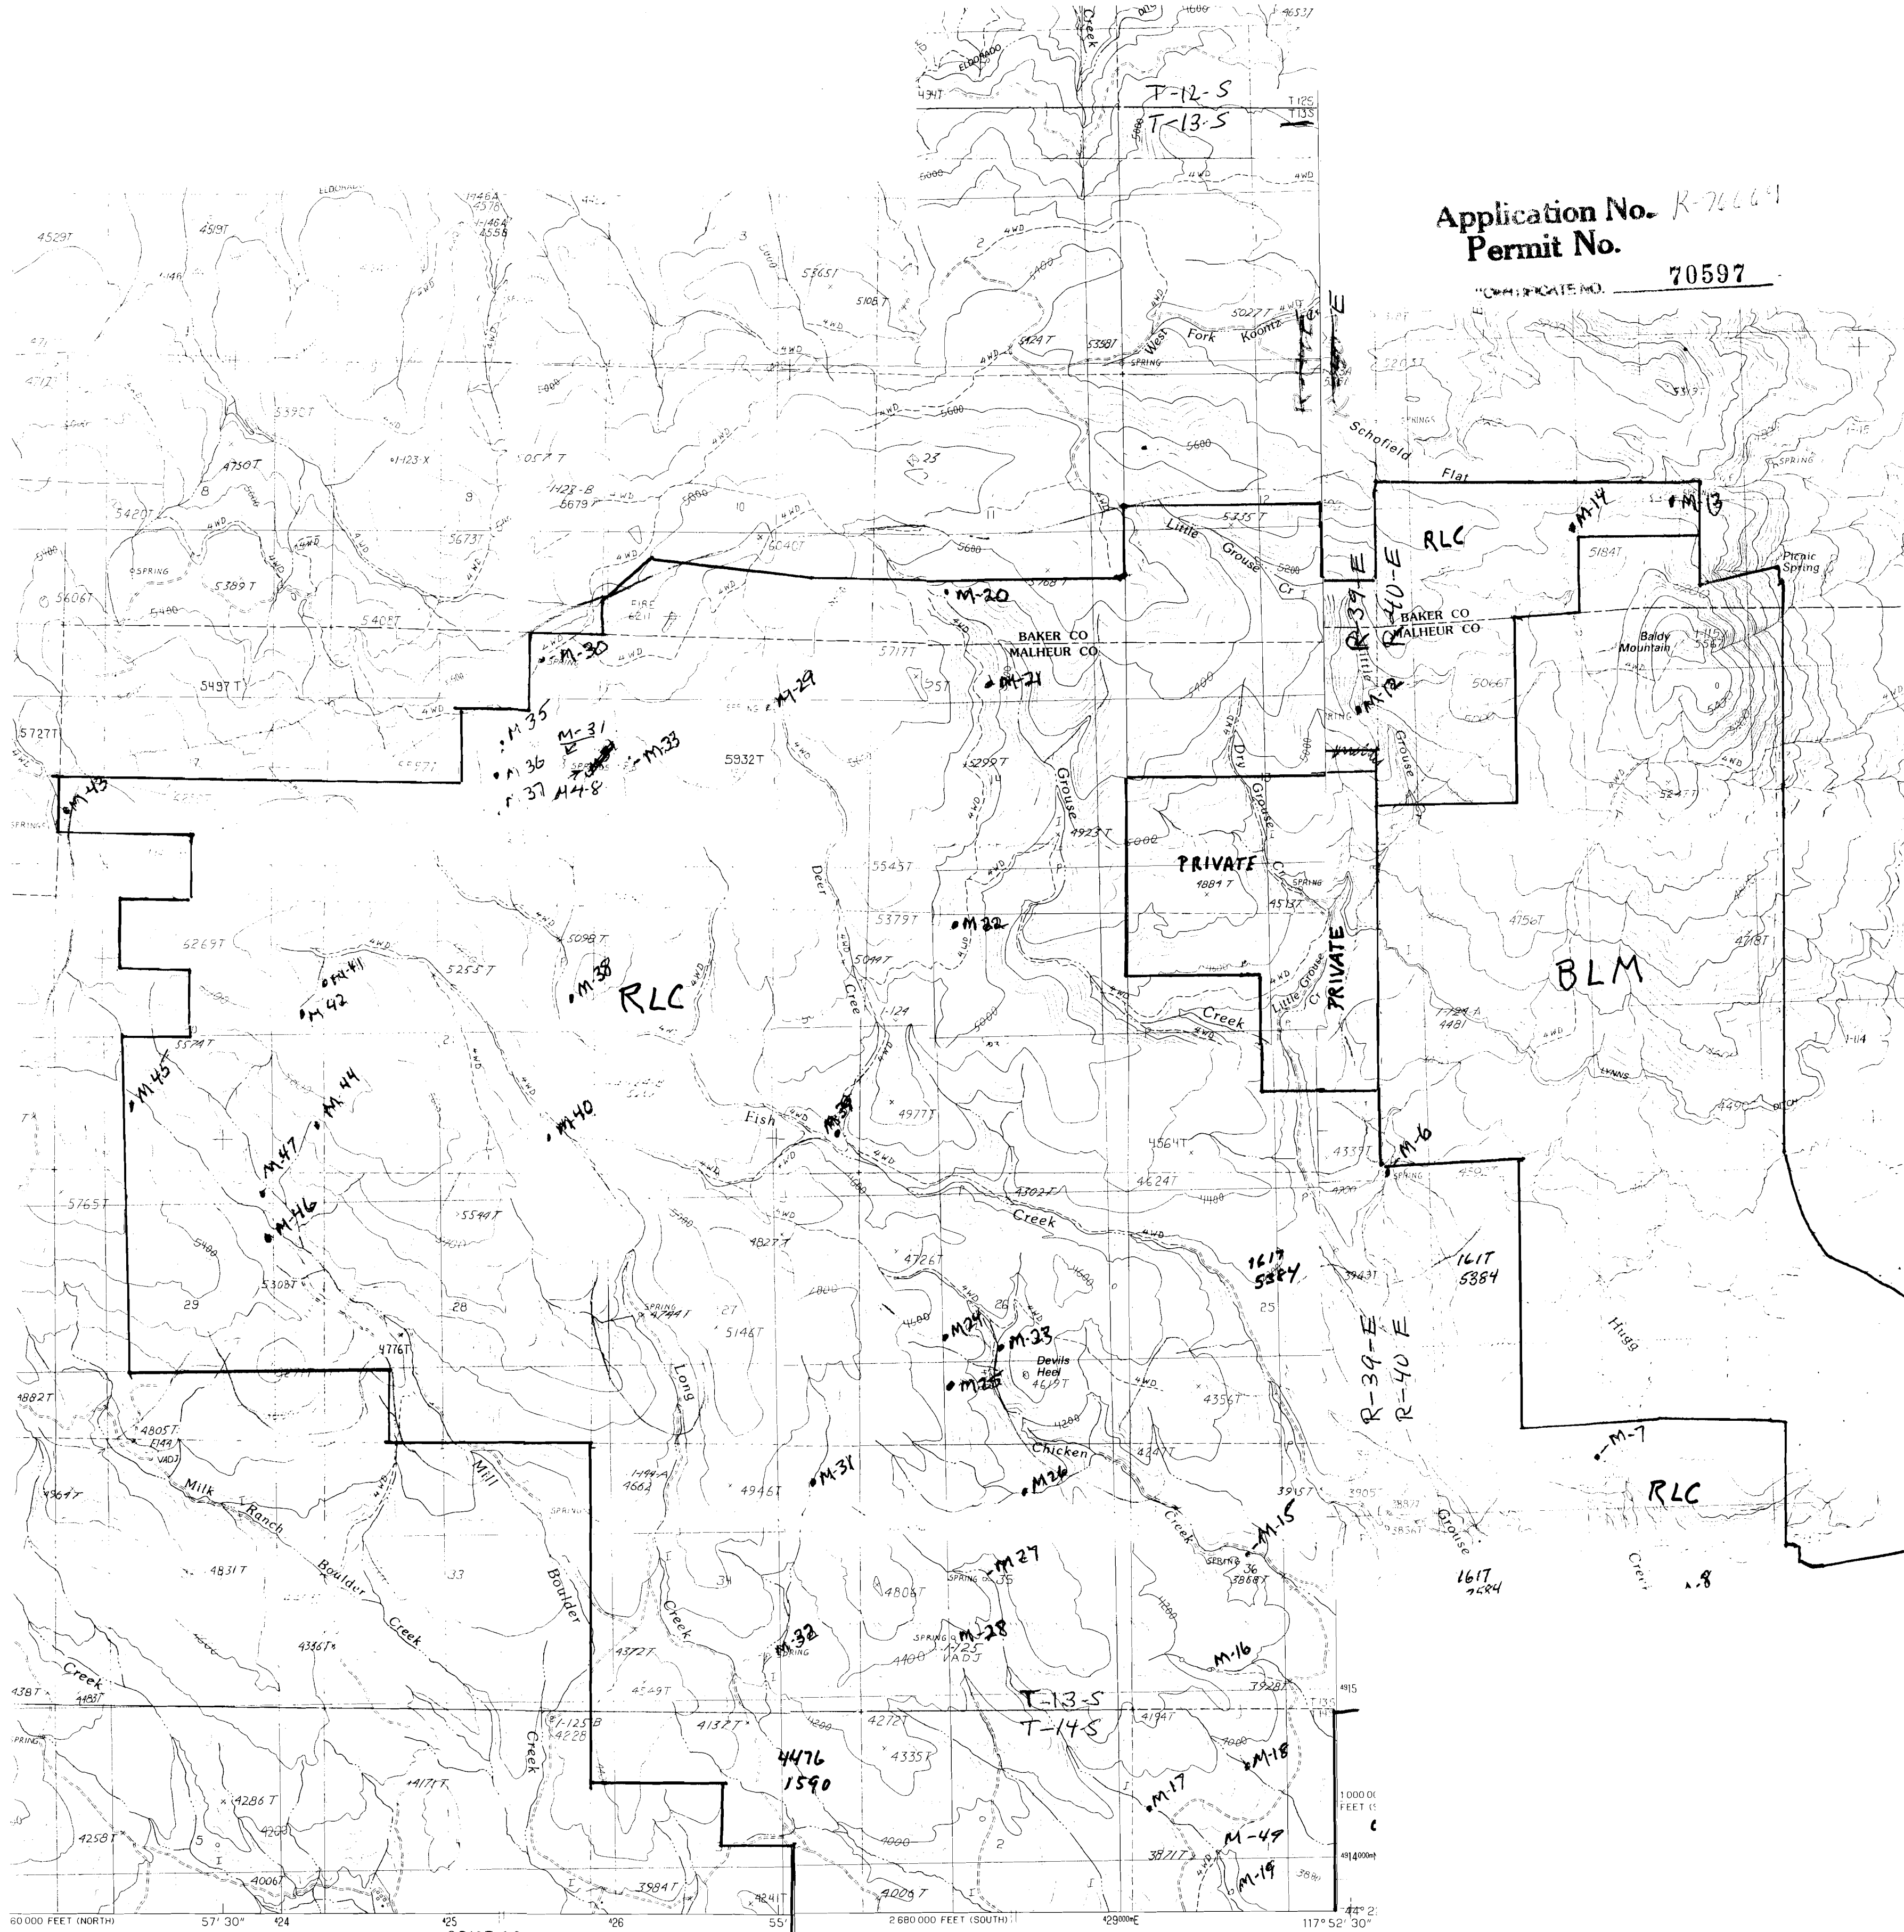

PROVISIONAL MAP
 Produced from original

CONTOUR INTERVAL 40 FEET
 SUPPLEMENTARY CONTOUR INTERVAL 20 FEET
 To convert meters to feet multiply by 3.2808
 To convert feet to meters multiply by .3048

DEVILS HEEL, OREGON
 PROVISIONAL EDITION 1990

No Final Proof Map available

No Permit Map available