

12 JAN 13 1995

CERTIFICATE NO.

70598

Northwest Harney Lake Oreg

1990 Edition

NORTHWEST HARNEY LAKE
OREGON-HARNEY
7.5 MINUTE SERIES (TOI)

T 26 S

R 29 W

TL 10

Sec


RECEIVED

DEC 20 1994

WATER RESOURCES DEPT.
SALEM, OREGON

Application No. R-70670
Permit No.

Hollow

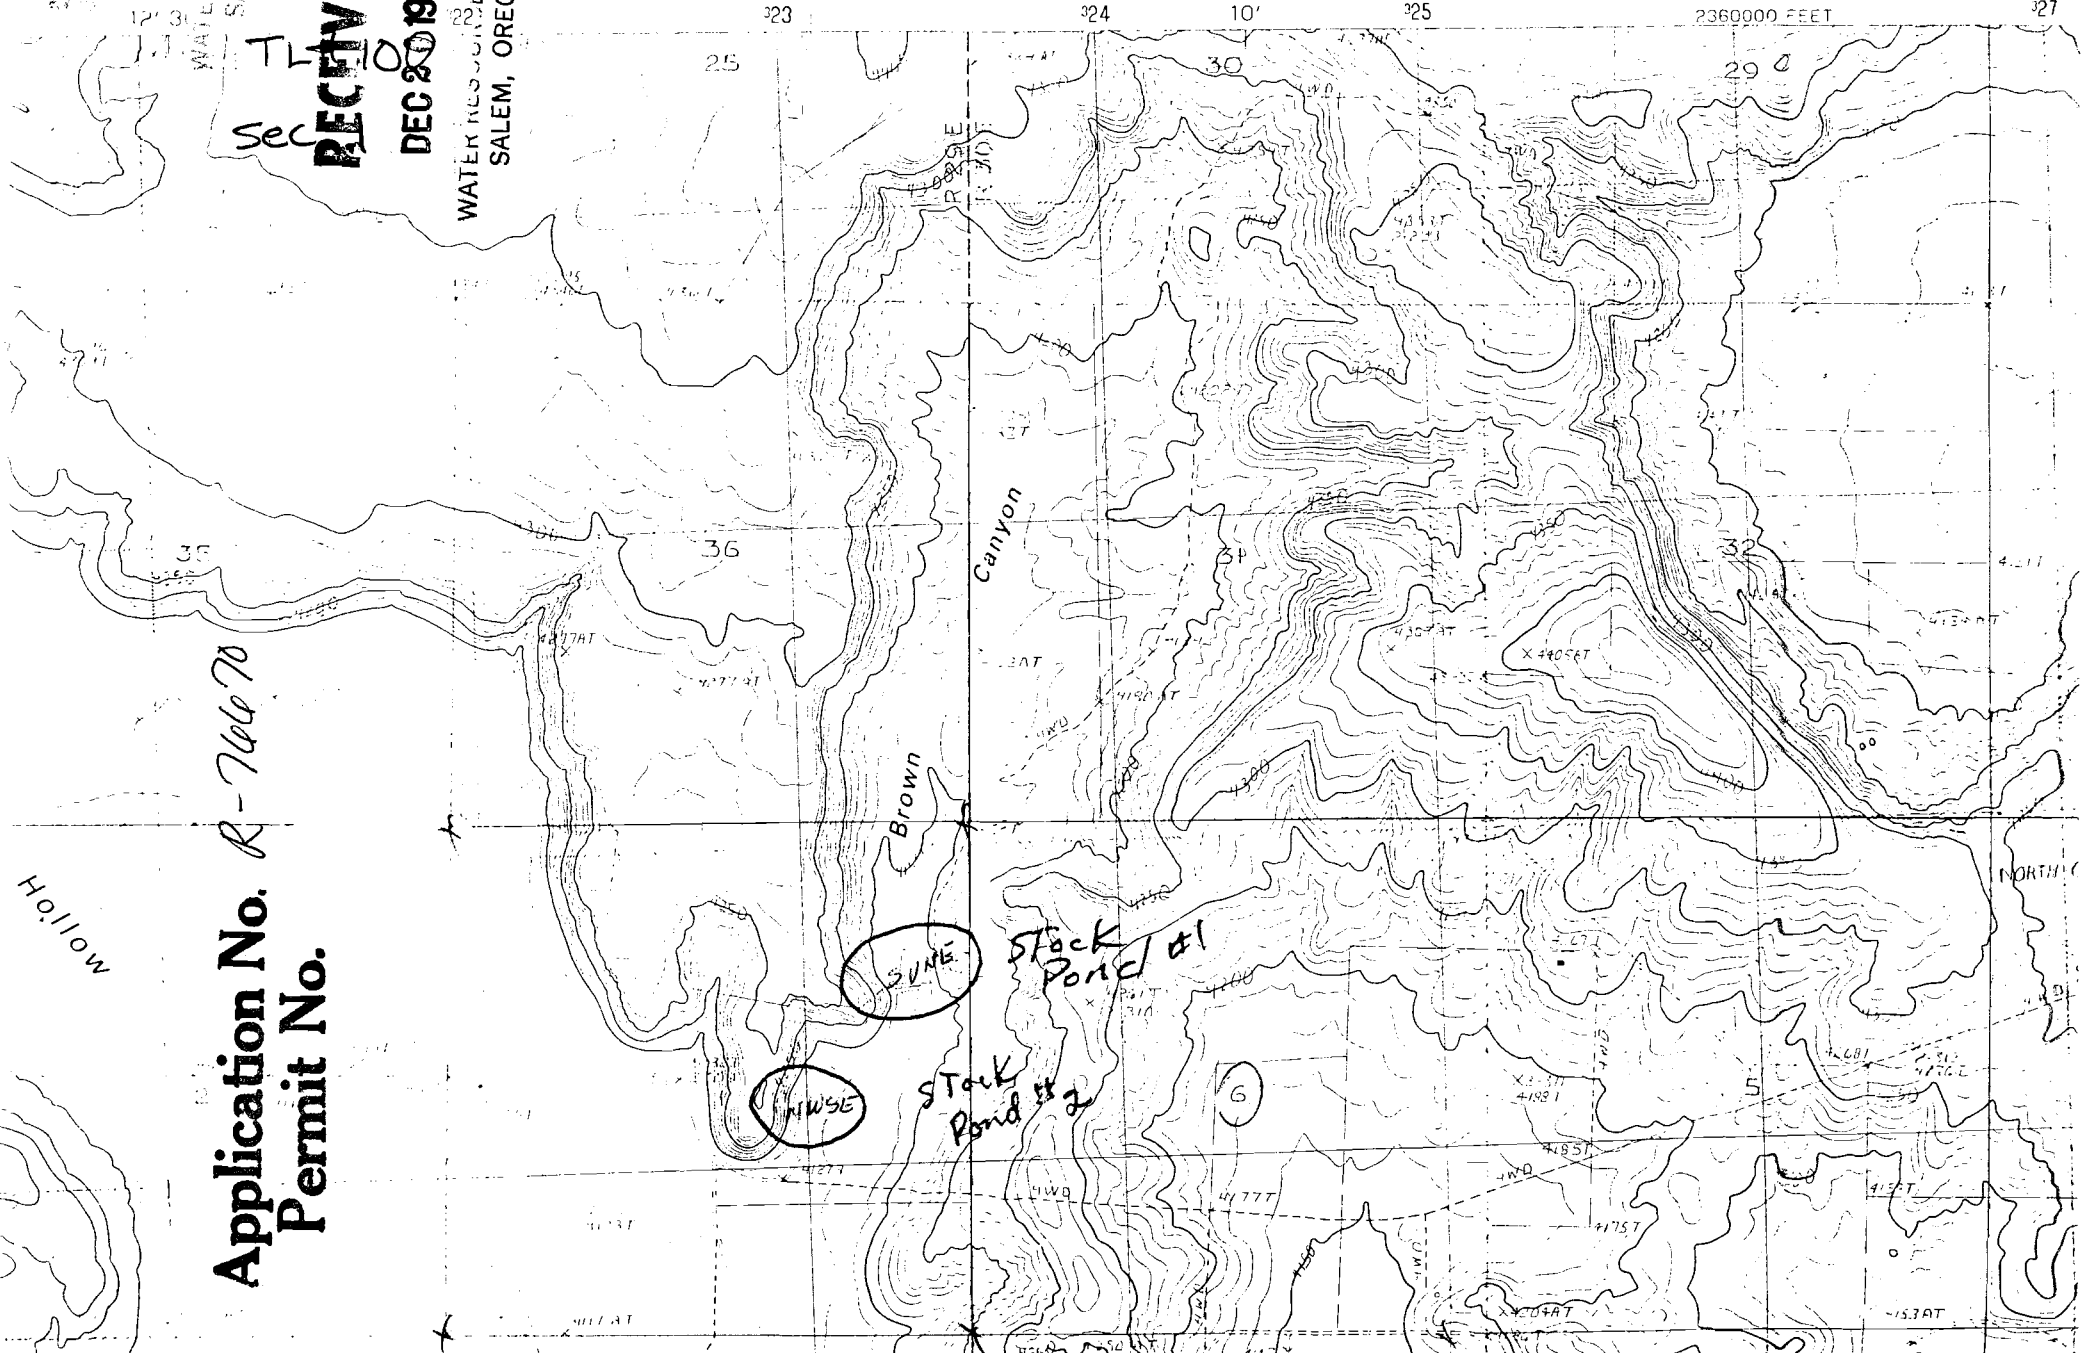

No Final Proof Map available

No Permit Map available