


Work Copy


location of reservoir based on original Application Map. BC 6-12-96

SECTION 23 T1S R3W WM  
WASHINGTON COUNTY OREGON  
SCALE 1"=400'

1S 3 23

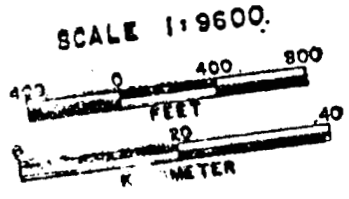

This map was prepared for assessment purposes only.

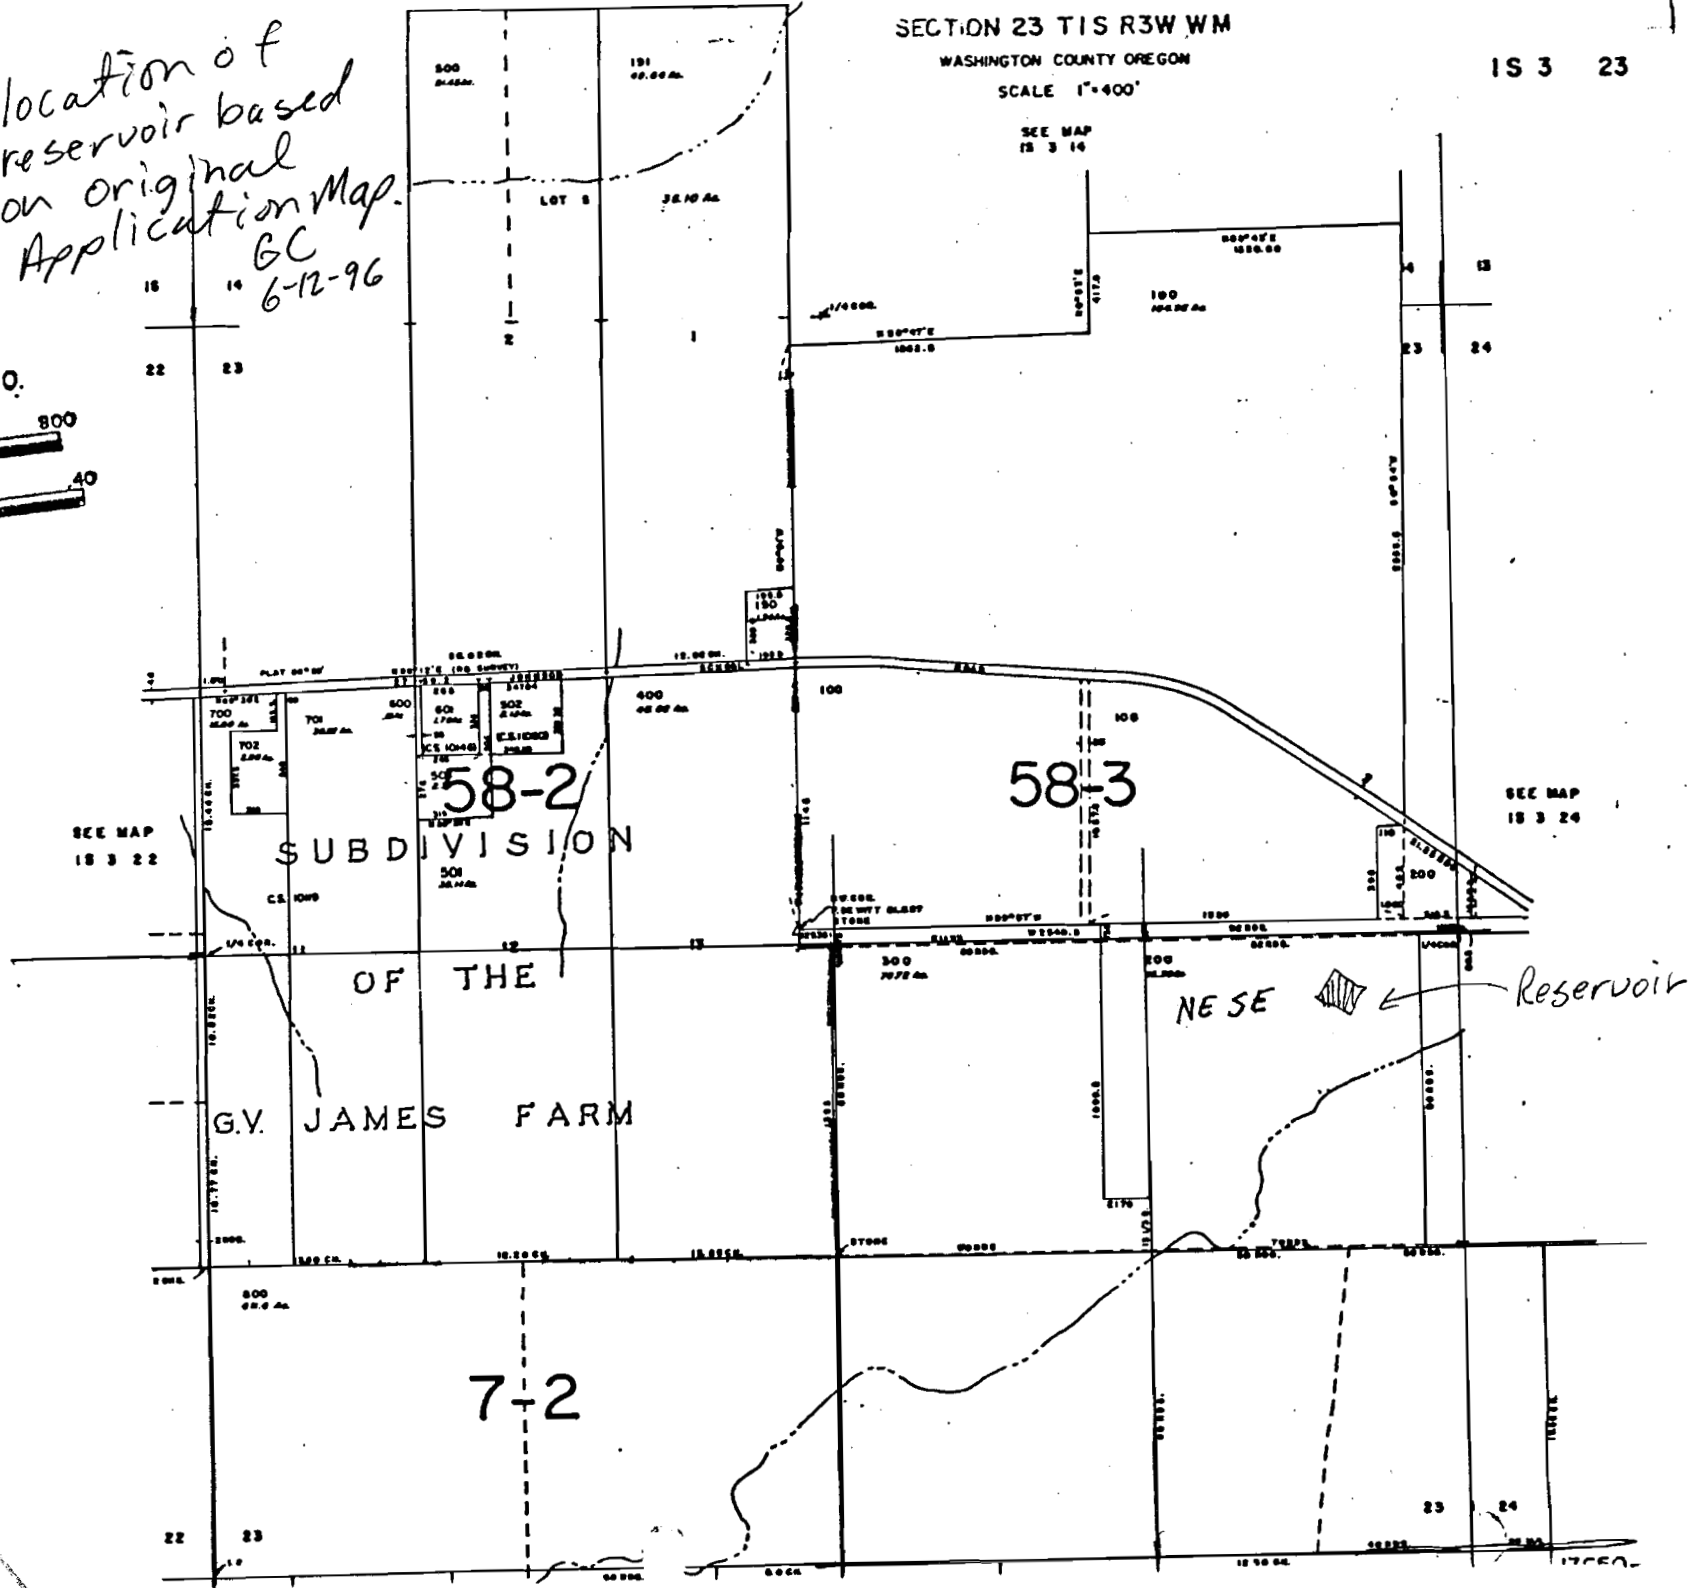

NESE ← Reservoir