


Application No R-76473
Permit No.

70600

(MADISON BUTTE)
2174 III SW


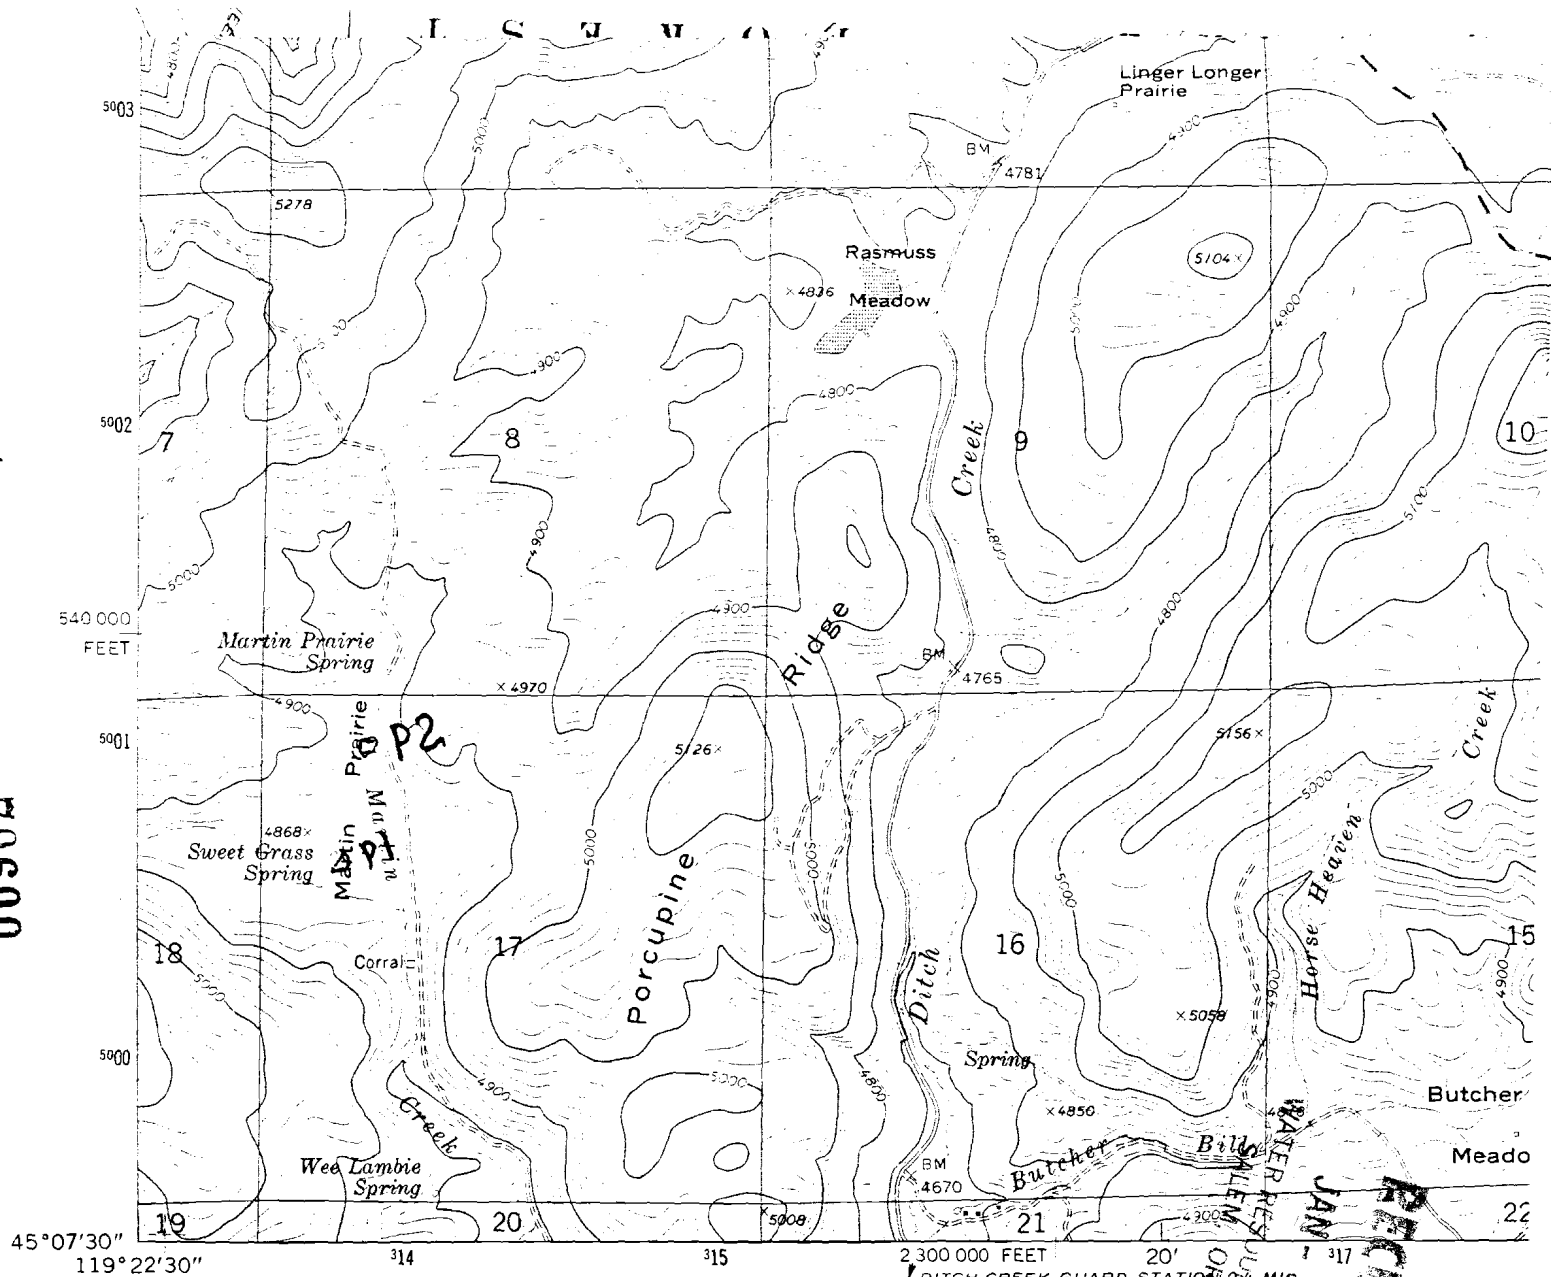


Mapped, edited, and published by the Geological Survey

Control by USGS and NOS/NOAA

Topography by photogrammetric methods from aerial photographs taken 1967. Field checked 1969

Polyconic projection. 1927 North American Datum
10,000-foot grid based on Oregon coordinate system,
north zone

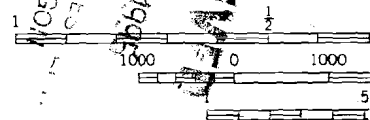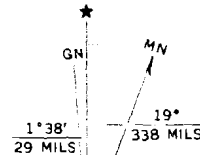

CC
NATION

No Final Proof Map available

No Permit Map available