

EIMER NUTON H.B 2153
Sec. 25

T15S R44E W.M.
MALHEUR COUNTY

Application No. R-76687
Permit No.

15 44

Revised on
9-19-68

1" = 2000'
SEE MAP 14 44


FOR ASSESSMENT PURPOSE ONLY

CERTIFICATE NO. 70610

CANCELLED
NUMBERS
1601
1300

SEE MAP 15 43

SEE MAP 15 45

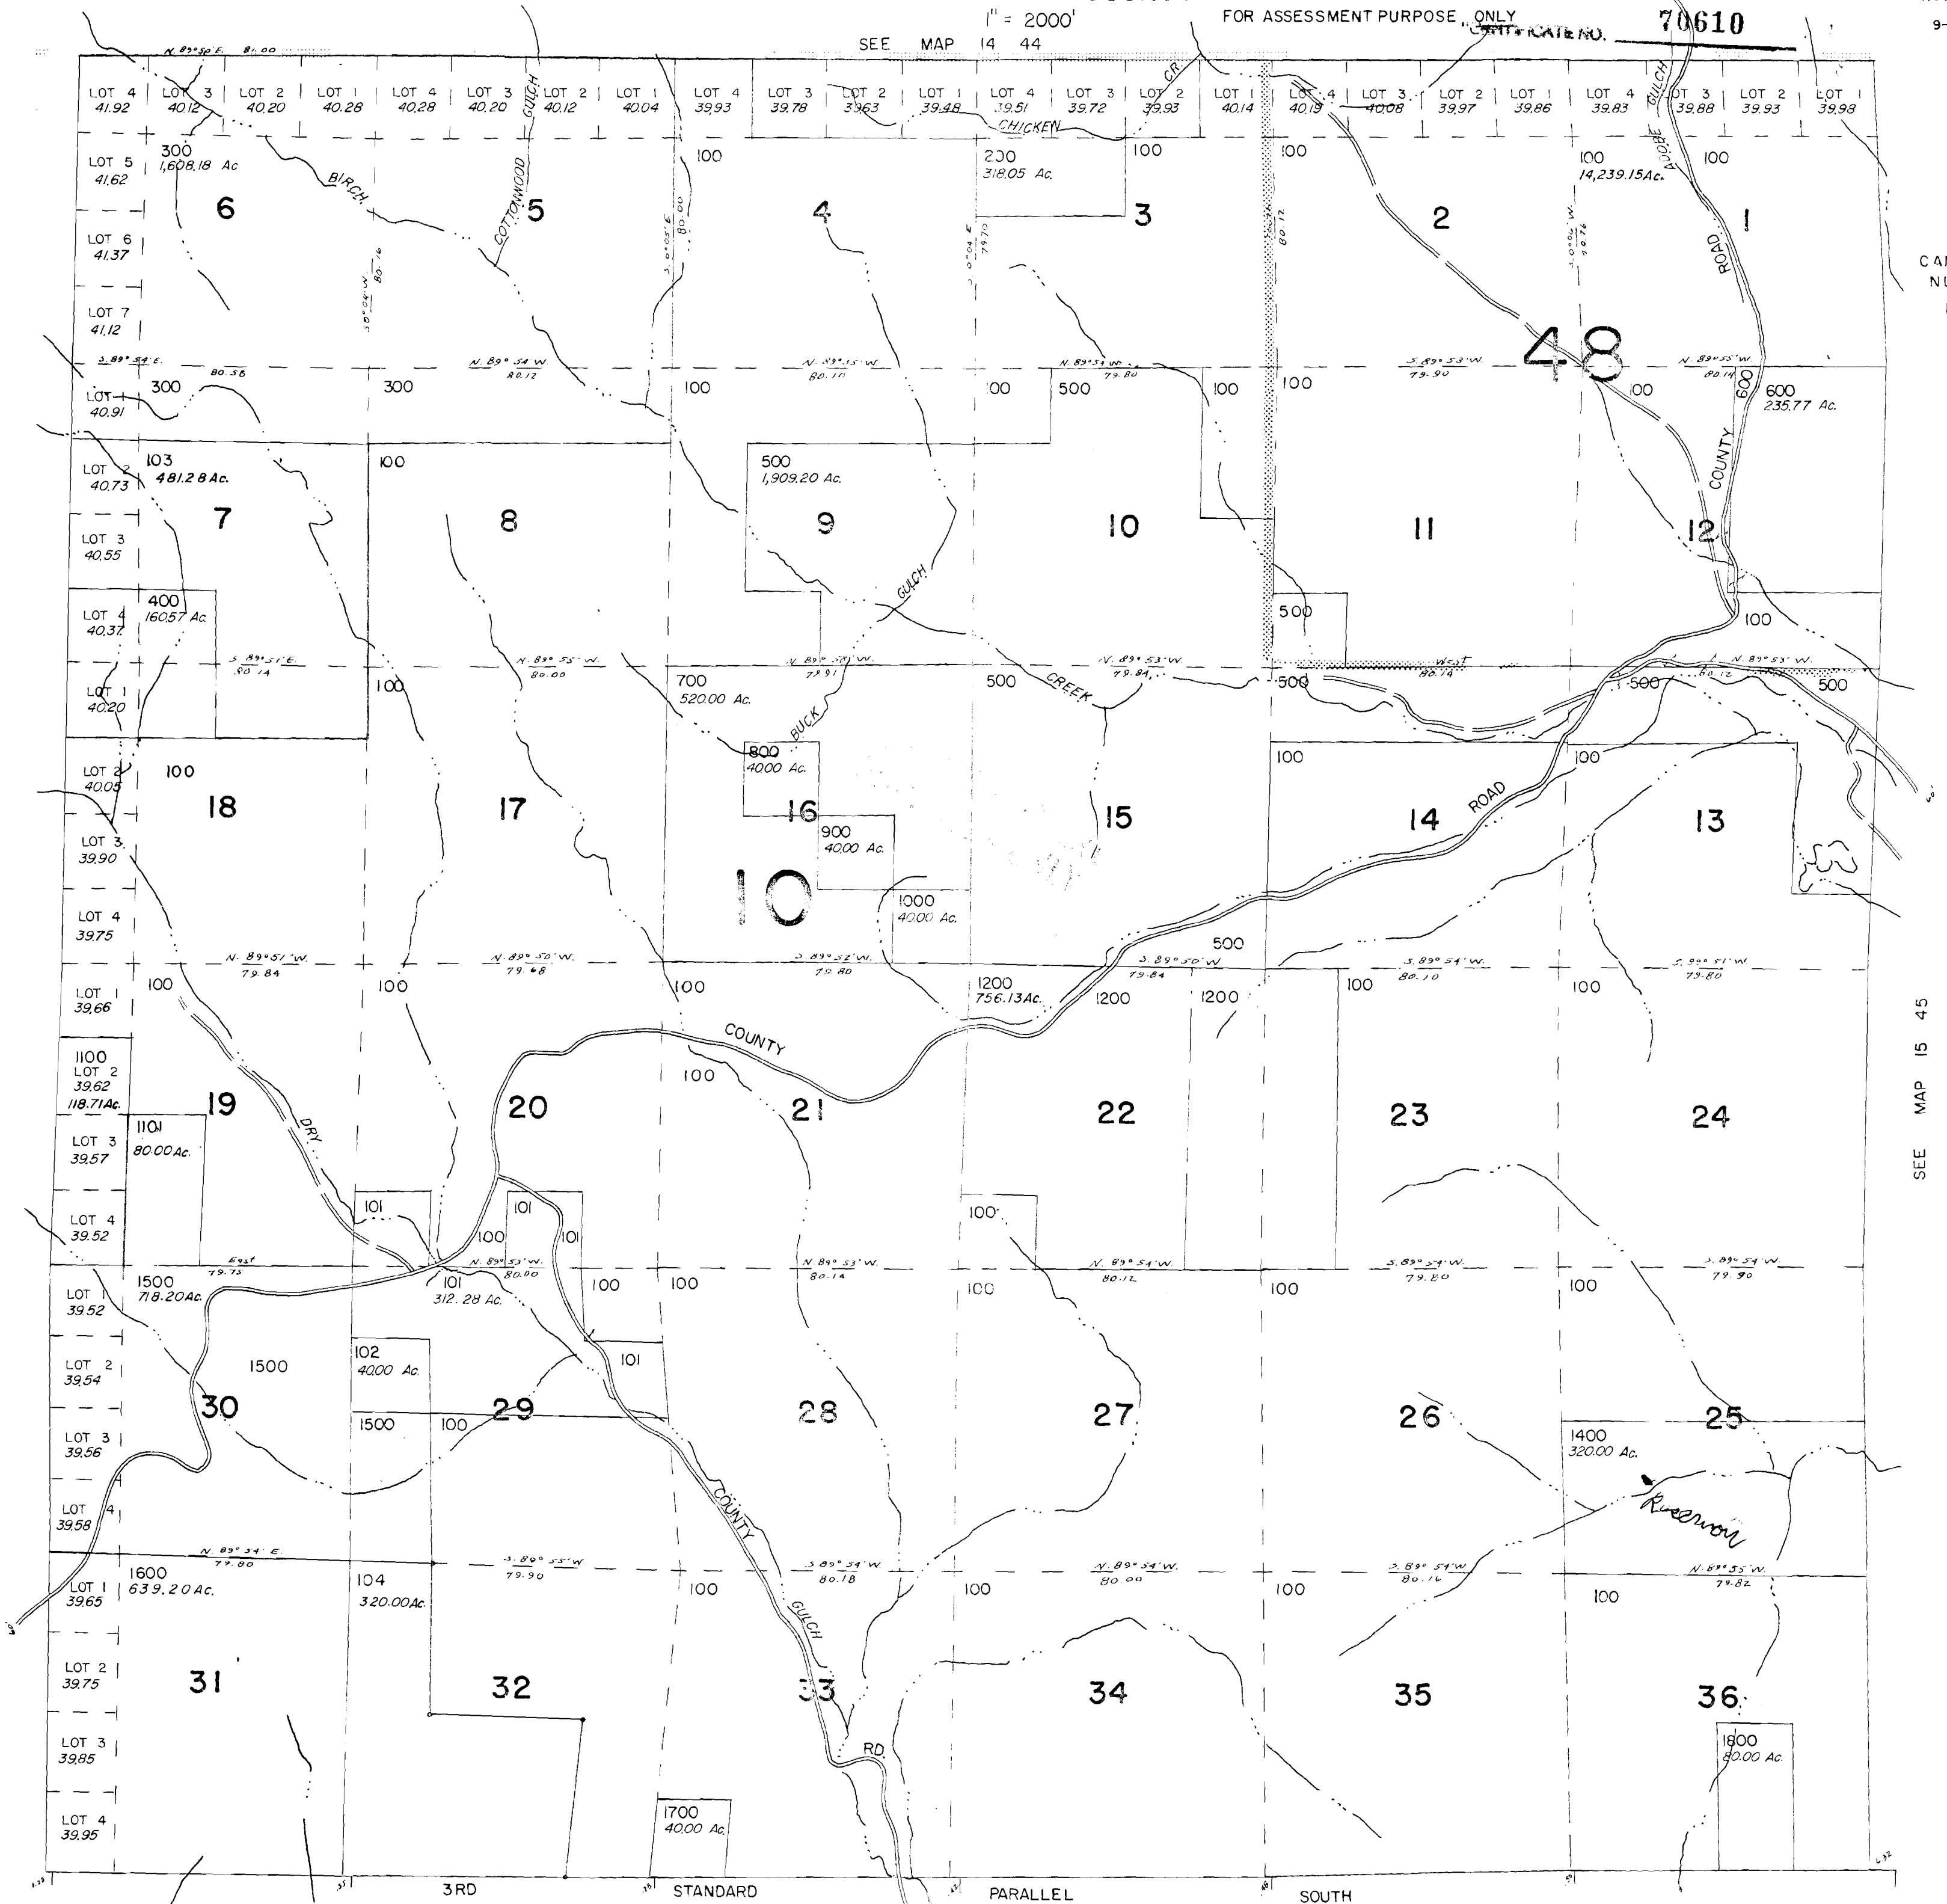

SEE MAP 16 44

15 44

No Final Proof Map available

No Permit Map available