



Application No. K-76701
Permit No.

70624

S
INTERIOR
VEY

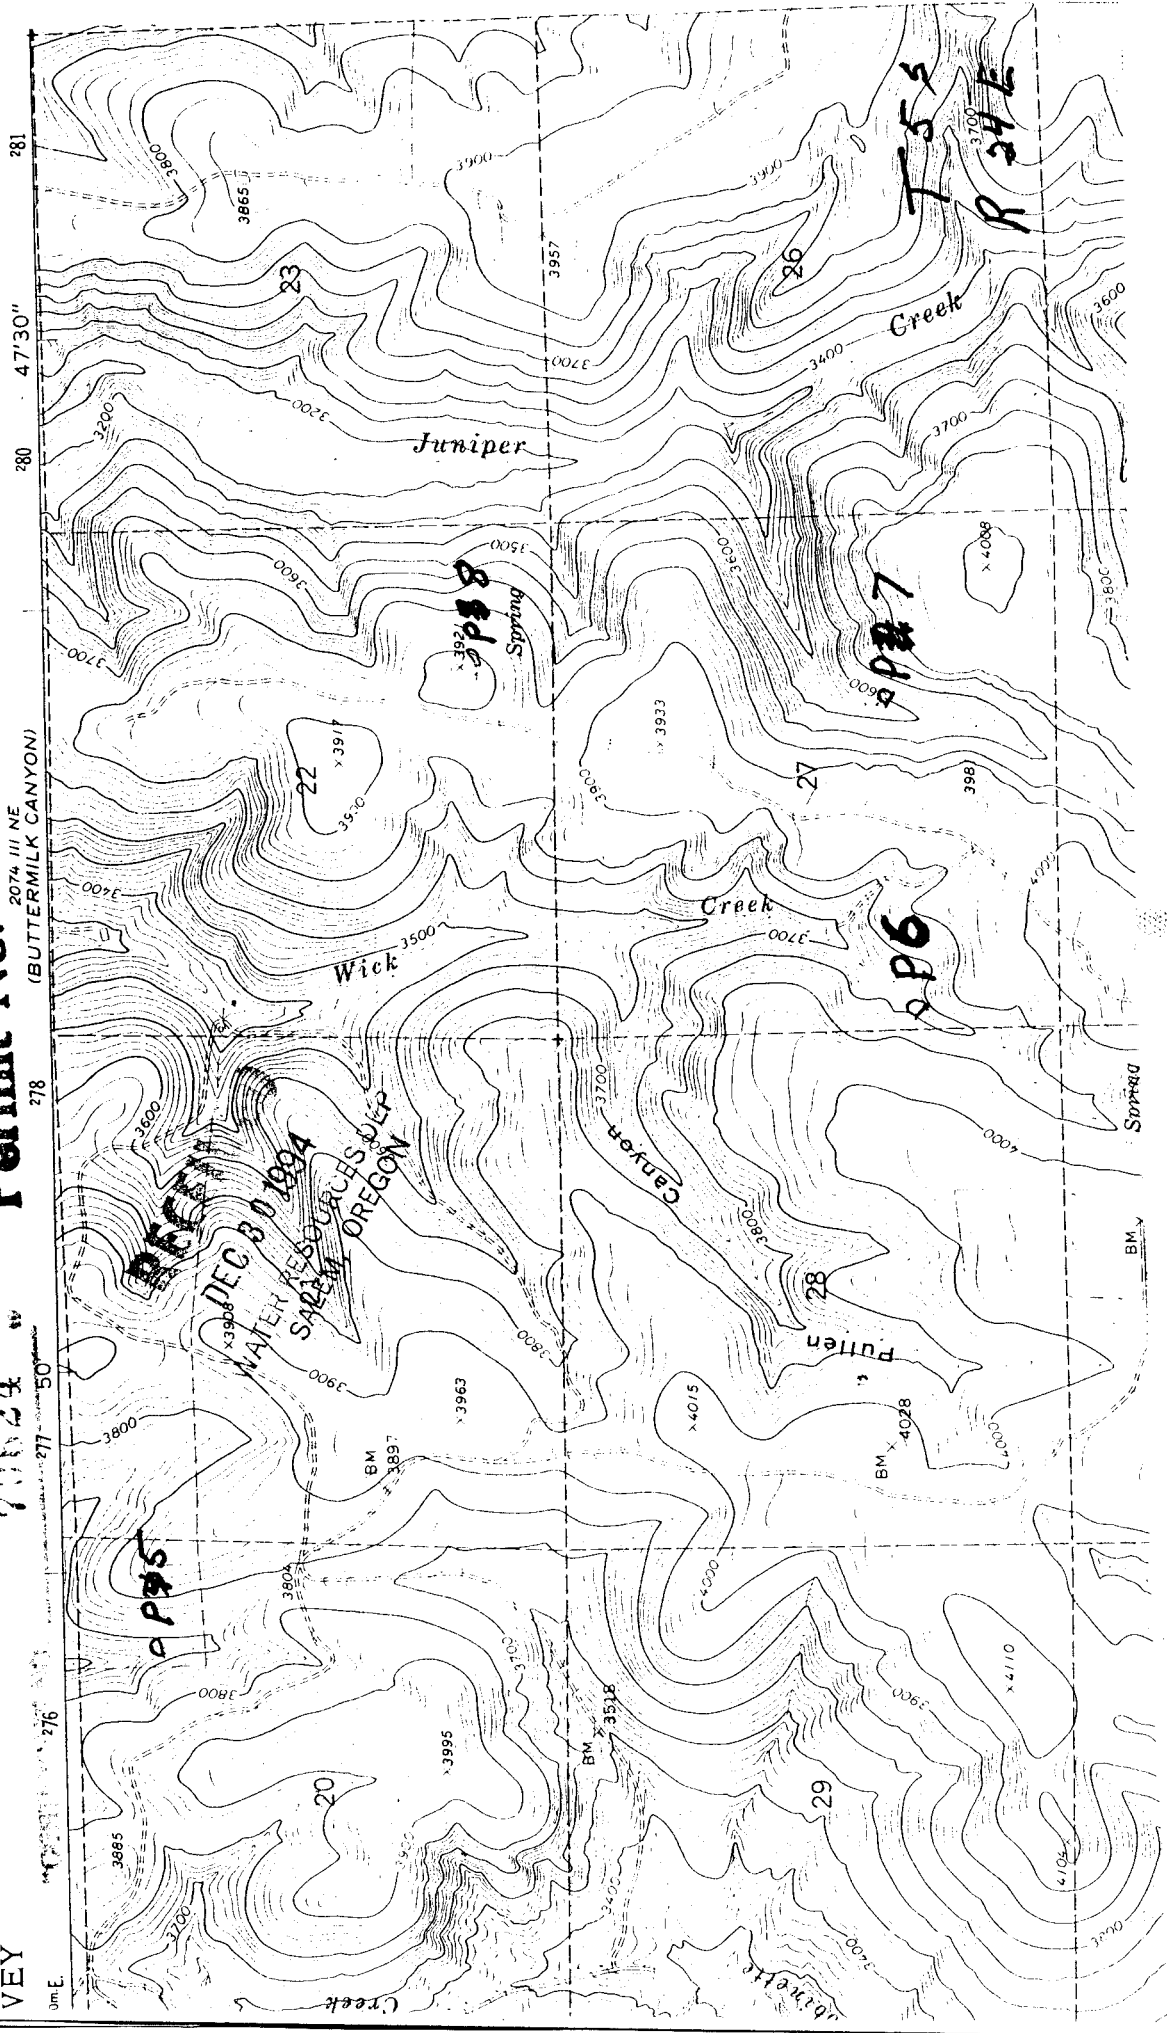

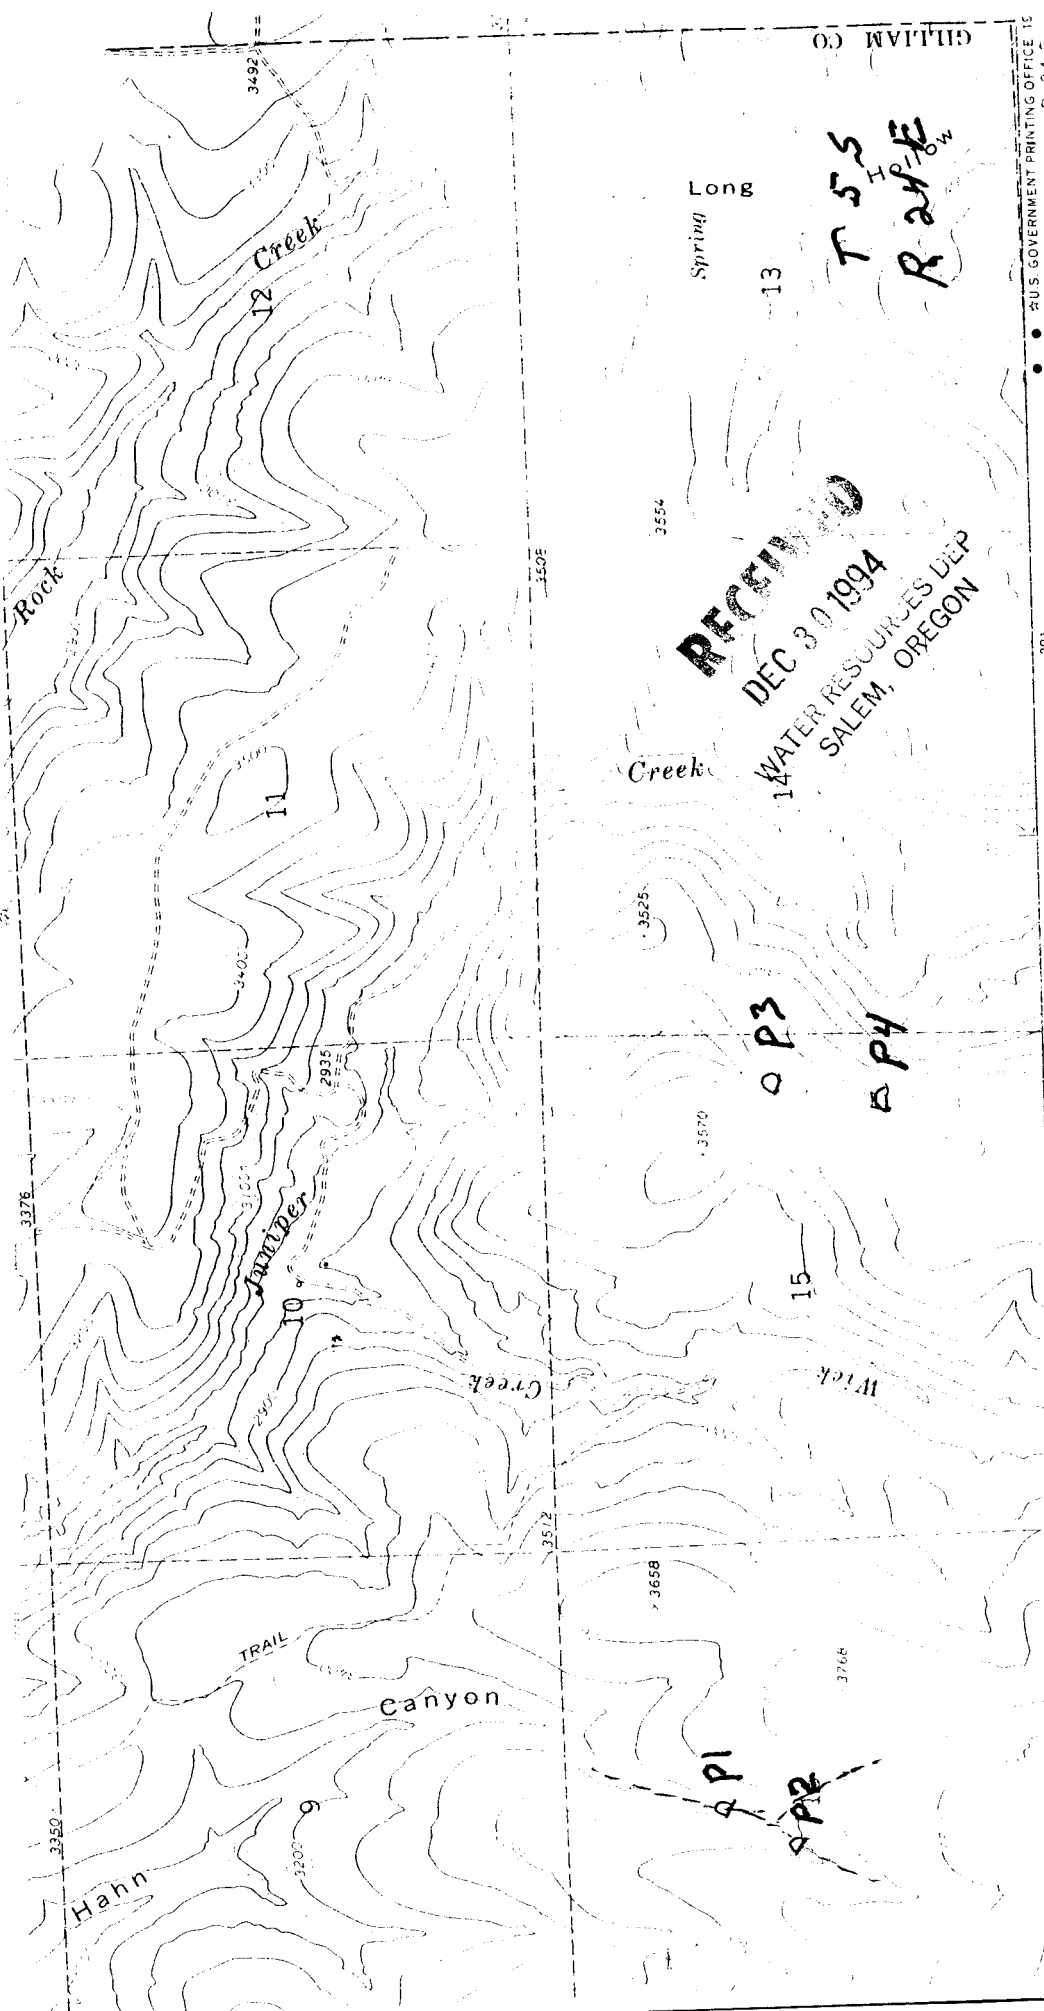

ROAD CLASSIFICATION

Primary highway, hard surface ——— Improved surface ———

Secondary highway, hard surface ——— Unimproved surface ———

Interstate Route ——— U S Route ———

CONTOUR INTERVAL 20 FEET
 DATUM IS MEAN SEA LEVEL

SCALE 1:24 000

0 1000 2000 3000 4000 5000 6000 7000 FEET

0 1 2 3 4 5 6 7 8 9 10 KILOMETER

OREGON
 QUADRANGLE LOCATION

Application No. *R-76701*
 Permit No. *70824*

BUTTERMILK CANYON
 N4507.5—W119