


70631

T.IN. & IS. R. 4 W. W.M.

Application No. *R-76709*
Permit No.

DEC 31 1944
WATER RES.
SALEM, ORE.

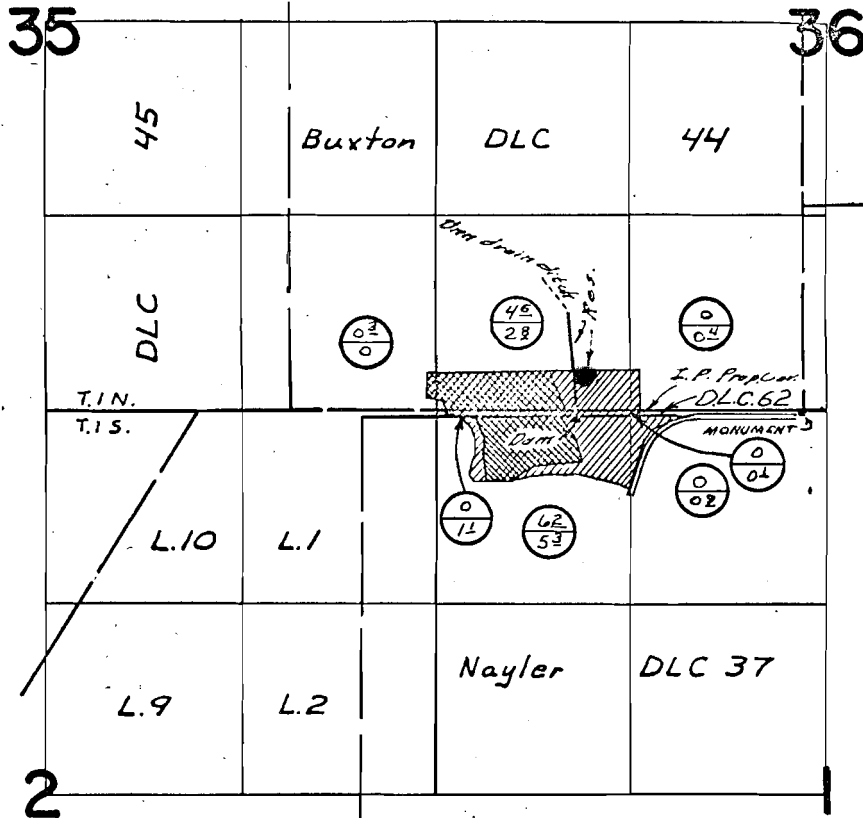

Supplemental
Primary

Diversion point located 1540 ft W.
& 30 ft S. from SE. Cor. Buxton DLC 44

FINAL PROOF SURVEY UNDER

R-41003 R-4599
Application No. *41004* Permit No. *32572*
IN NAME OF

Francis Duyck

Surveyed *Aug 18 1944* by *W.J. Ruppert*