



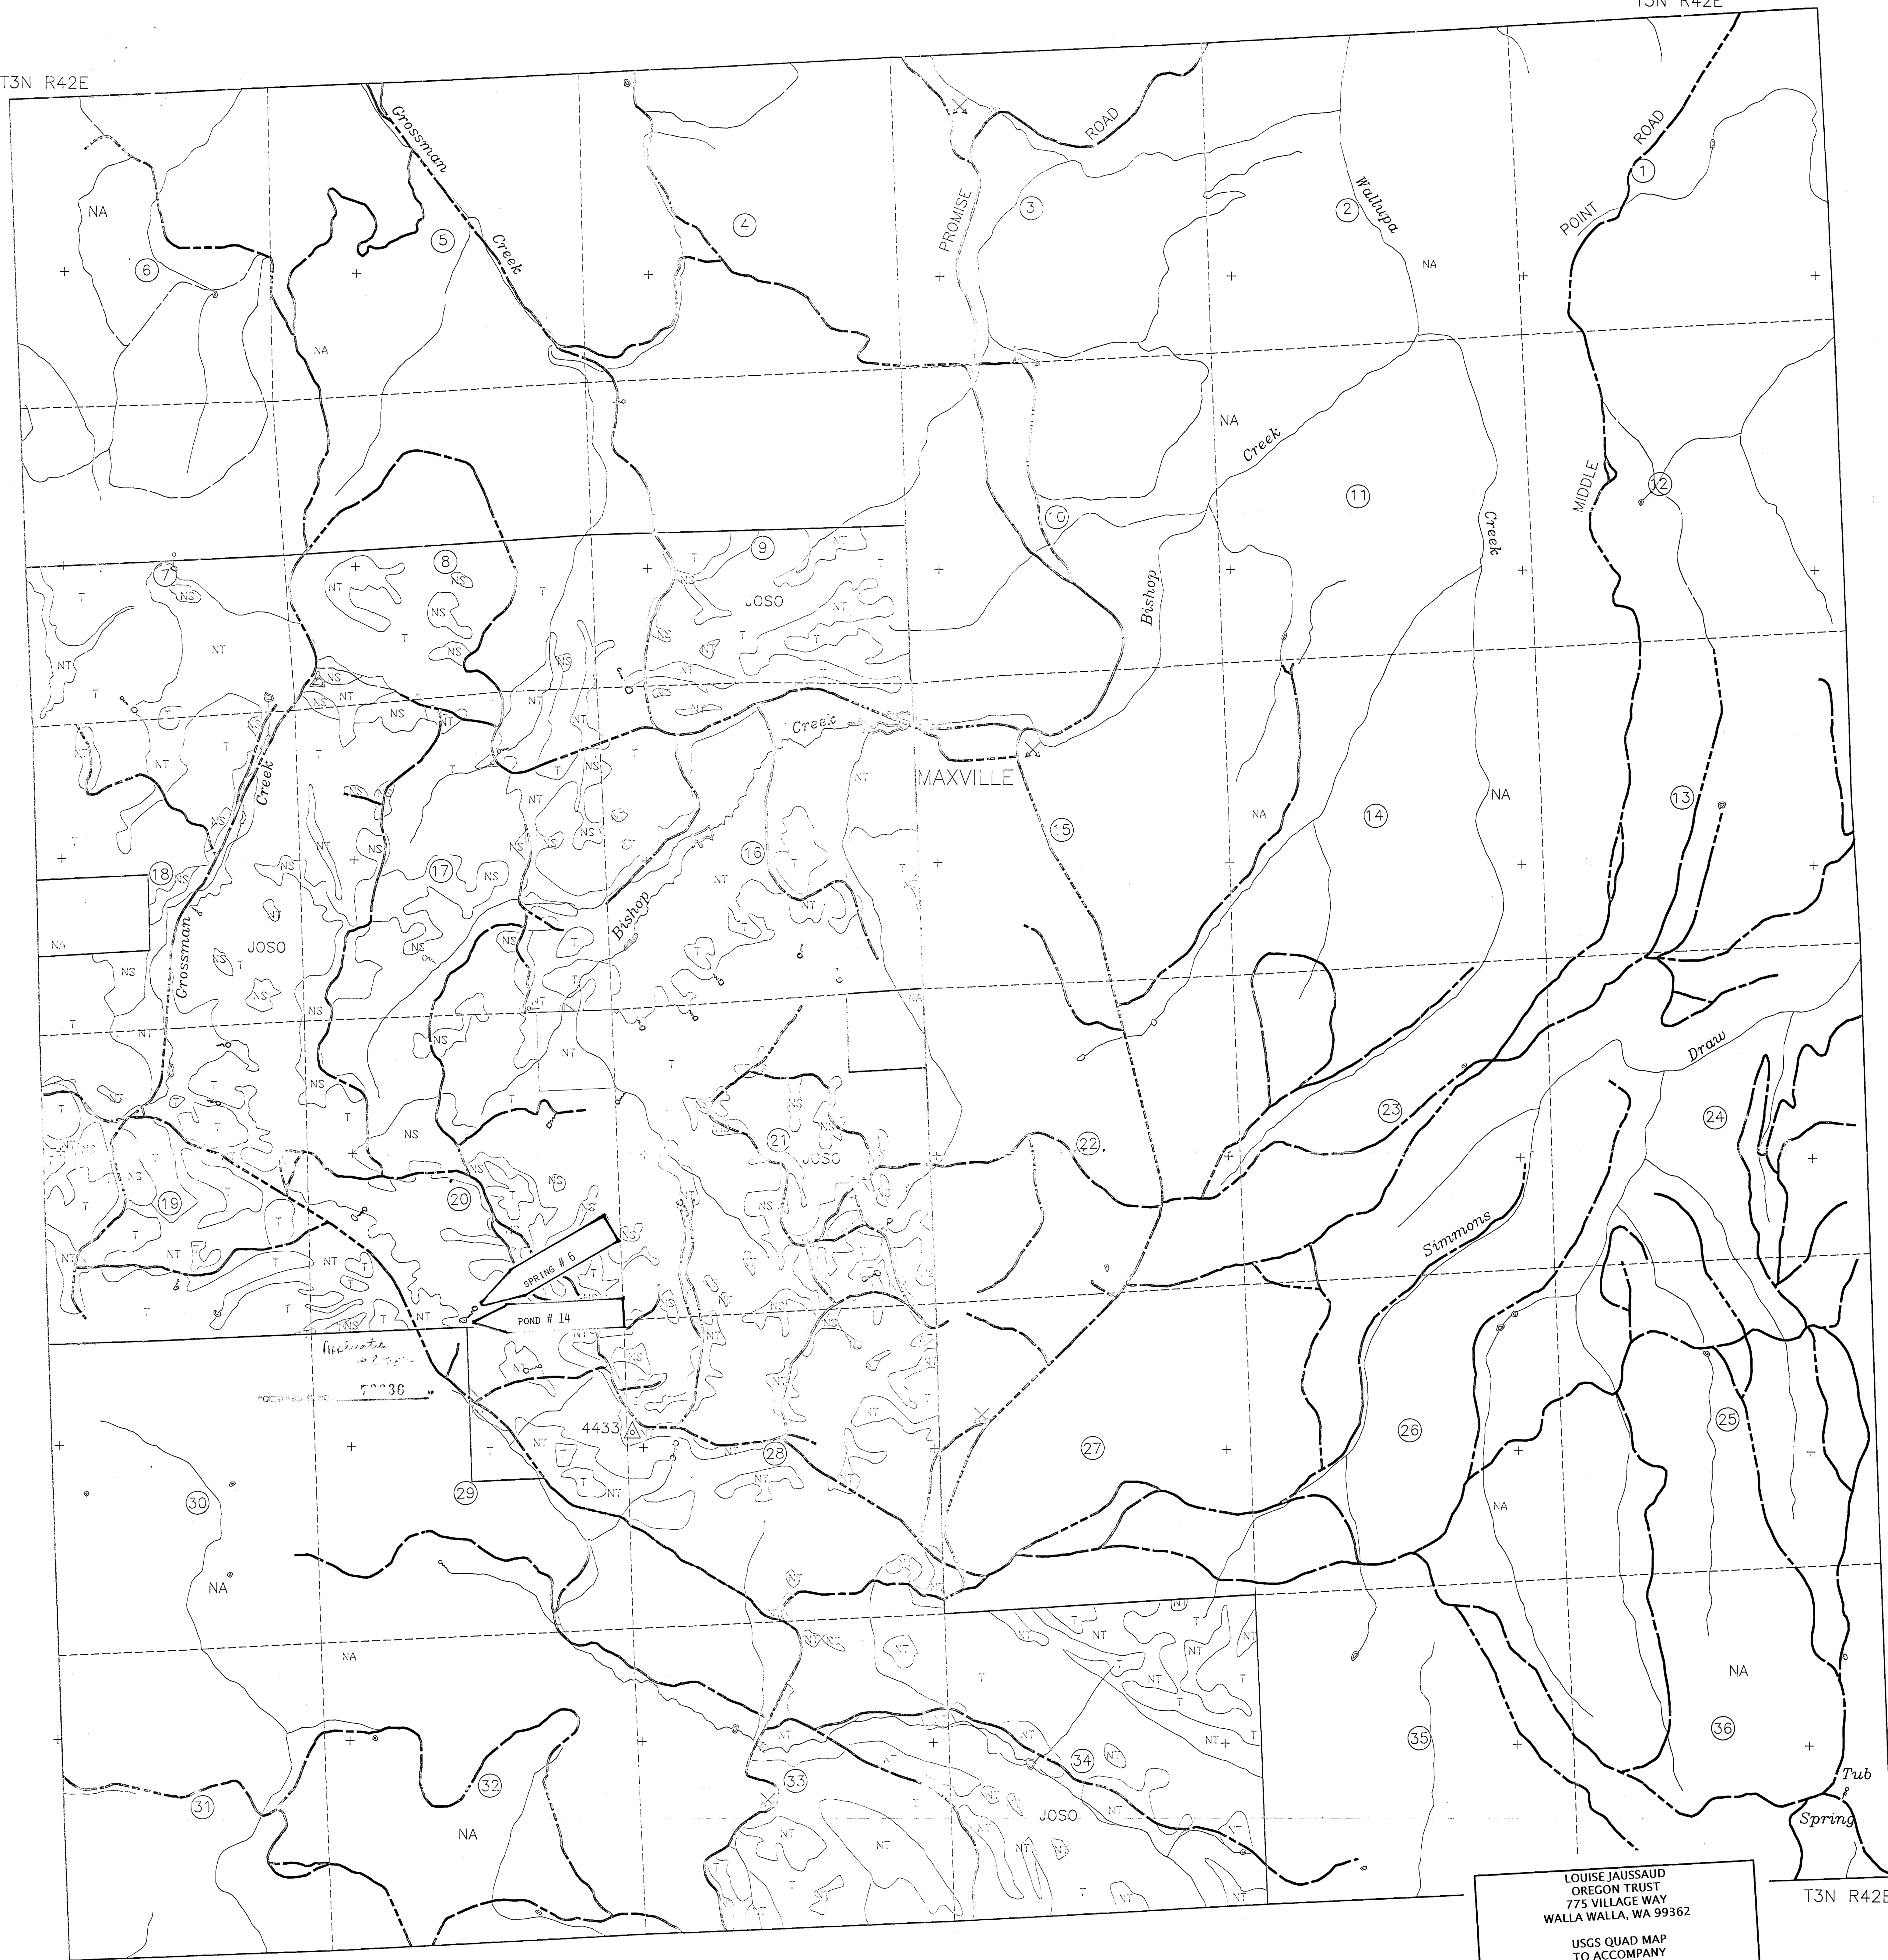

TIMBERLAND TYPECALL INDEX	
T	TIMBERED : Greater than 10% crown cover.
NS	NON-STOCKED TIMBERLAND : Less than 10% crown cover with evidence of logging activity.
NT	NON-TIMBERLAND : Less than 10% crown cover with no evidence of ability to support timber species due to shallow soil or meadow conditions.
NA	NON-APPLICABLE : Not within current ownership boundaries.

LEGEND	
Section Line	Interstate Route
Ownership	U.S. Route
Type Line	State Route
Primary Highway	
Secondary Highway	
Light Duty Road	
Unimproved Road	
Trail	
Railroad	
Powerline	
County Boundary	
Creek	
Class 1 Creek	
	X Gravel, sand, clay or borrow pit
	X Quarry or open pit mine
	X Horizontal Control Bench Mark
	X Vertical Control Bench Mark

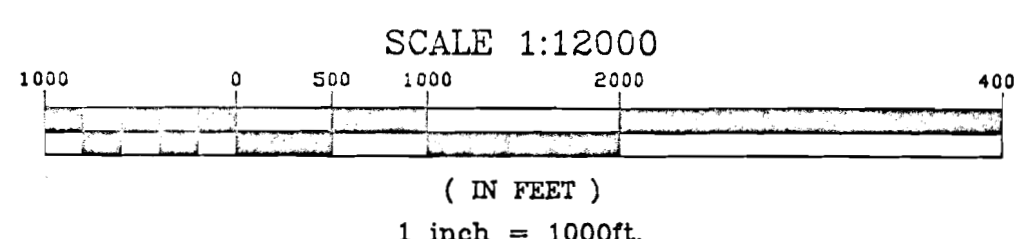

LOUISE JAUSSAUD
OREGON TRUST
775 VILLAGE WAY
WALLA WALLA, WA 99362

USGS 7.5' Quads:
Promise 1966, Field Checked 1967
Akers Butte 1959, Photorevised 1984

Oregon Trust Application # 5

Application for a Permit to
Appropriate Surface Water.

JOSO RANCH

Timberland Acreage Delineation

Wallowa County, State of Oregon

TOWNSHIP 3N, RANGE 42E

Prepared for: LEWIS M. WORK & ASSOCIATES

By: ATTERBURY CONSULTANTS, INC.
Beaverton, Oregon
Sept. 1991, MJB

No Final Proof Map available

No Permit Map available