


Permit No. 70639
G. C. MILLER

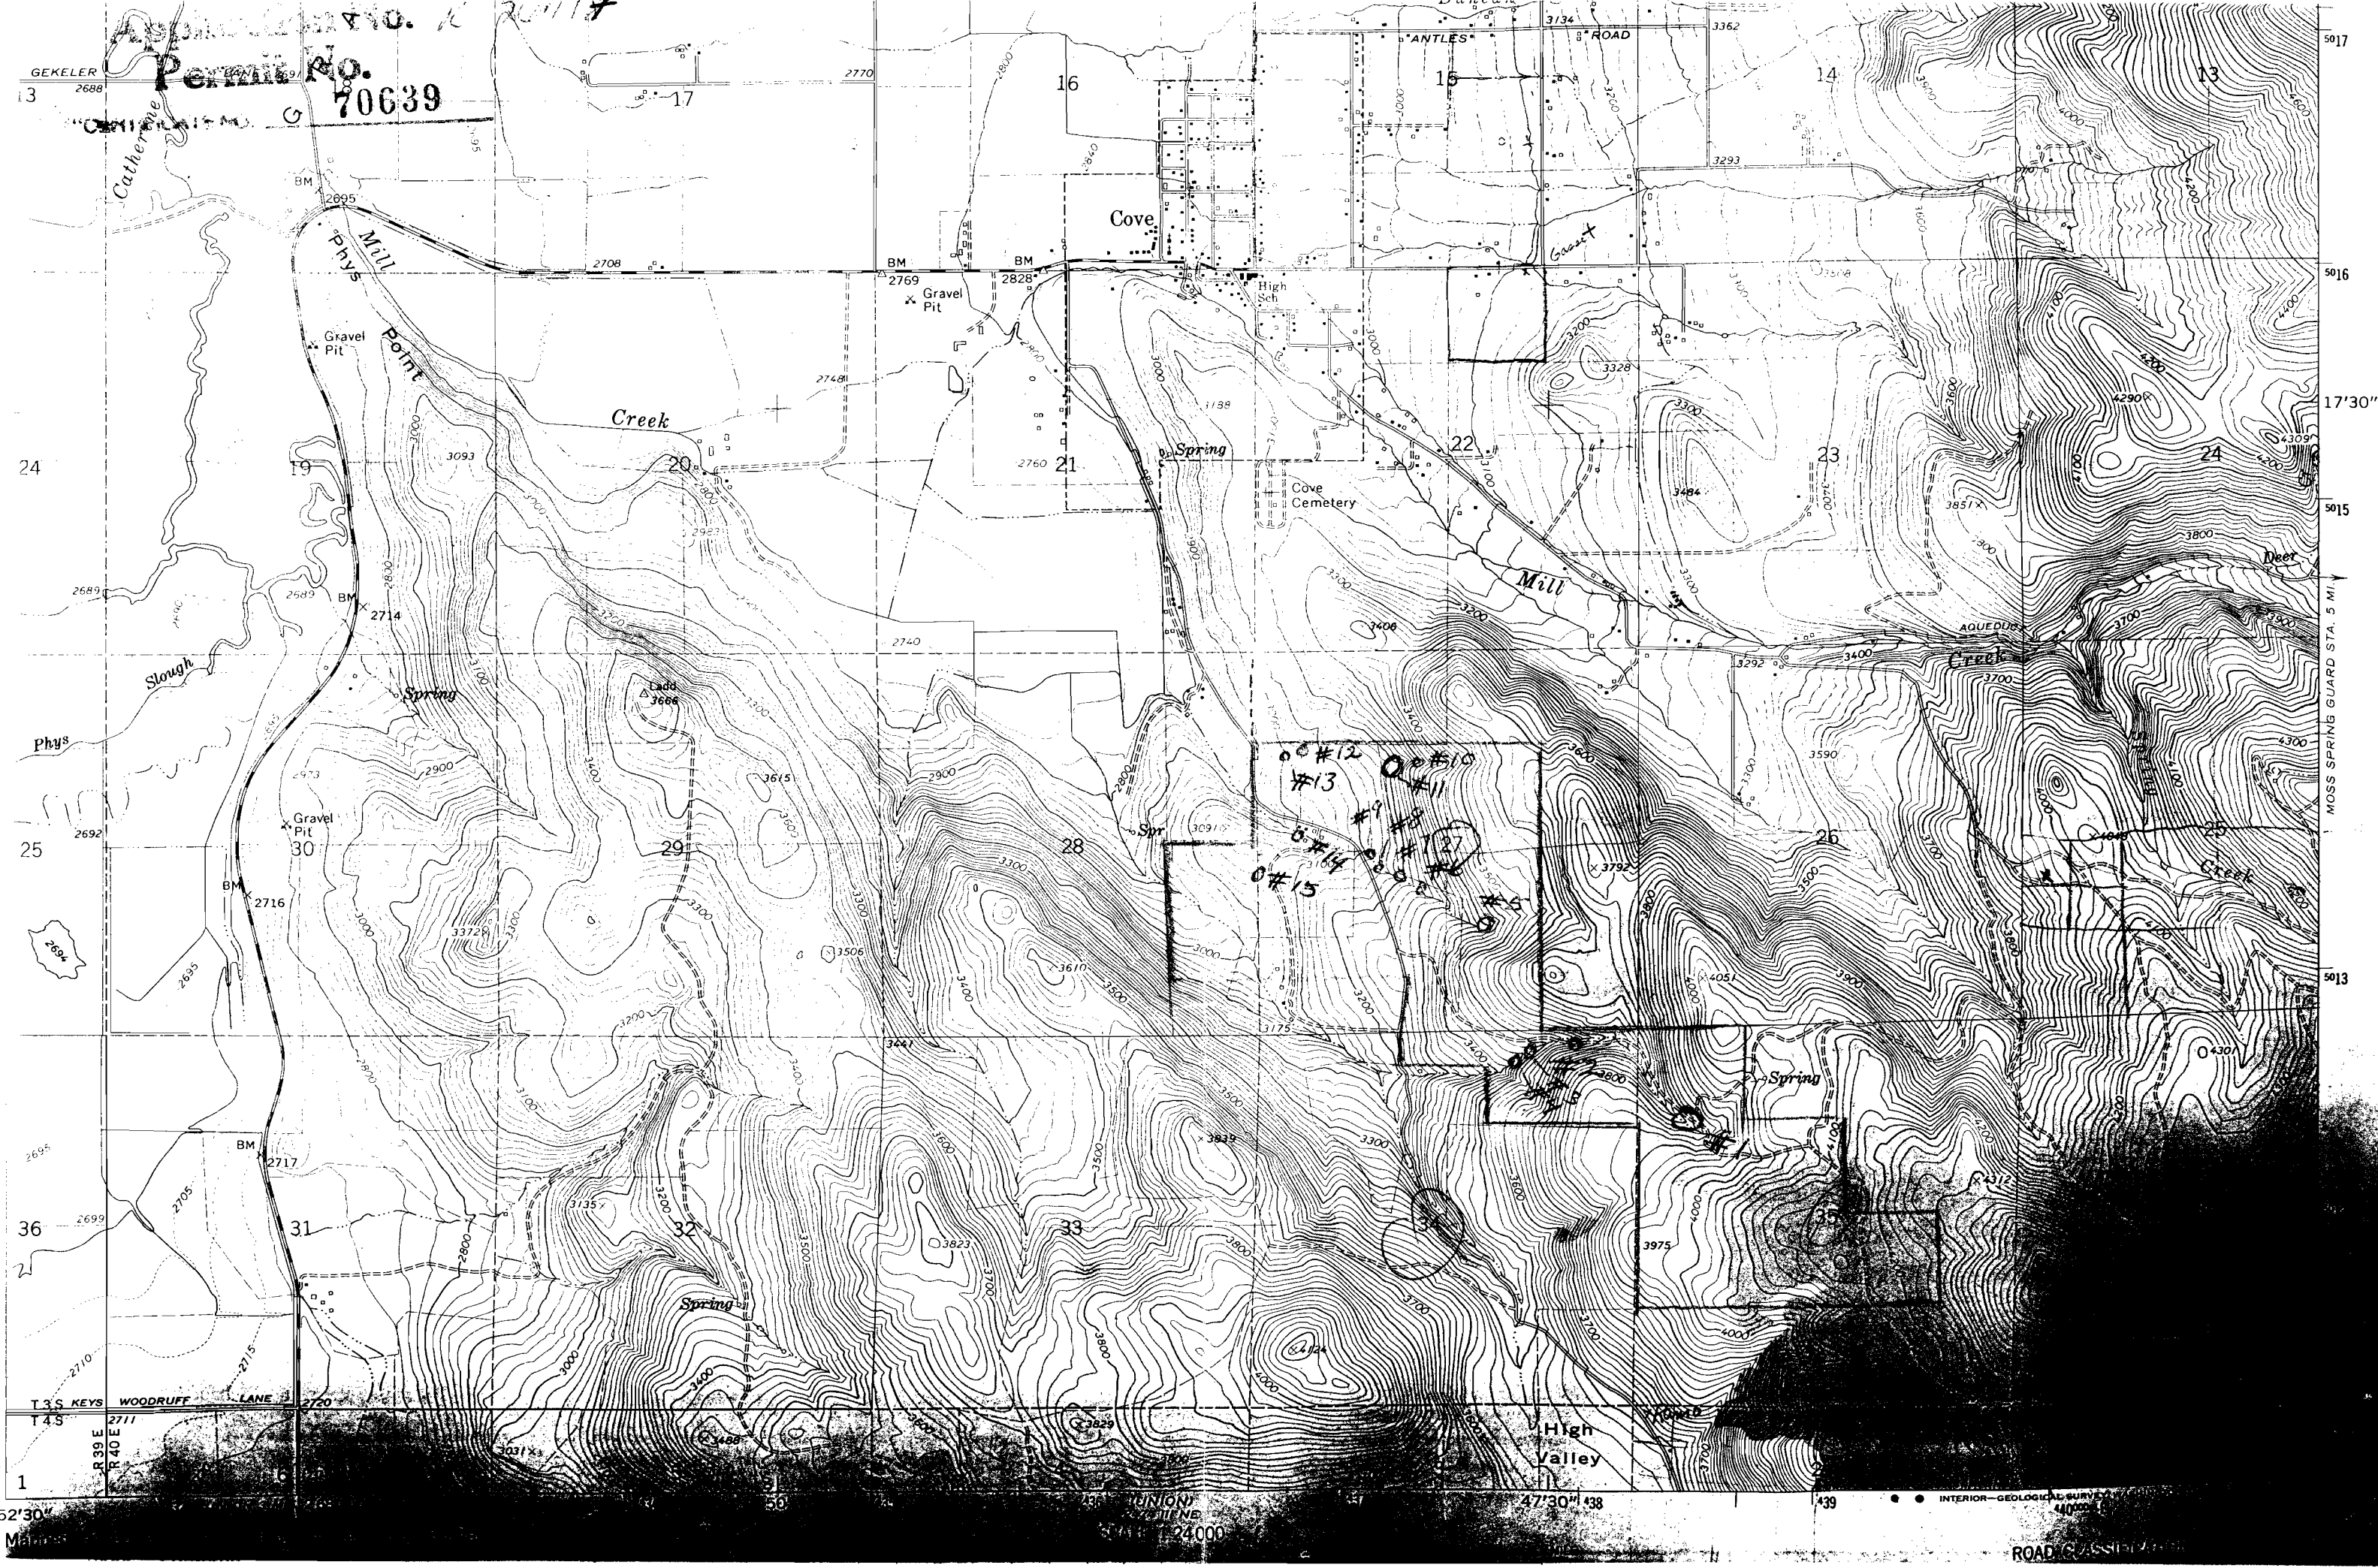

3

24

25

36

1

5017

5016

17'30"

5015

5014

5013








Cove

Spring

Mill

Creek

Deer

Creek

High Valley

#12
#13
#14
#15

T. 3 S. KEYS WOODRUFF LANE

R. 39 E R. 40 E

UNION

24000

47'30" 438

439

INTERIOR-GEOLOGICAL SURVEY

ROAD CLASSIFICATION

No Final Proof Map available

No Permit Map available