


9770

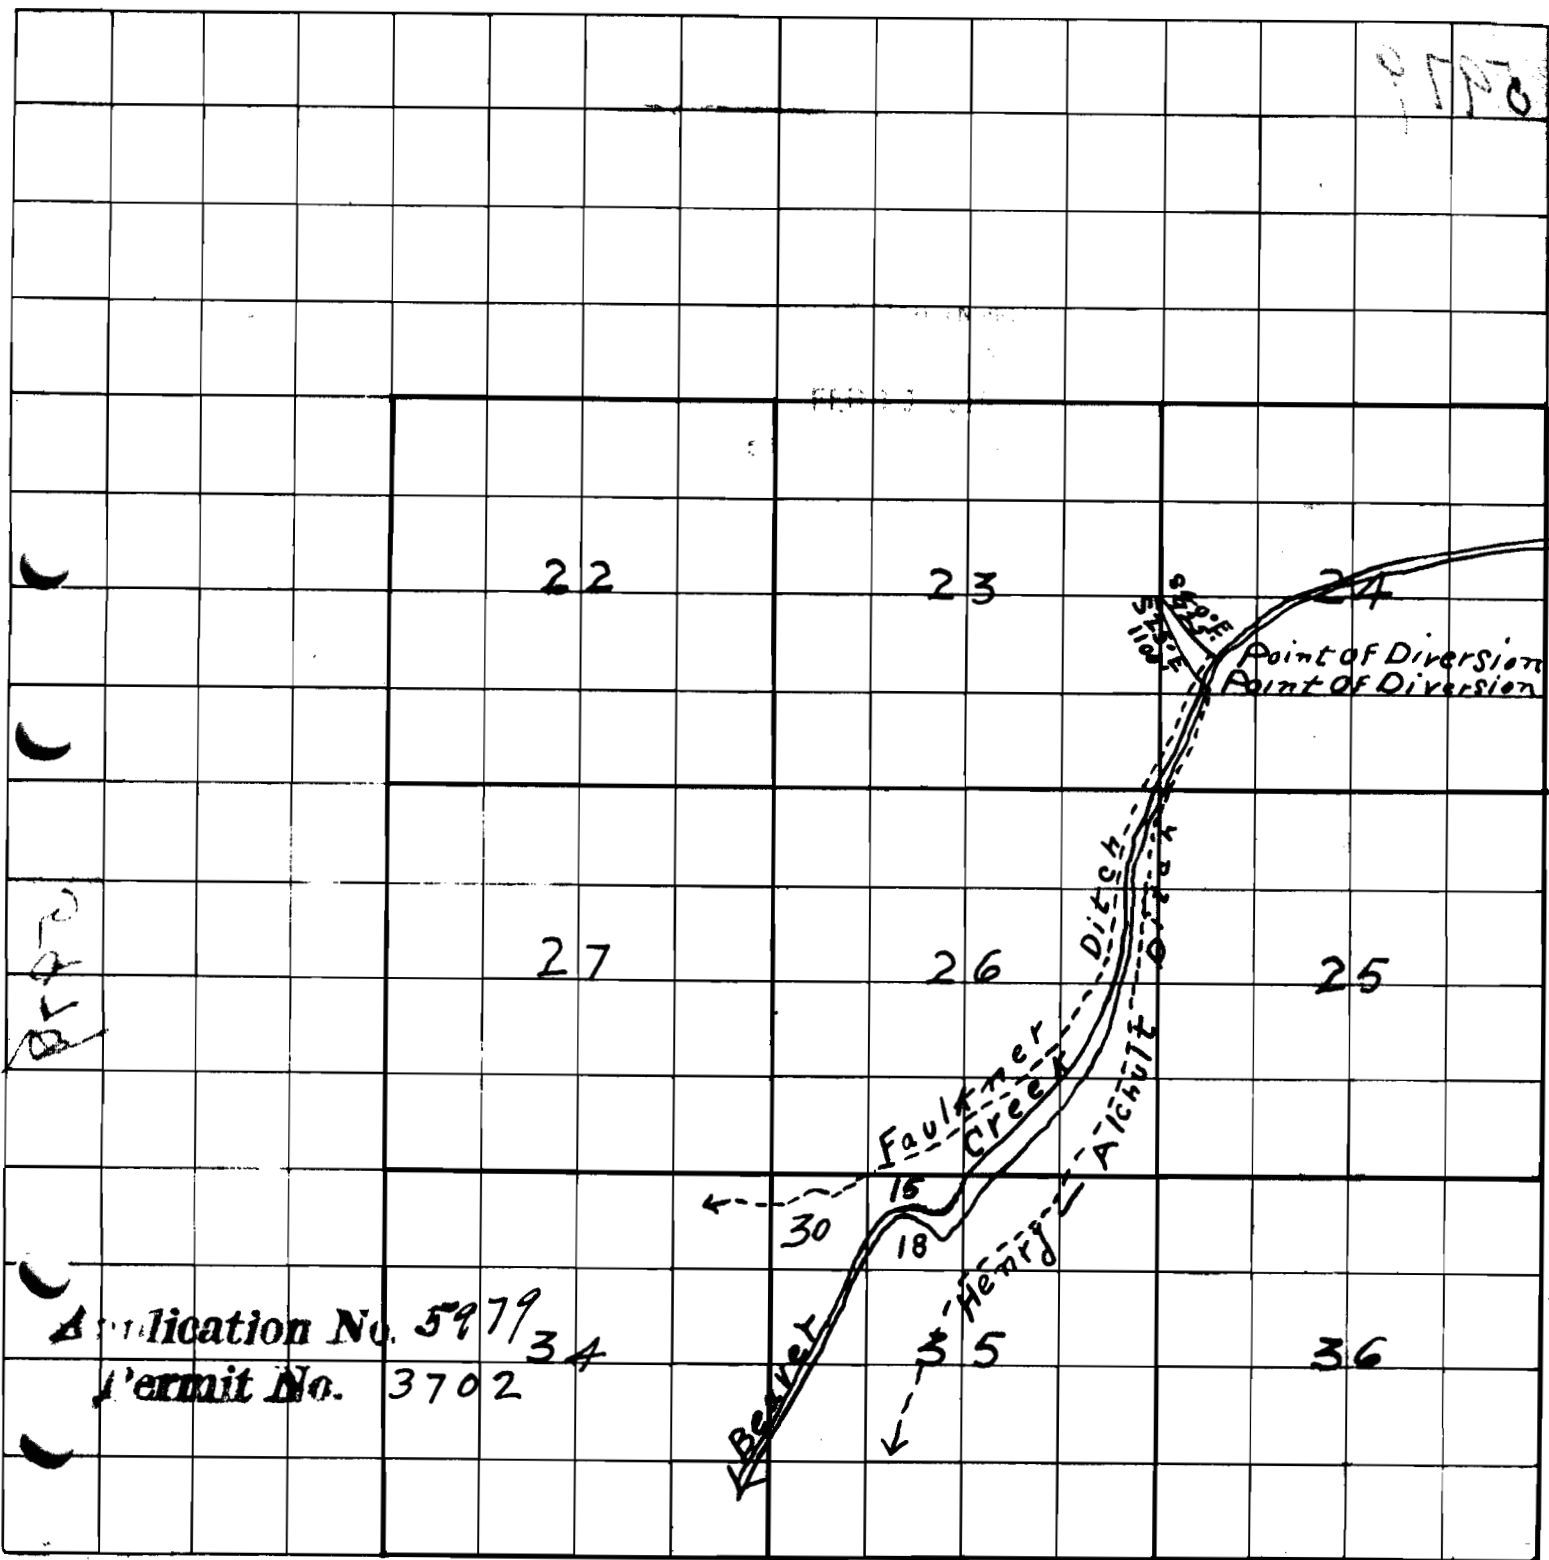

Application No. 5979  
Permit No. 3702

2810

3702