


(PARAL 2375 1

SHOULD BE 5 NORTH
↓

Township 55
Range 44E
Section 24

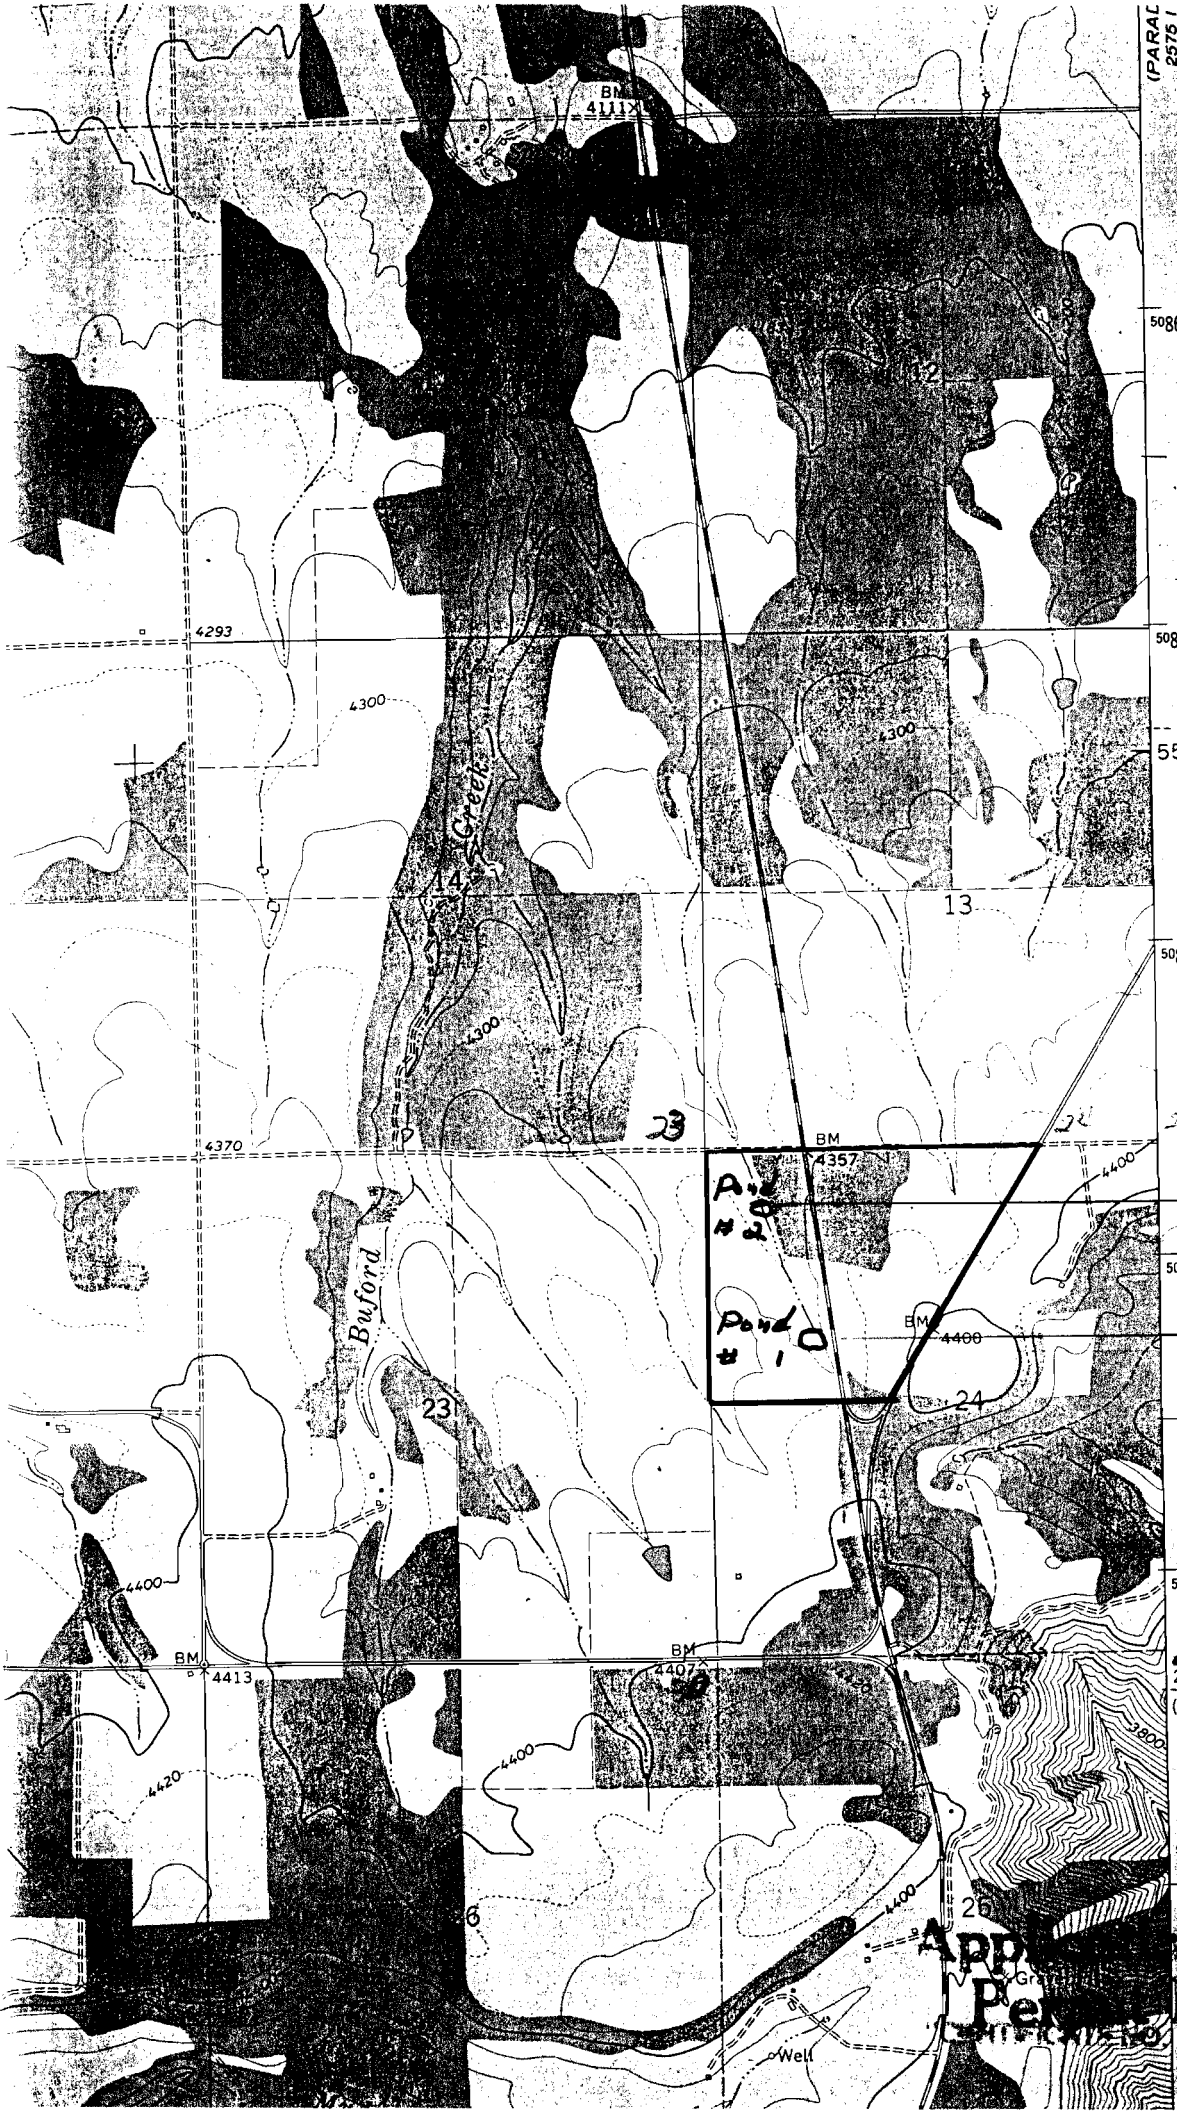

220 000 FEET
(WASH.)

App. No. R-706718
Pet. No. 70640