


Application No. R-76723
Permit No.

"CERTIFICATE NO. 70645"

PROPERTY OWNED BY WALDO M. CLAFLIN
93771 Sam Brown Rd.
Blachly, OR, 97412

The SE quarter of the SW quarter except the west
330 feet thereof, and the South Half of the SE quarter,
all in Section 4, Township 16 South, Range 7 West,
of the Willamette Meridian, in Lane Cty, Oregon.

ALSO: The NE quarter of the NW quarter except the west
330 feet thereof, and the NW quarter of the NE
quarter all in Section 9, Township 16 south,
Range 7 West of Willamette Meridian, all in Lane
County, Oregon.

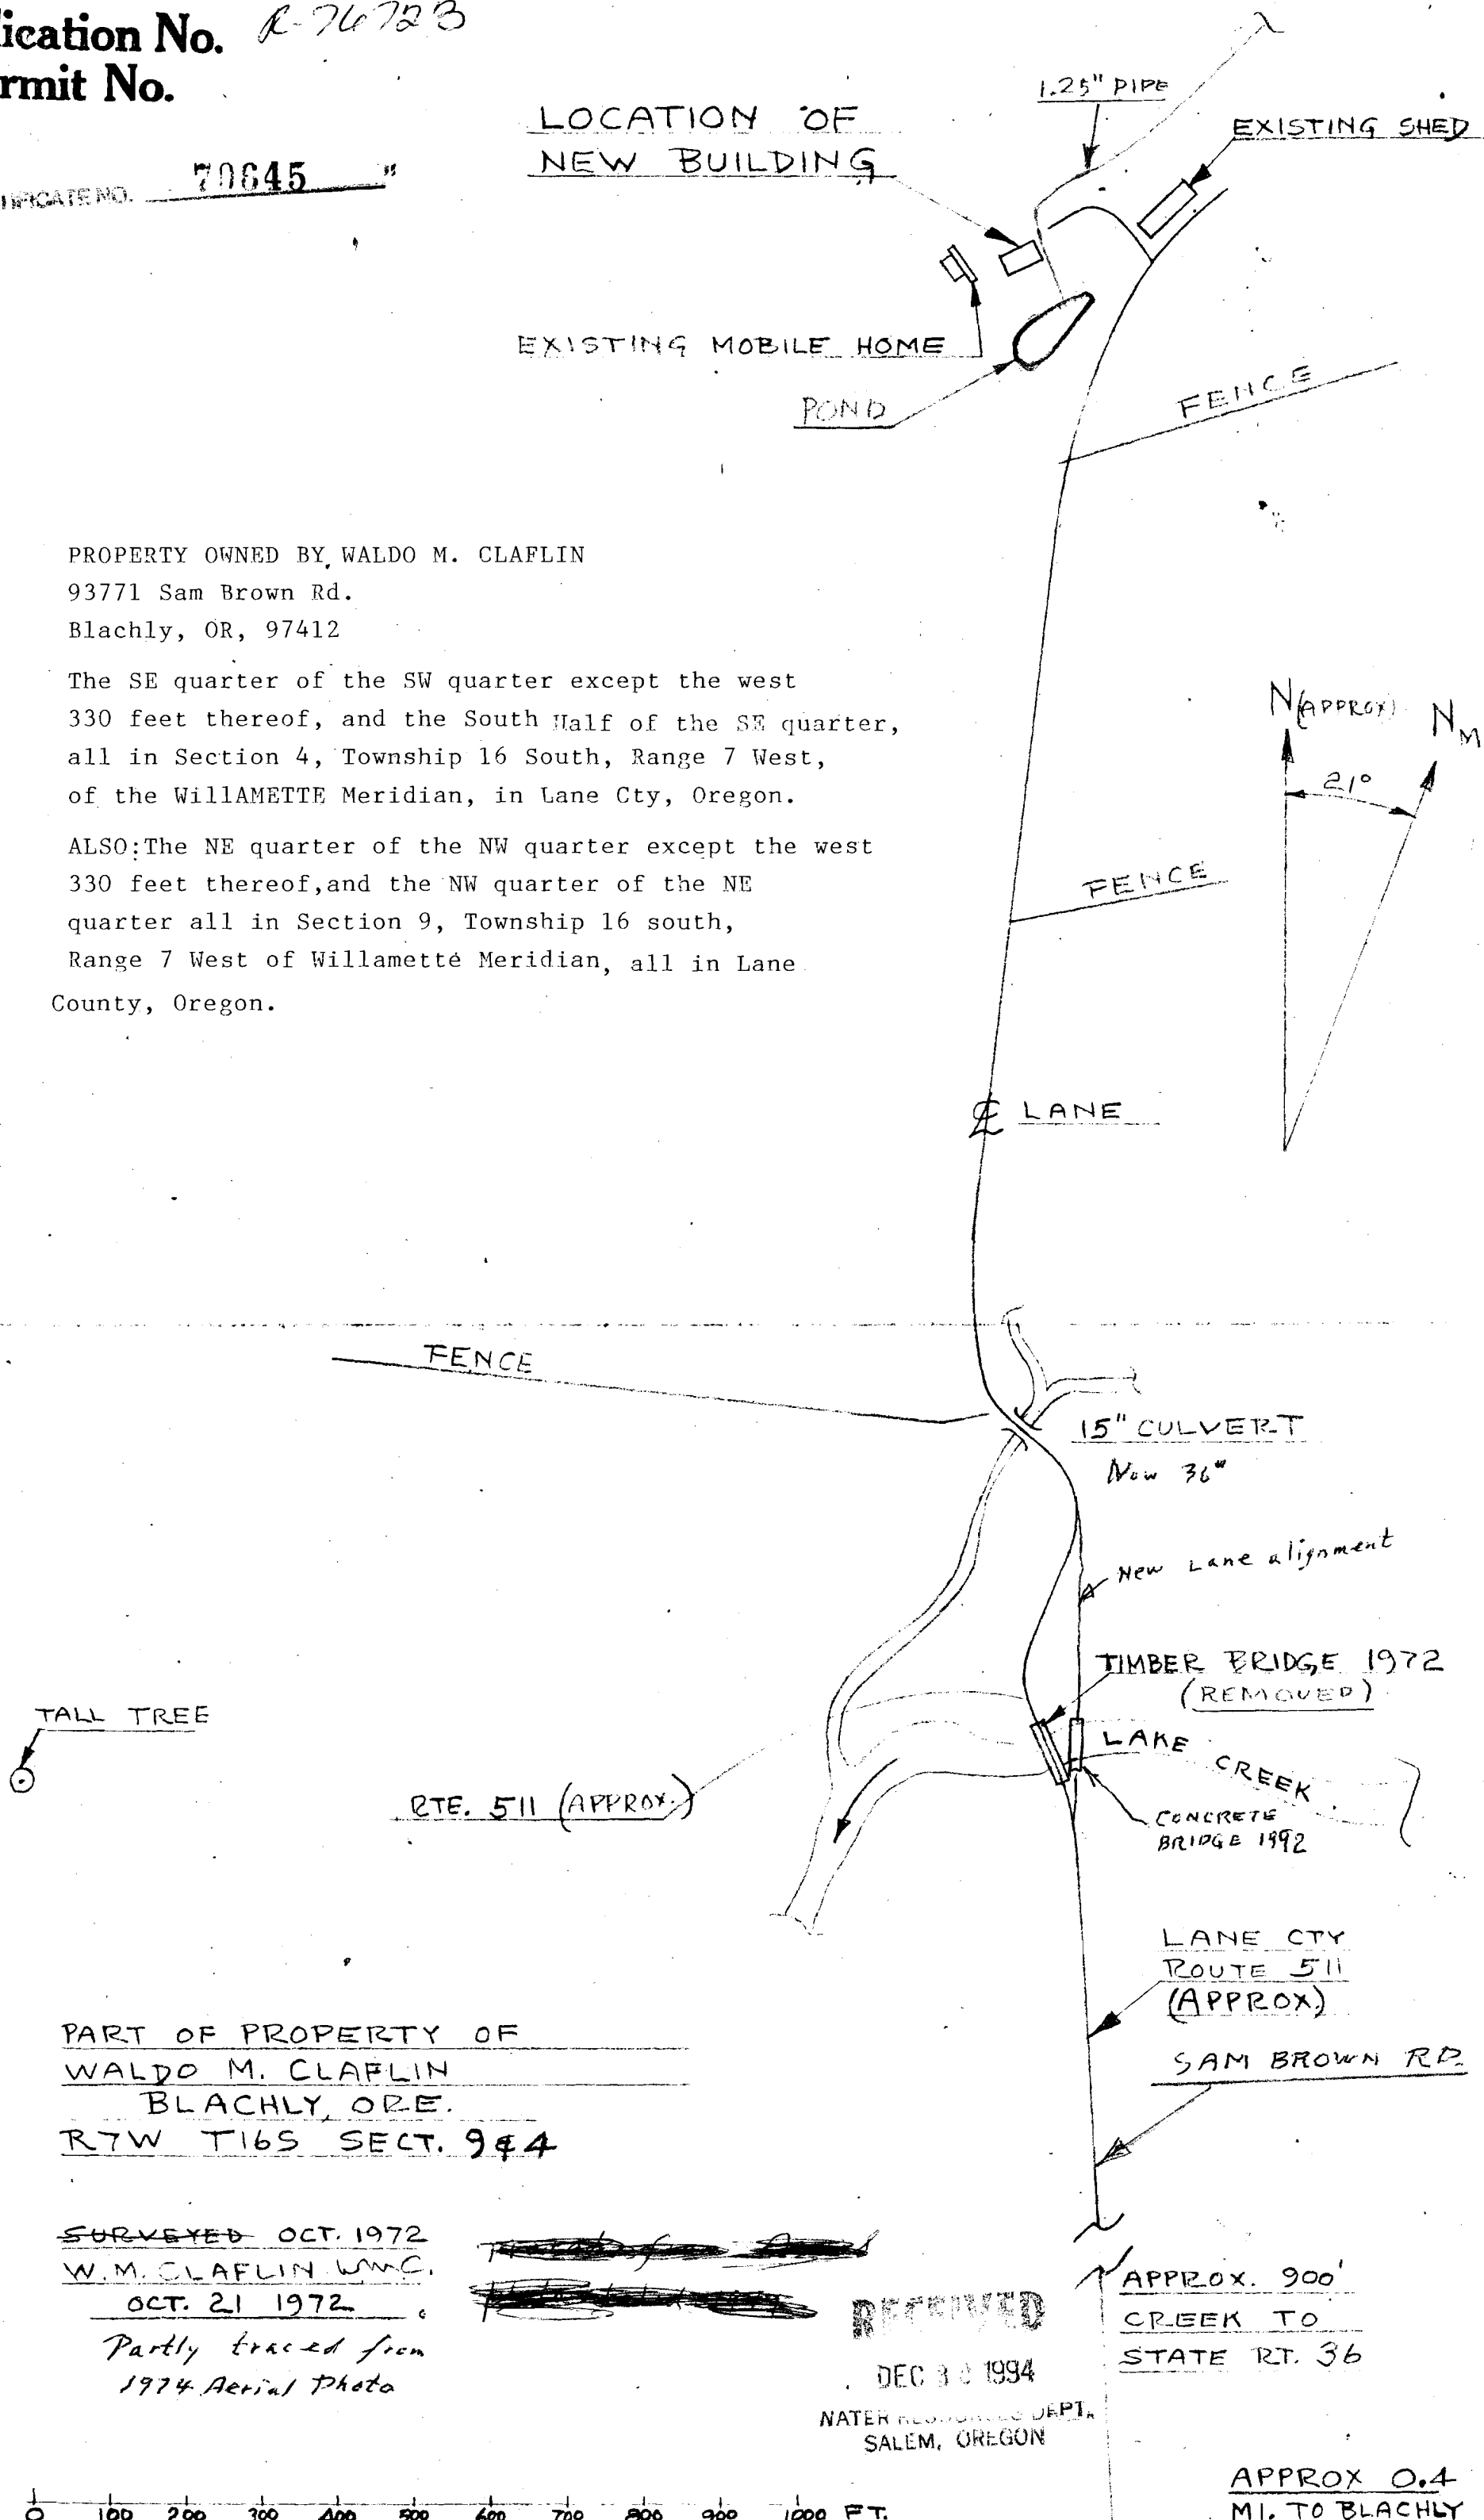

PART OF PROPERTY OF
WALDO M. CLAFLIN
BLACHLY, ORE.
RTW T16S SECT. 9&4

SURVEYED OCT. 1972
W.M. CLAFLIN WMC.
OCT. 21 1972
Partly traced from
1974 Aerial Photo

RECEIVED
DEC 30 1994
WATER RESOURCES DEPT.
SALEM, OREGON

APPROX. 900'
CREEK TO
STATE RT. 36

APPROX 0.4
MI. TO BLACHLY

0 100 200 300 400 500 600 700 800 900 1000 FT.

No Final Proof Map available

No Permit Map available