


R-76734

70658

CERTIFICATE NO.

FOX QUADRANGLE
OREGON-GRANT CO.

7.5 MINUTE SERIES (TOPOGRAPHIC)

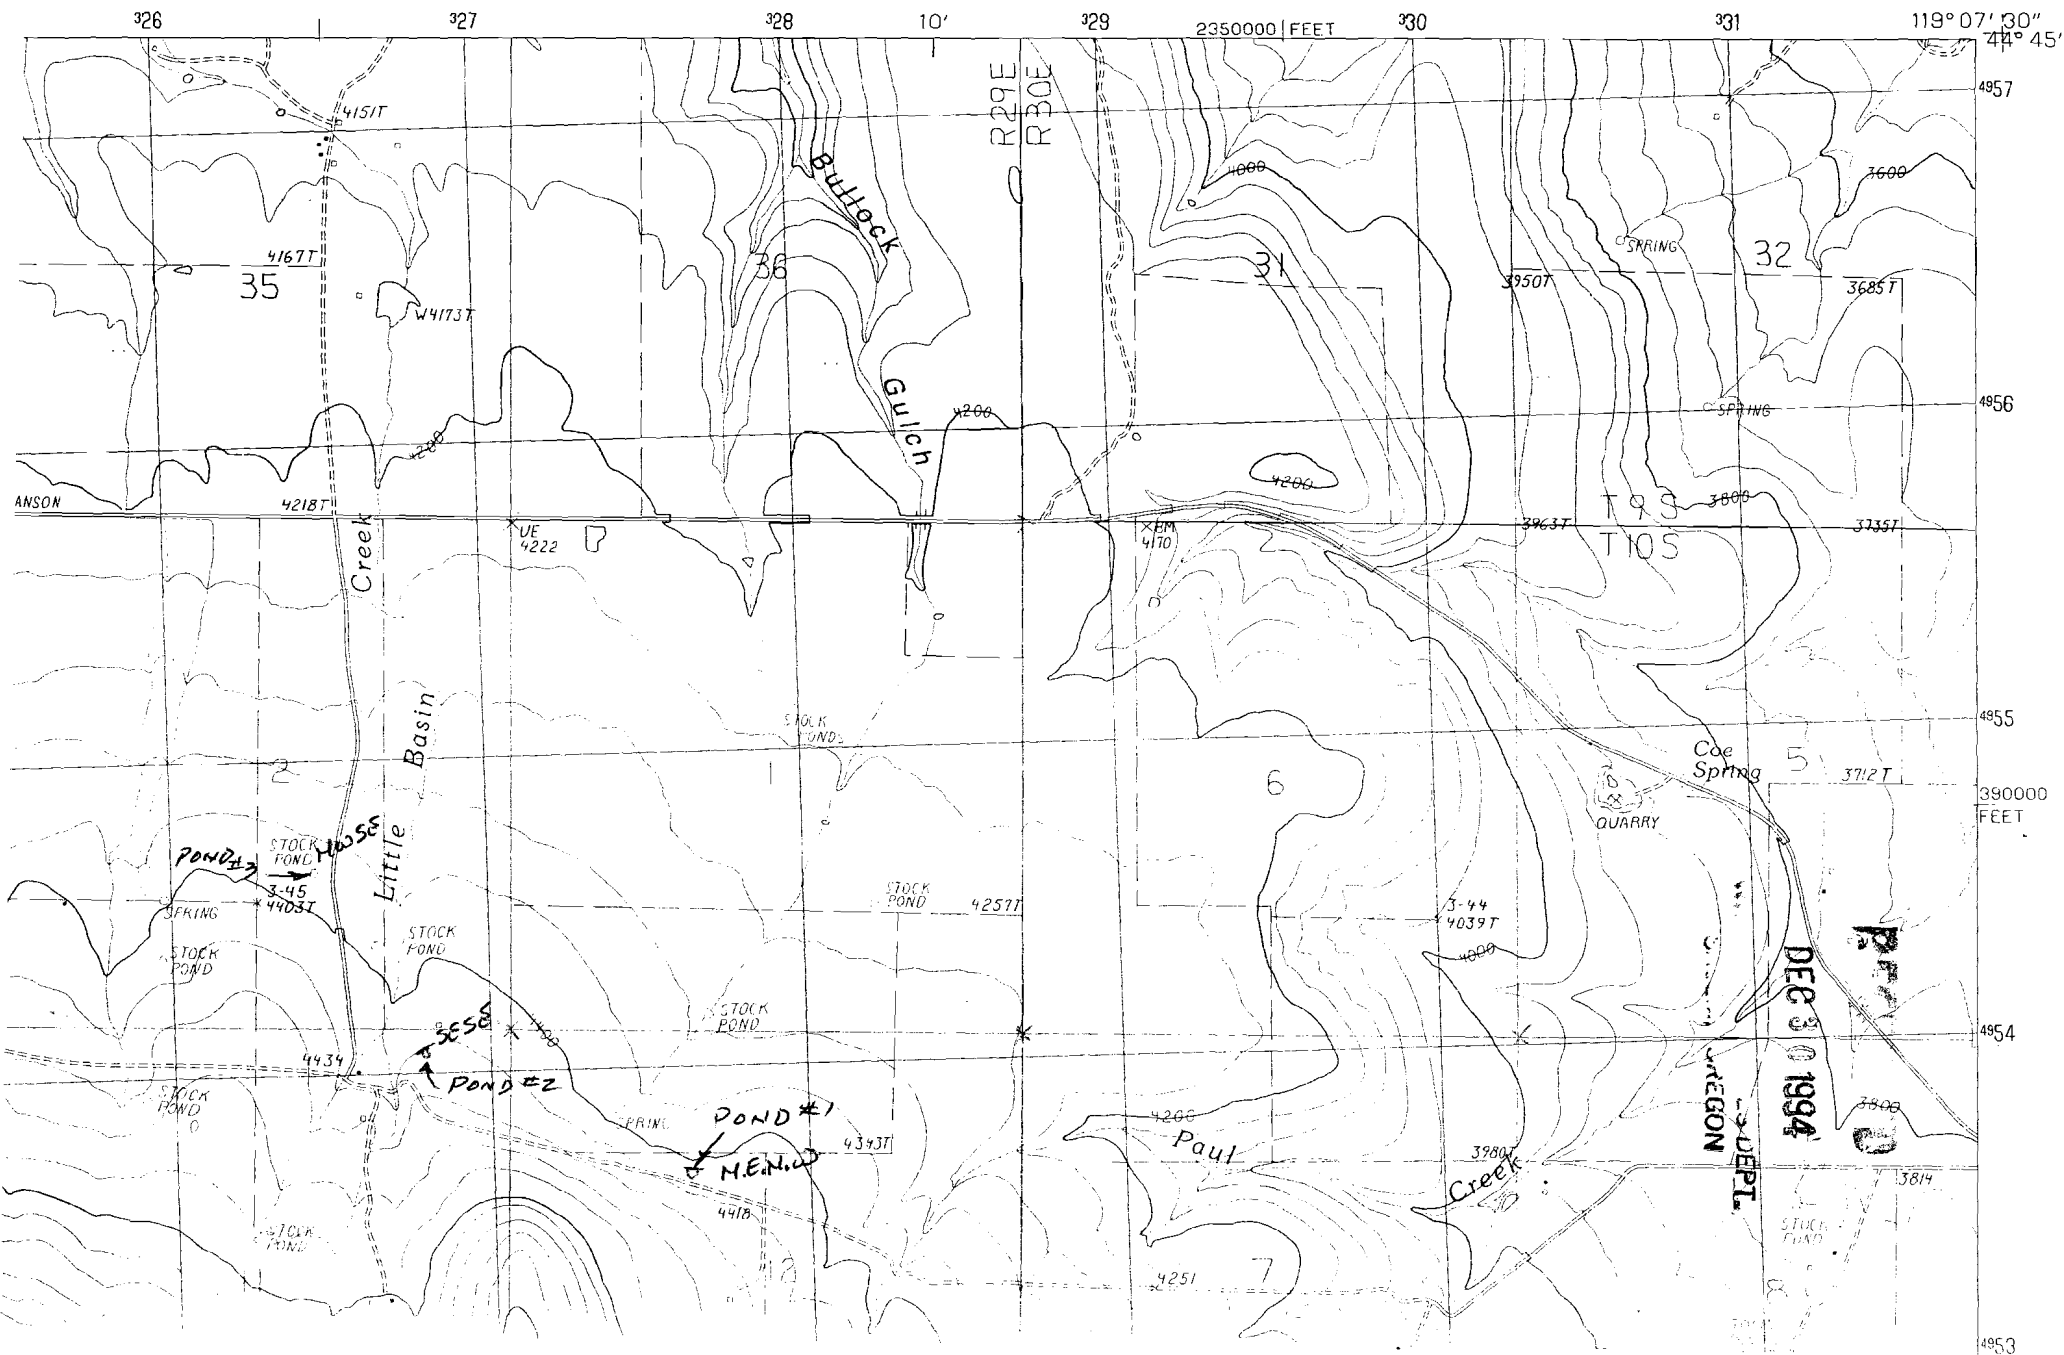

No Final Proof Map available

No Permit Map available