

R. 10 E.

R. 11 E.

R. 12 E.

1

2

121°22'30"

LA PINE 12 MILES

15'

T. 24 S.

A

T. 25 S.


43°
22'
30"

B

T. 26 S.

15'

T. 27 S.

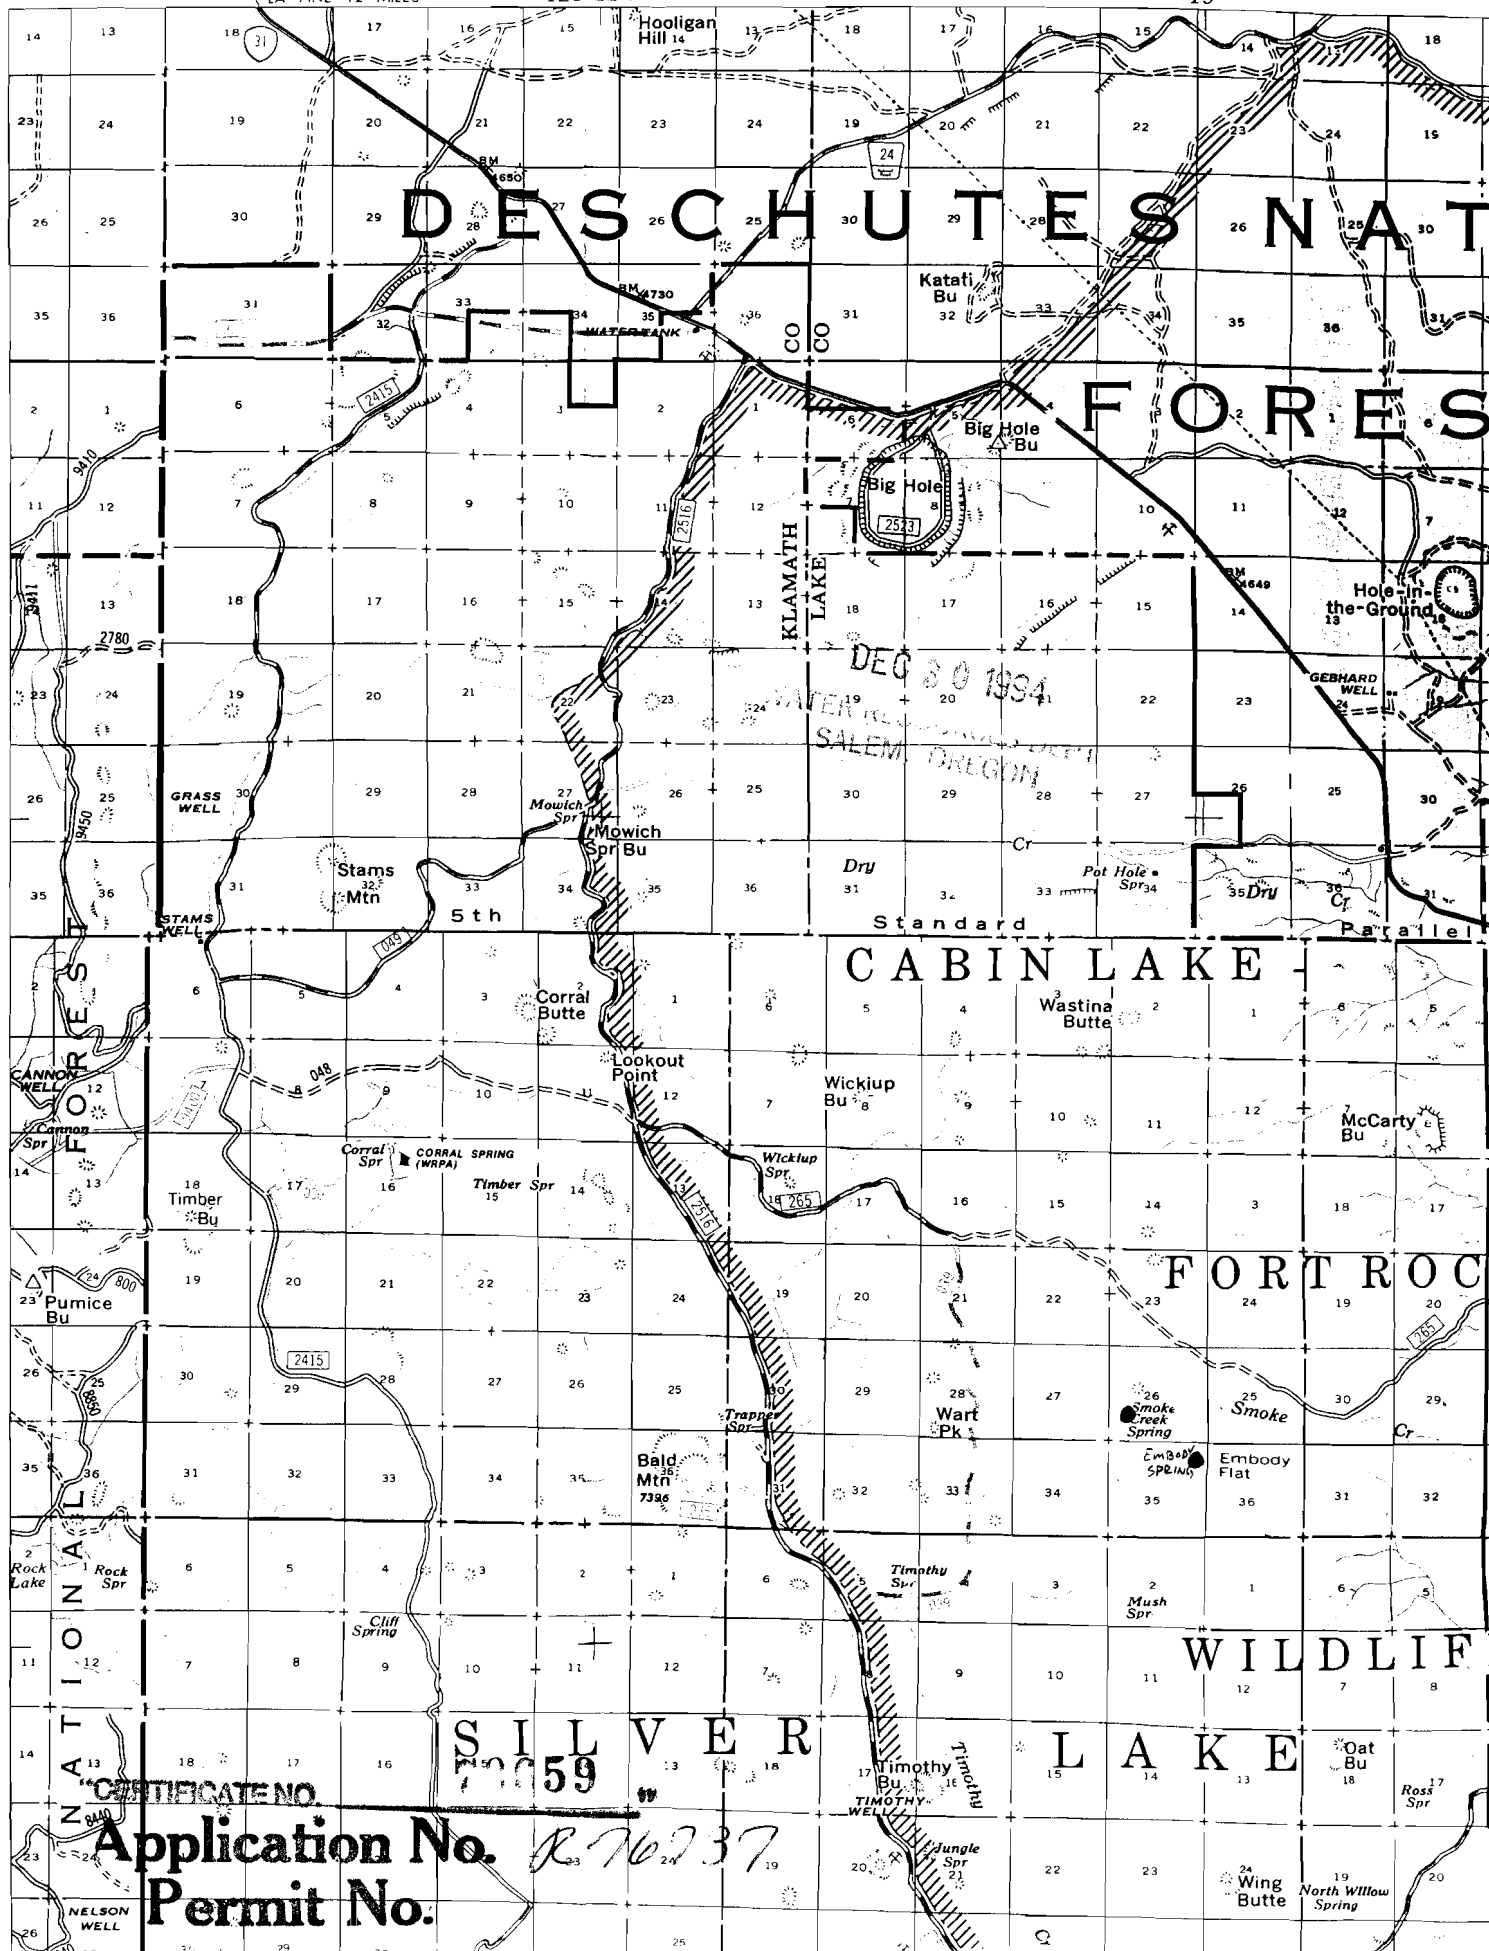

No Final Proof Map available

No Permit Map available