


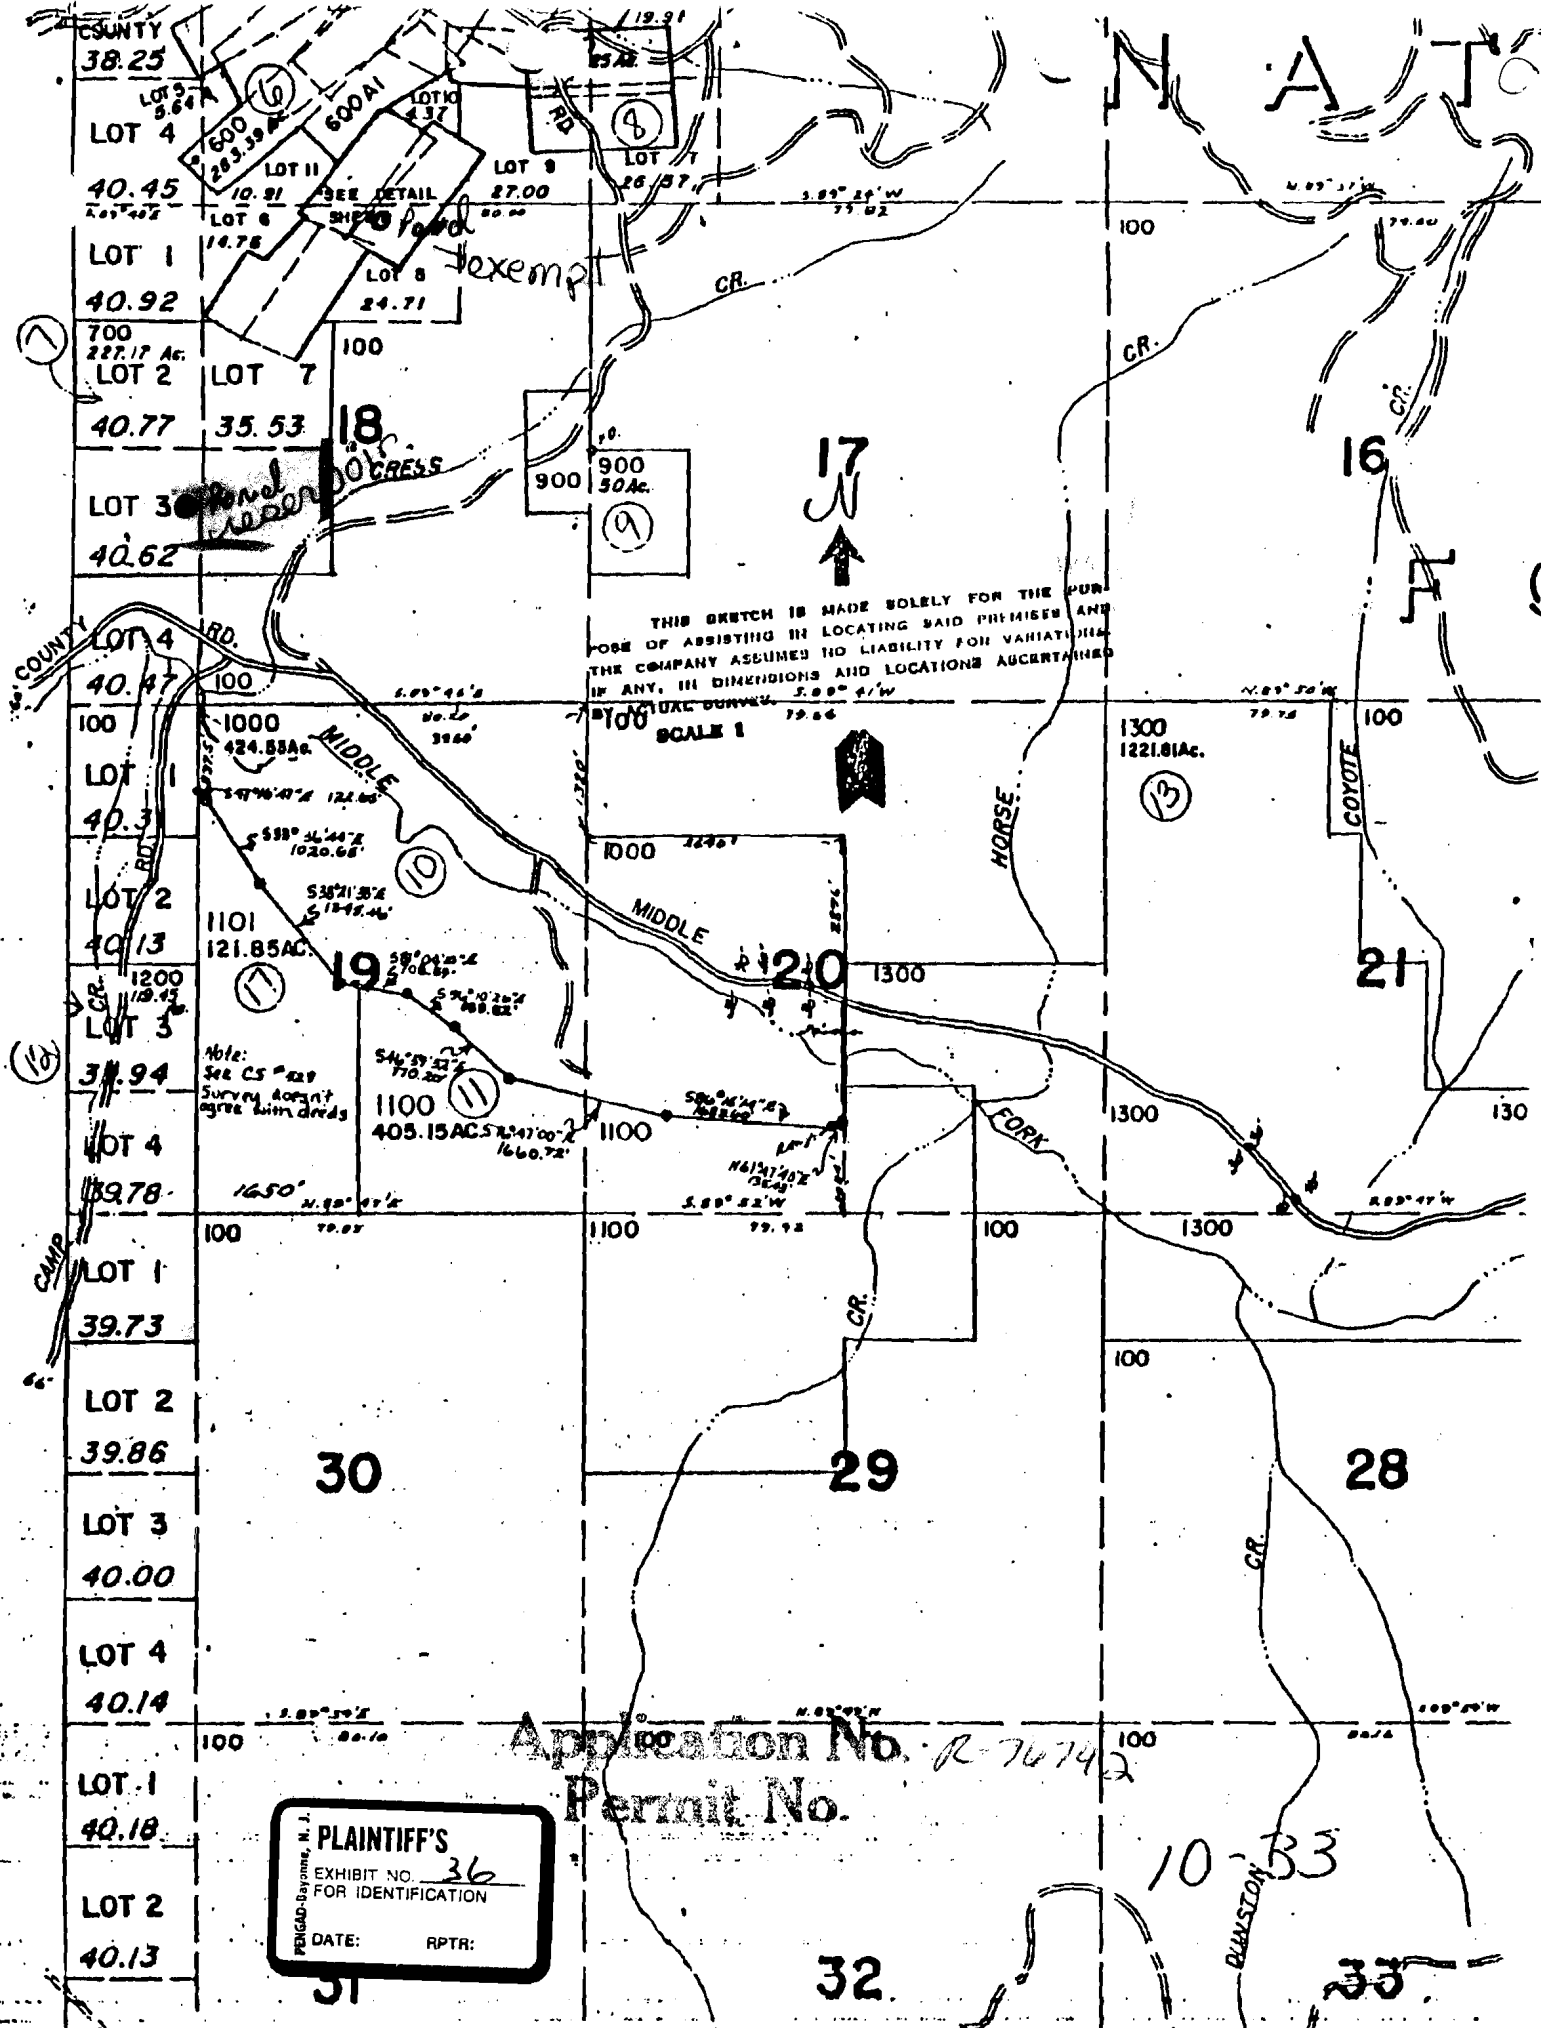

Application No. R-76742
Permit No.

PLAINTIFF'S
EXHIBIT NO. 36
FOR IDENTIFICATION
DATE: RPTR:

10-33

32

33

No Final Proof Map available

No Permit Map available