


2000 2000 4000
ET
KILOMETER

Application No. R-76746
Permit No.

CERTIFICATE NO. 70368

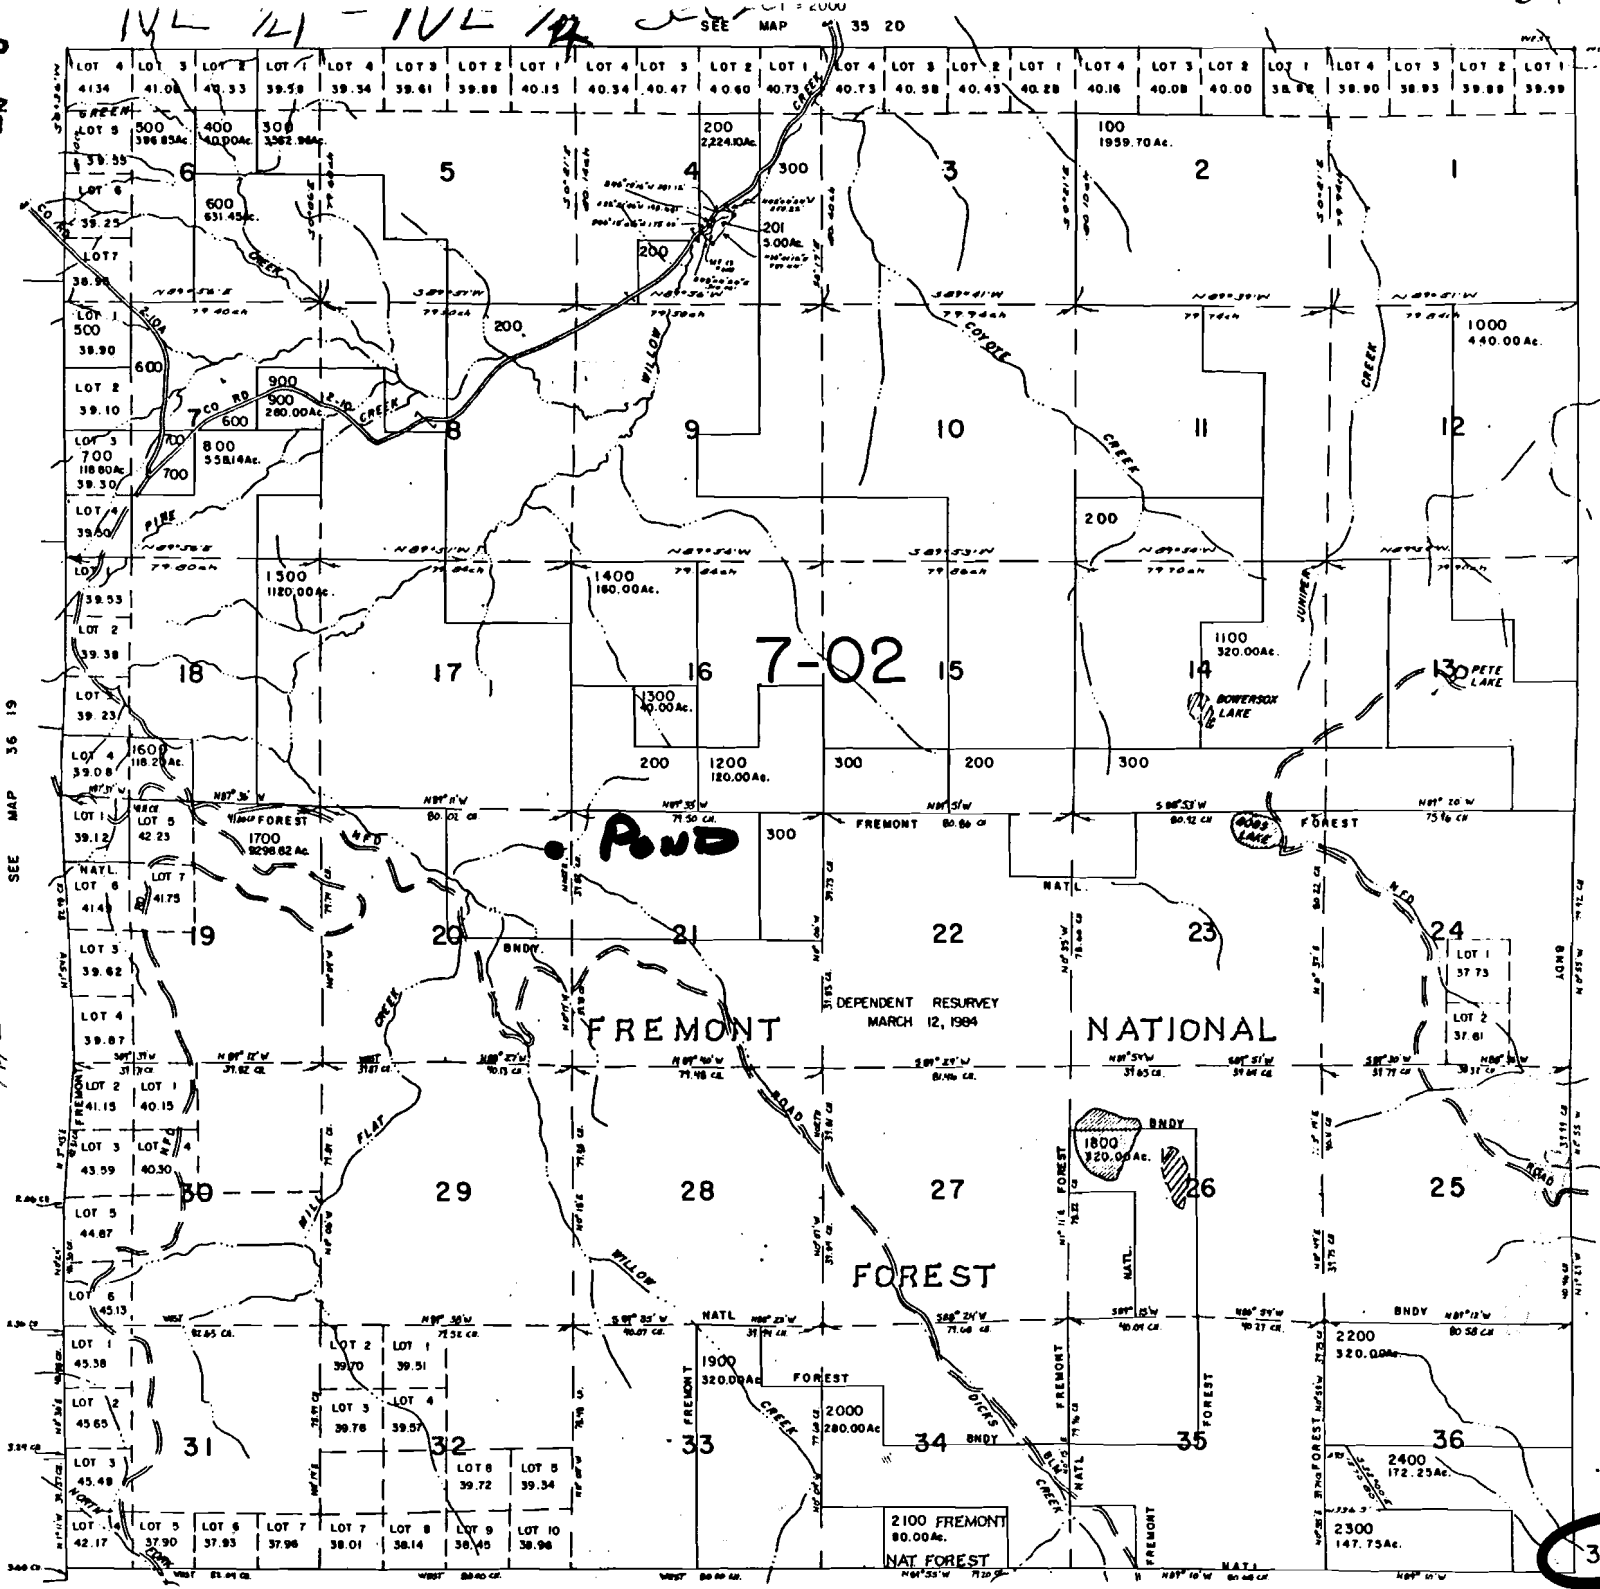

36 20

photo taken - 7/90 ASSS-myh

V-42

Application No. R-76746
Permit No.

CERTIFICATE NO. 100298

17 16
20 21

6

No Final Proof Map available

No Permit Map available