


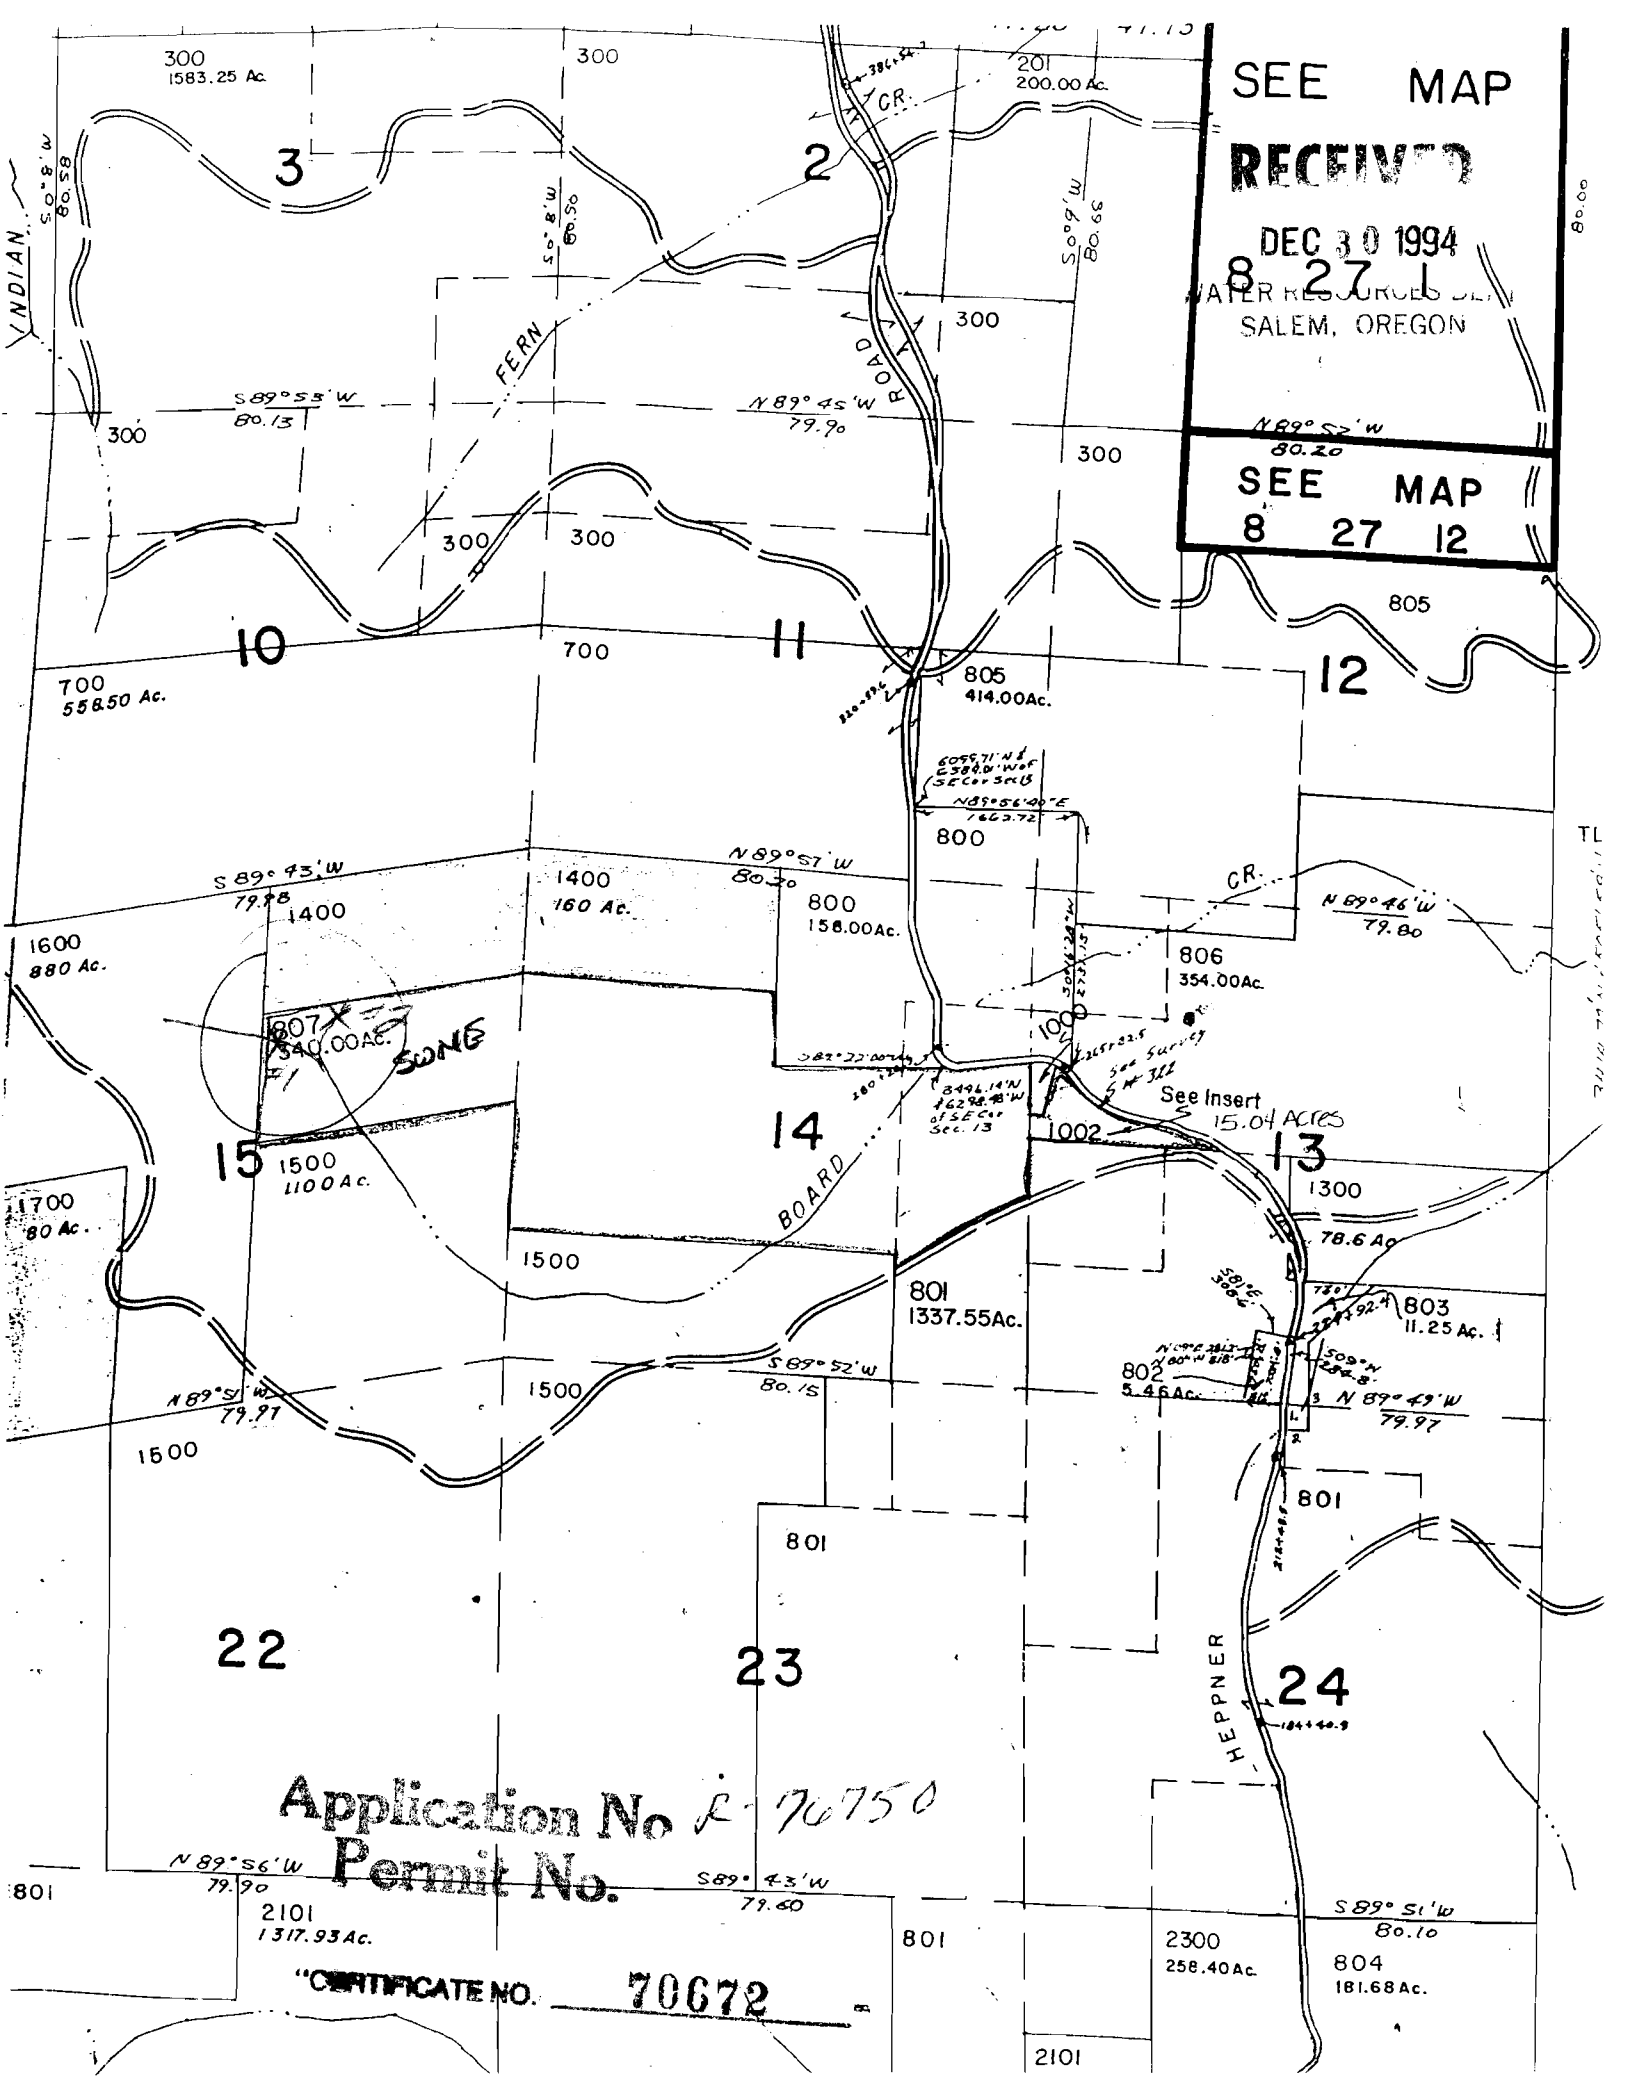

SEE MAP

RECEIVED

DEC 30 1994

8 27 12
WATER RESOURCES DIV
SALEM, OREGON

SEE MAP

8 27 12

Application No. 70750
Permit No.

CERTIFICATE NO. 70672

No Final Proof Map available

No Permit Map available