


CERTIFICATE NO. **70676**

RECEIVED
 FEB - 2 1996
 CLERK OF DISTRICT COURT
 SALEM, OREGON

SEE MAP 2N 10 25B

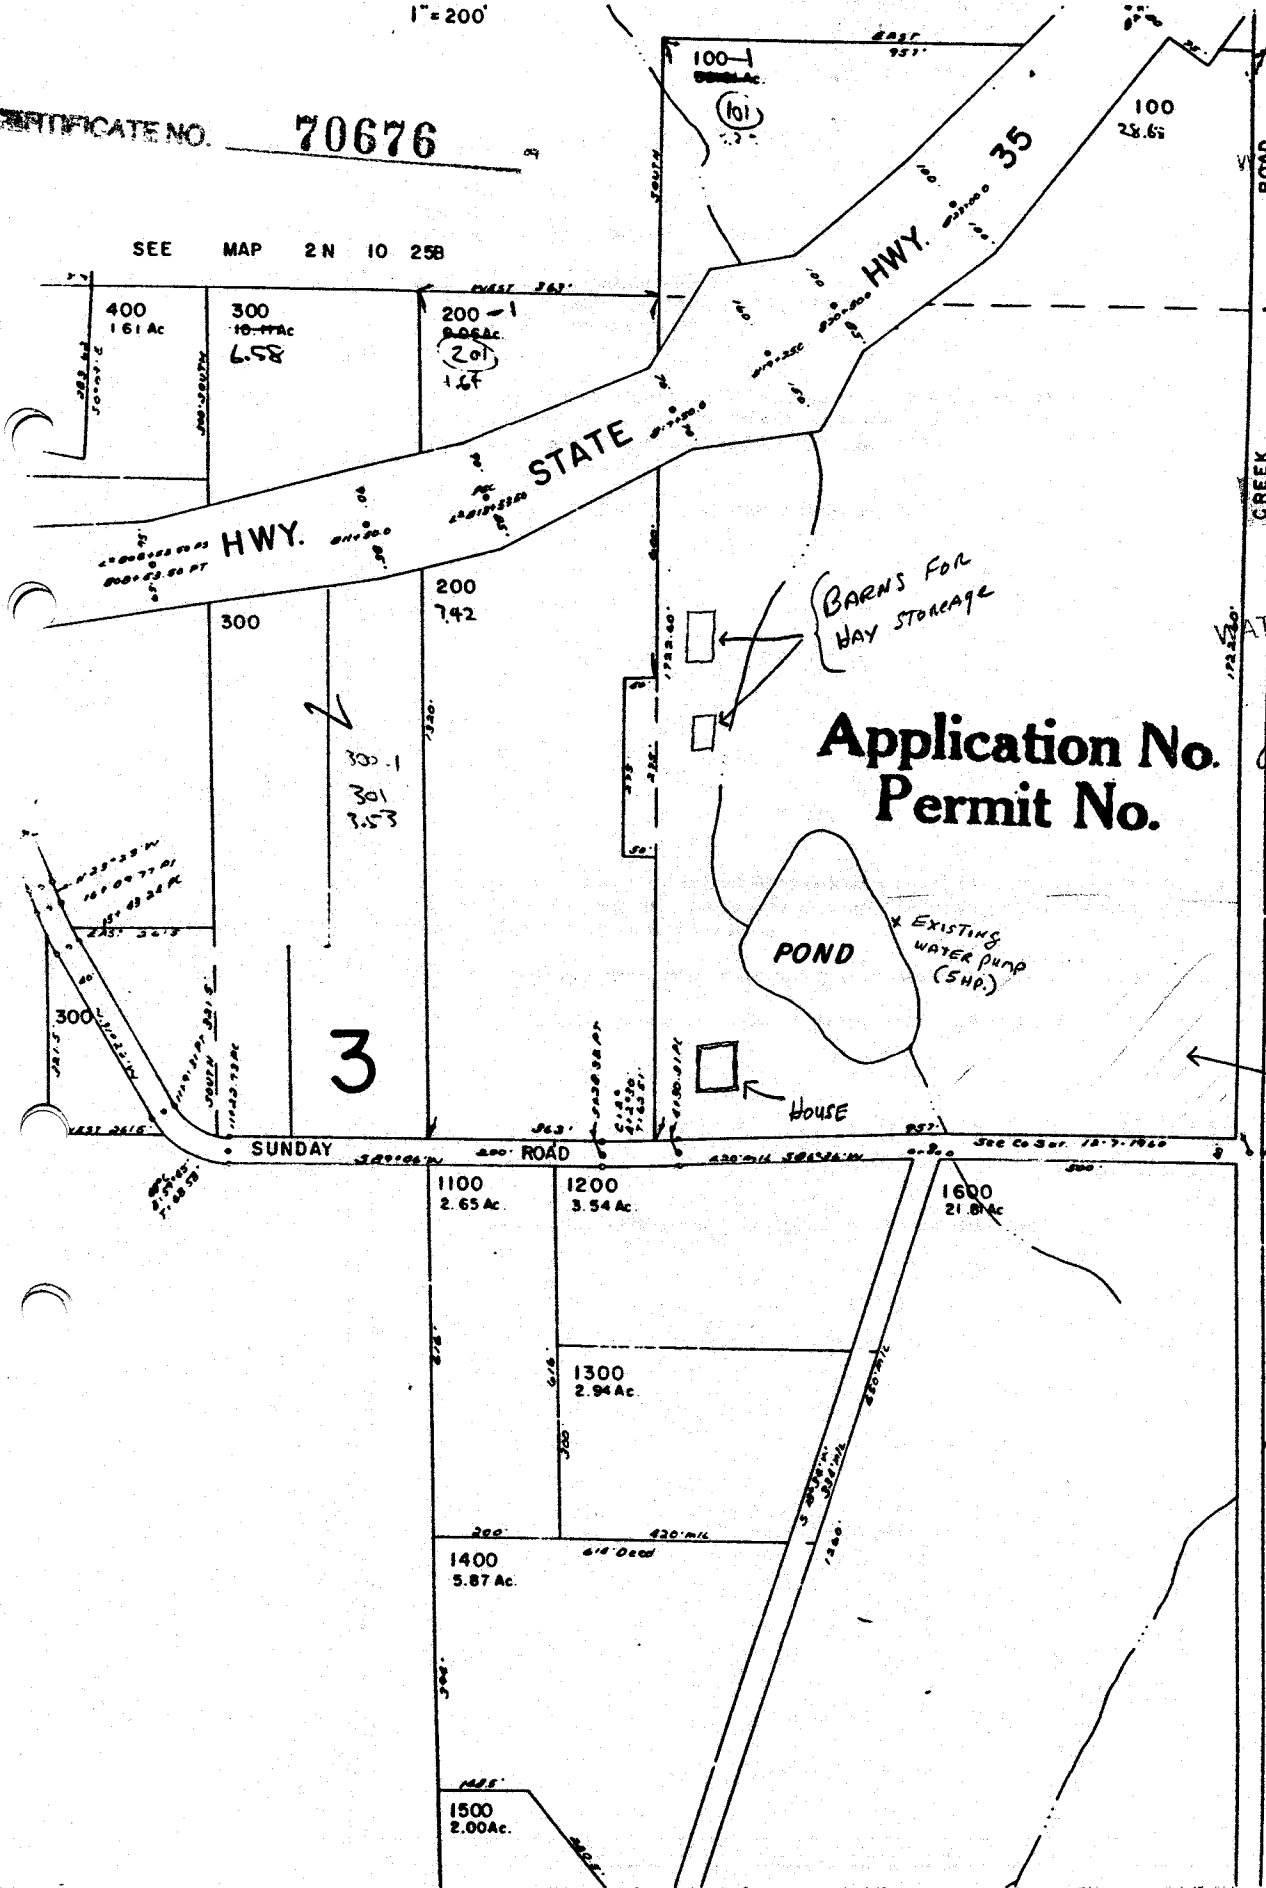

Application No.
Permit No.

R-70754

DEC 30 1994
 WATER RESOURCES DIVISION
 SALEM, OREGON

AREA which could be irrigated approx. 5 acres

SEE MAP 2N 10 25