

SECTION 23 T.26S. R.7W. W.M.
DOUGLAS COUNTY

REVISED ON
4-6-93

26 7 23


THIS MAP WAS PREPARED FOR
ASSESSMENT PURPOSE ONLY.

Application No *R-70756*
Permit No.

SEE MAP 26 14

CERTIFICATE NO. 70678

14 13

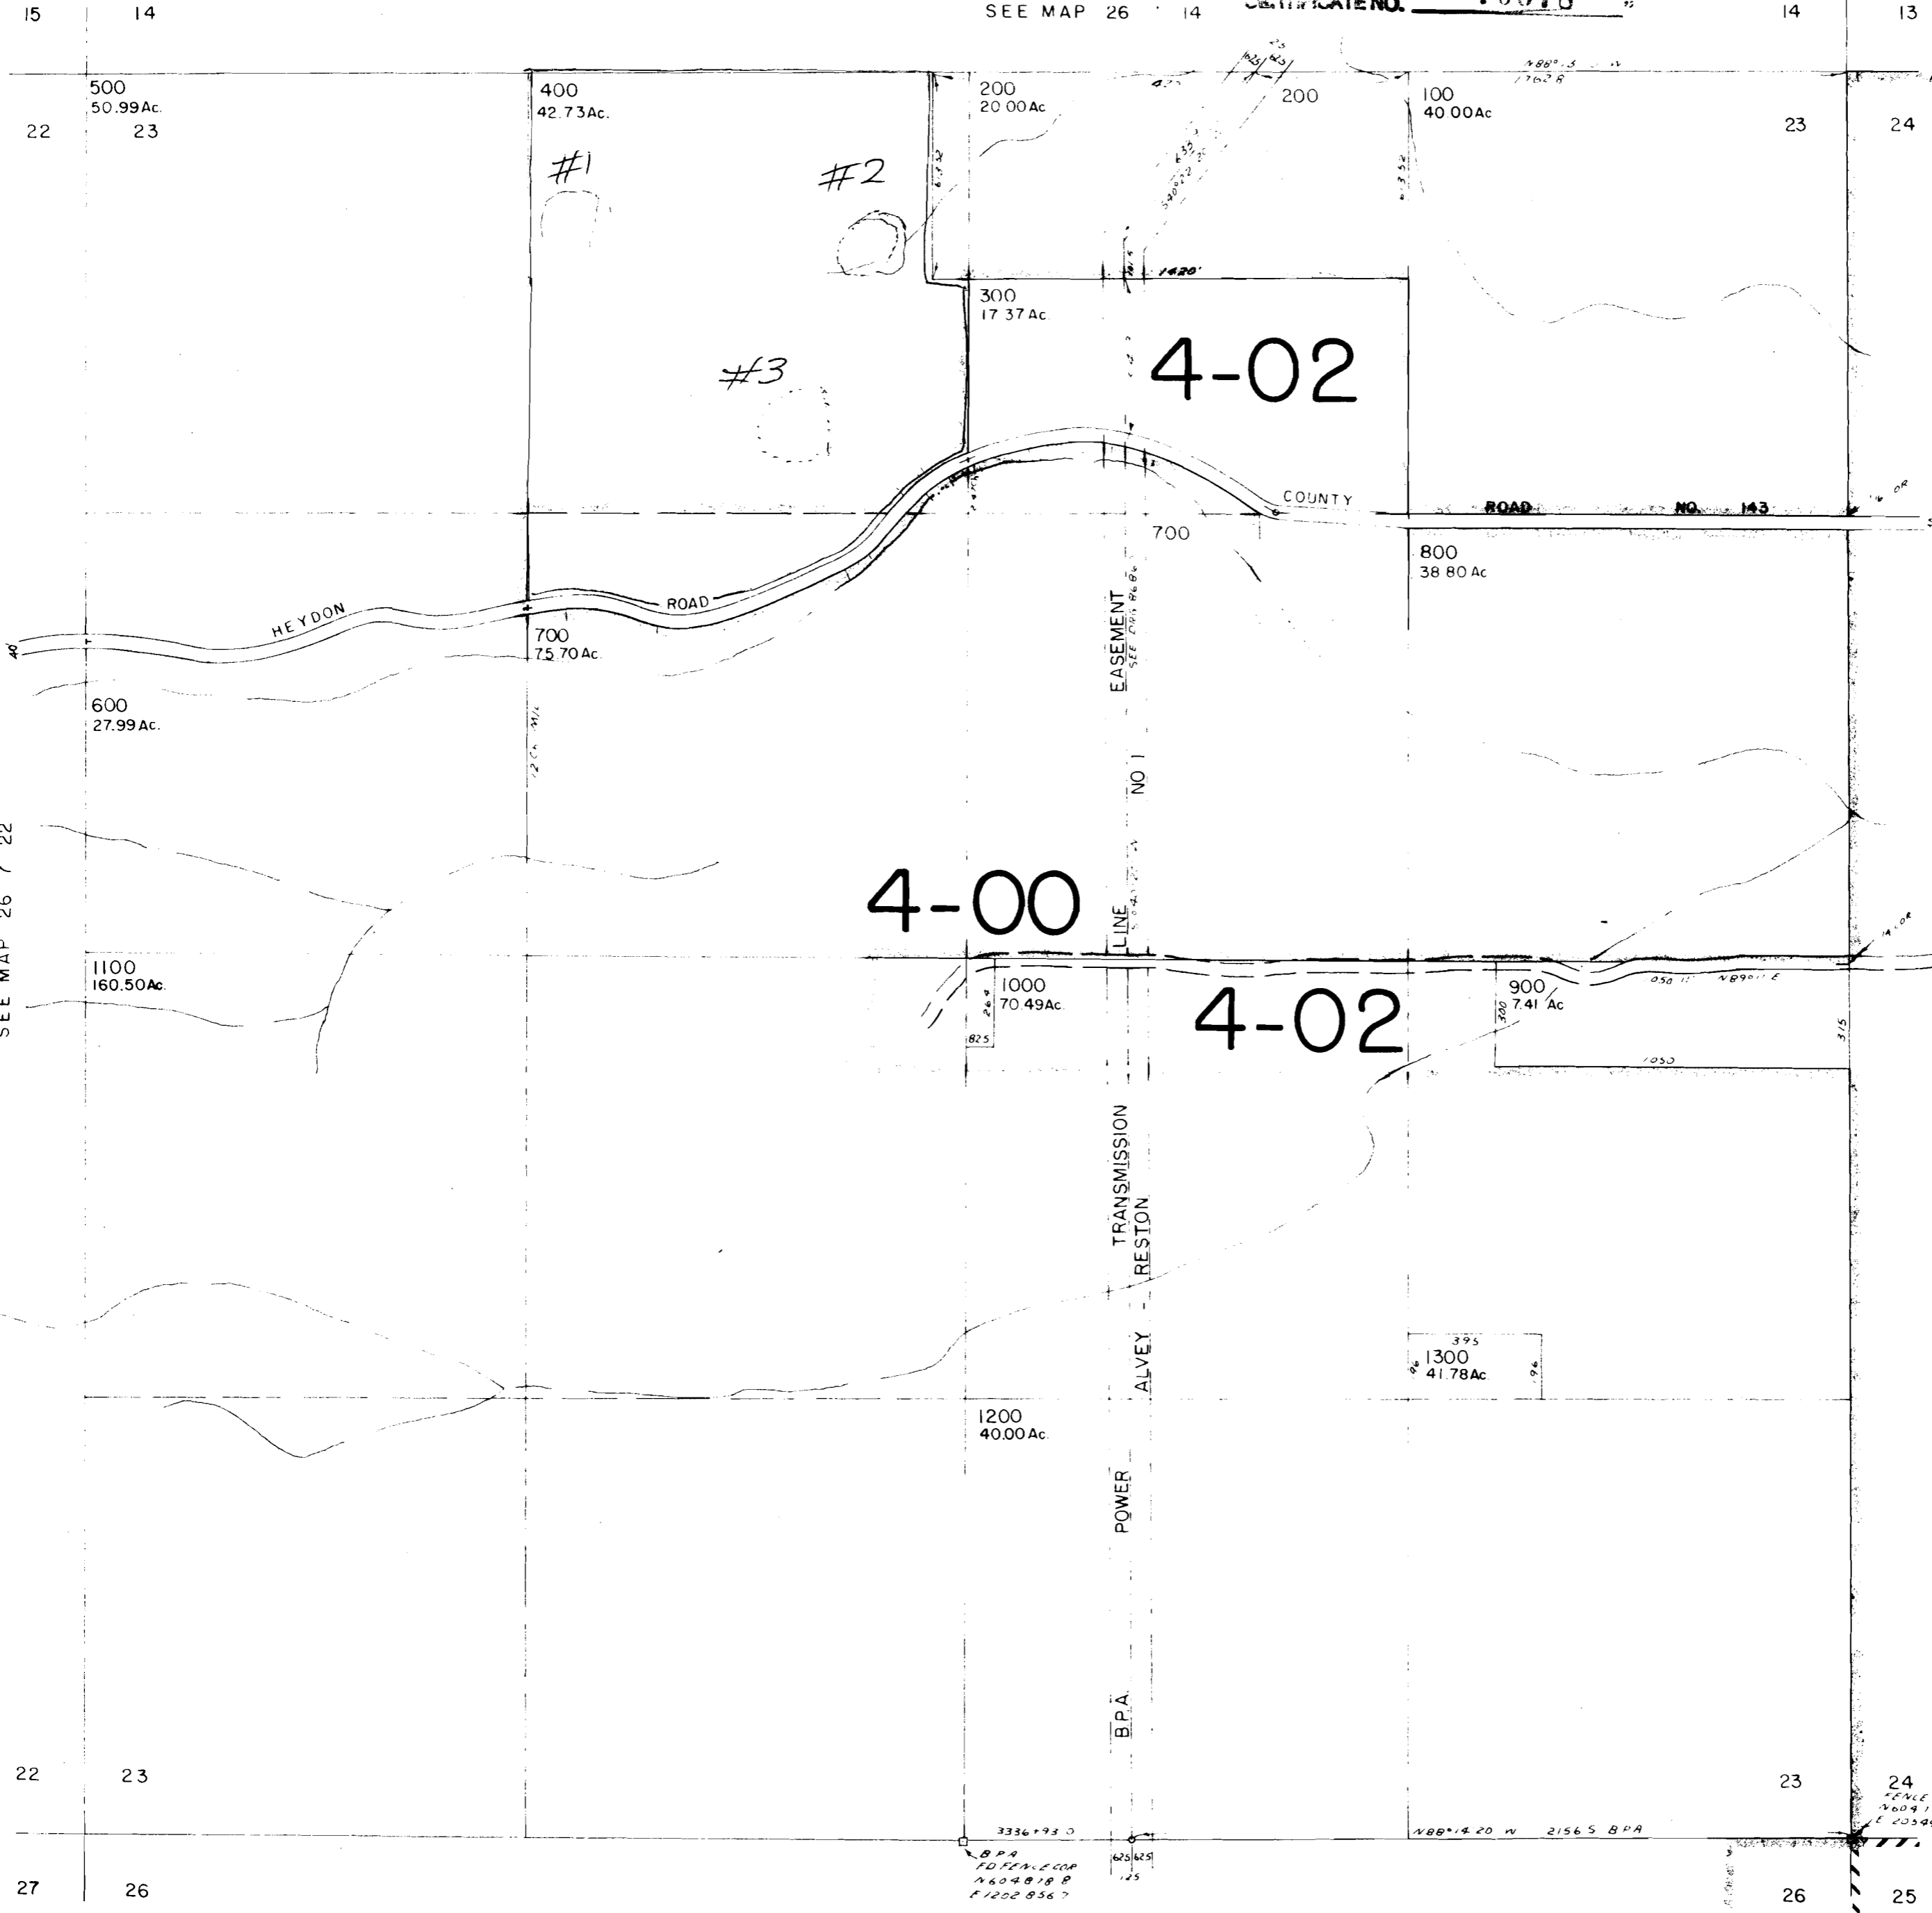

SEE MAP 26 7 24B

SEE MAP 26 7 24C

SEE MAP 26 7 26B

SEE MAP 26 7 26A

26 7 23

No Final Proof Map available

No Permit Map available