

Application No.

Permit No.

70680

CERTIFICATE NO.

Downey Lake

T2S R47E

26
27
28
29
30


SPRINGS

Creek

Bunch Point

UNITED STATES
DEPARTMENT OF THE INTERIOR
GEOLOGICAL SURVEY

CLEAR LAKE RIDGE QUADRANGLE
OREGON-WALLOWA CO.
7.5 MINUTE SERIES (TOPOGRAPHIC)

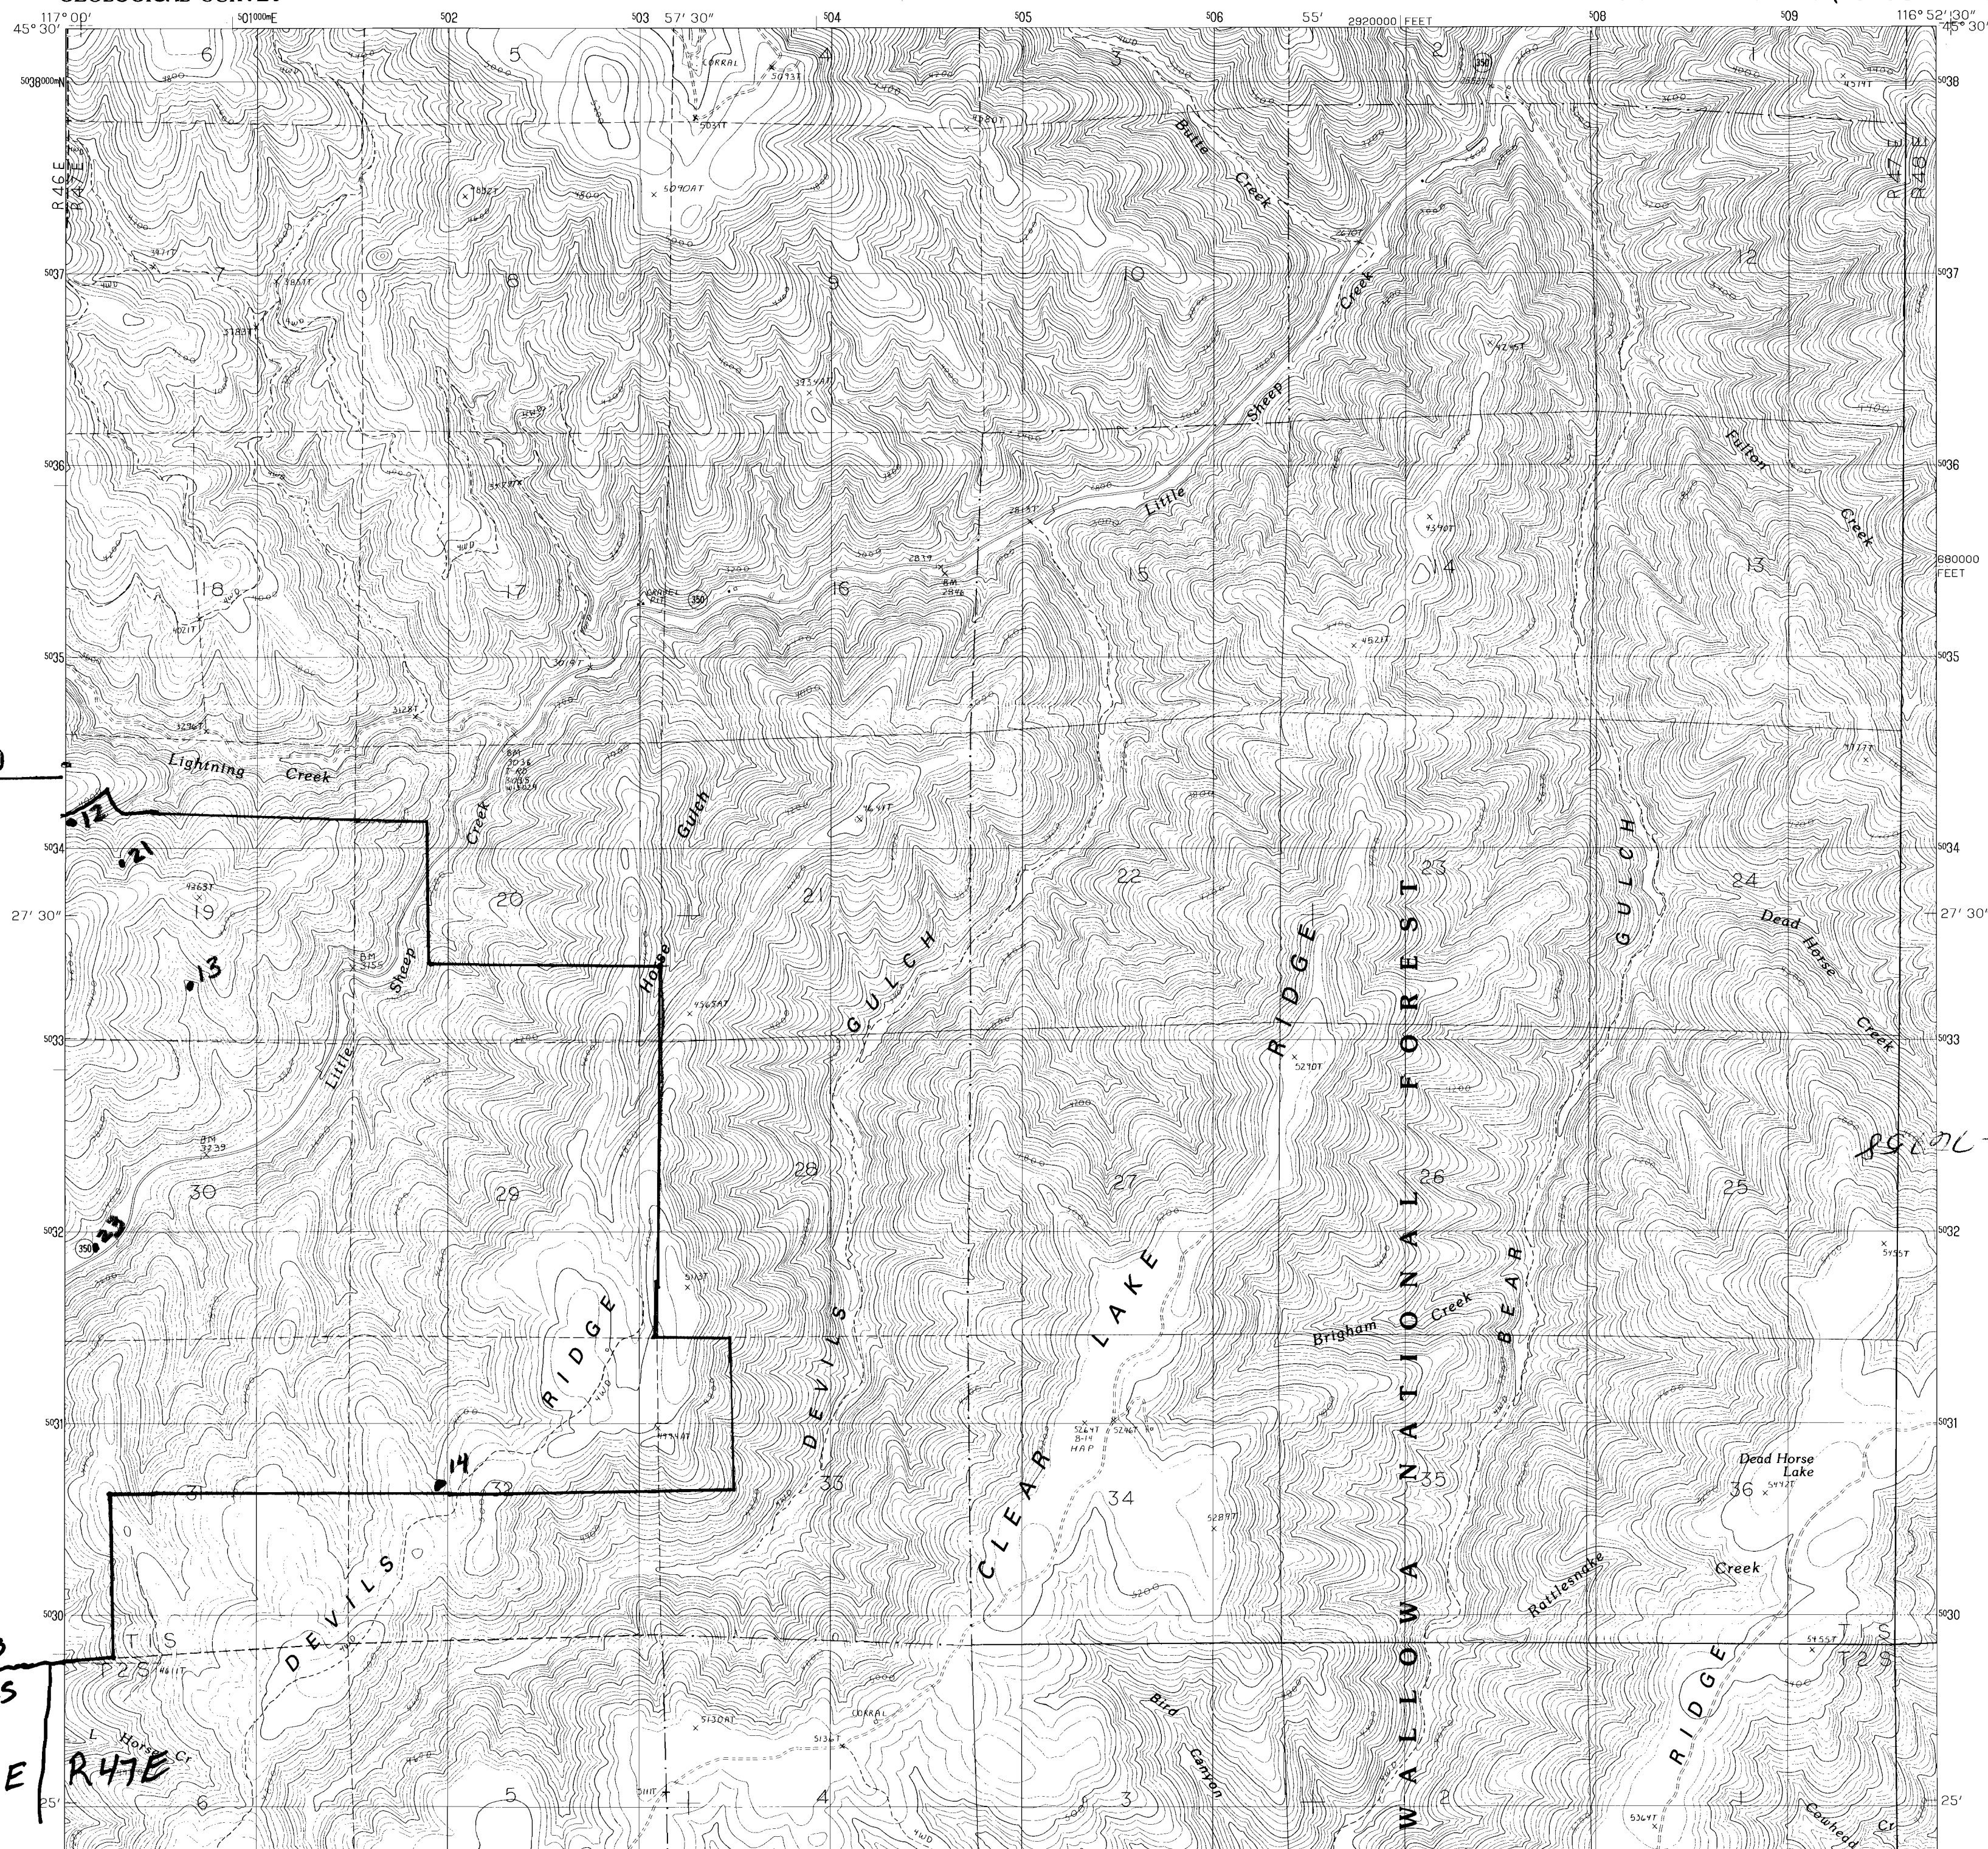

CERTIFICATE NO. 70680


Application No. R-70680
Permit No.

T13
T25

R46E R47E


Application No. *76758*
Permit No. *70680*
T 15
T 25

R 46 E
R 47 E

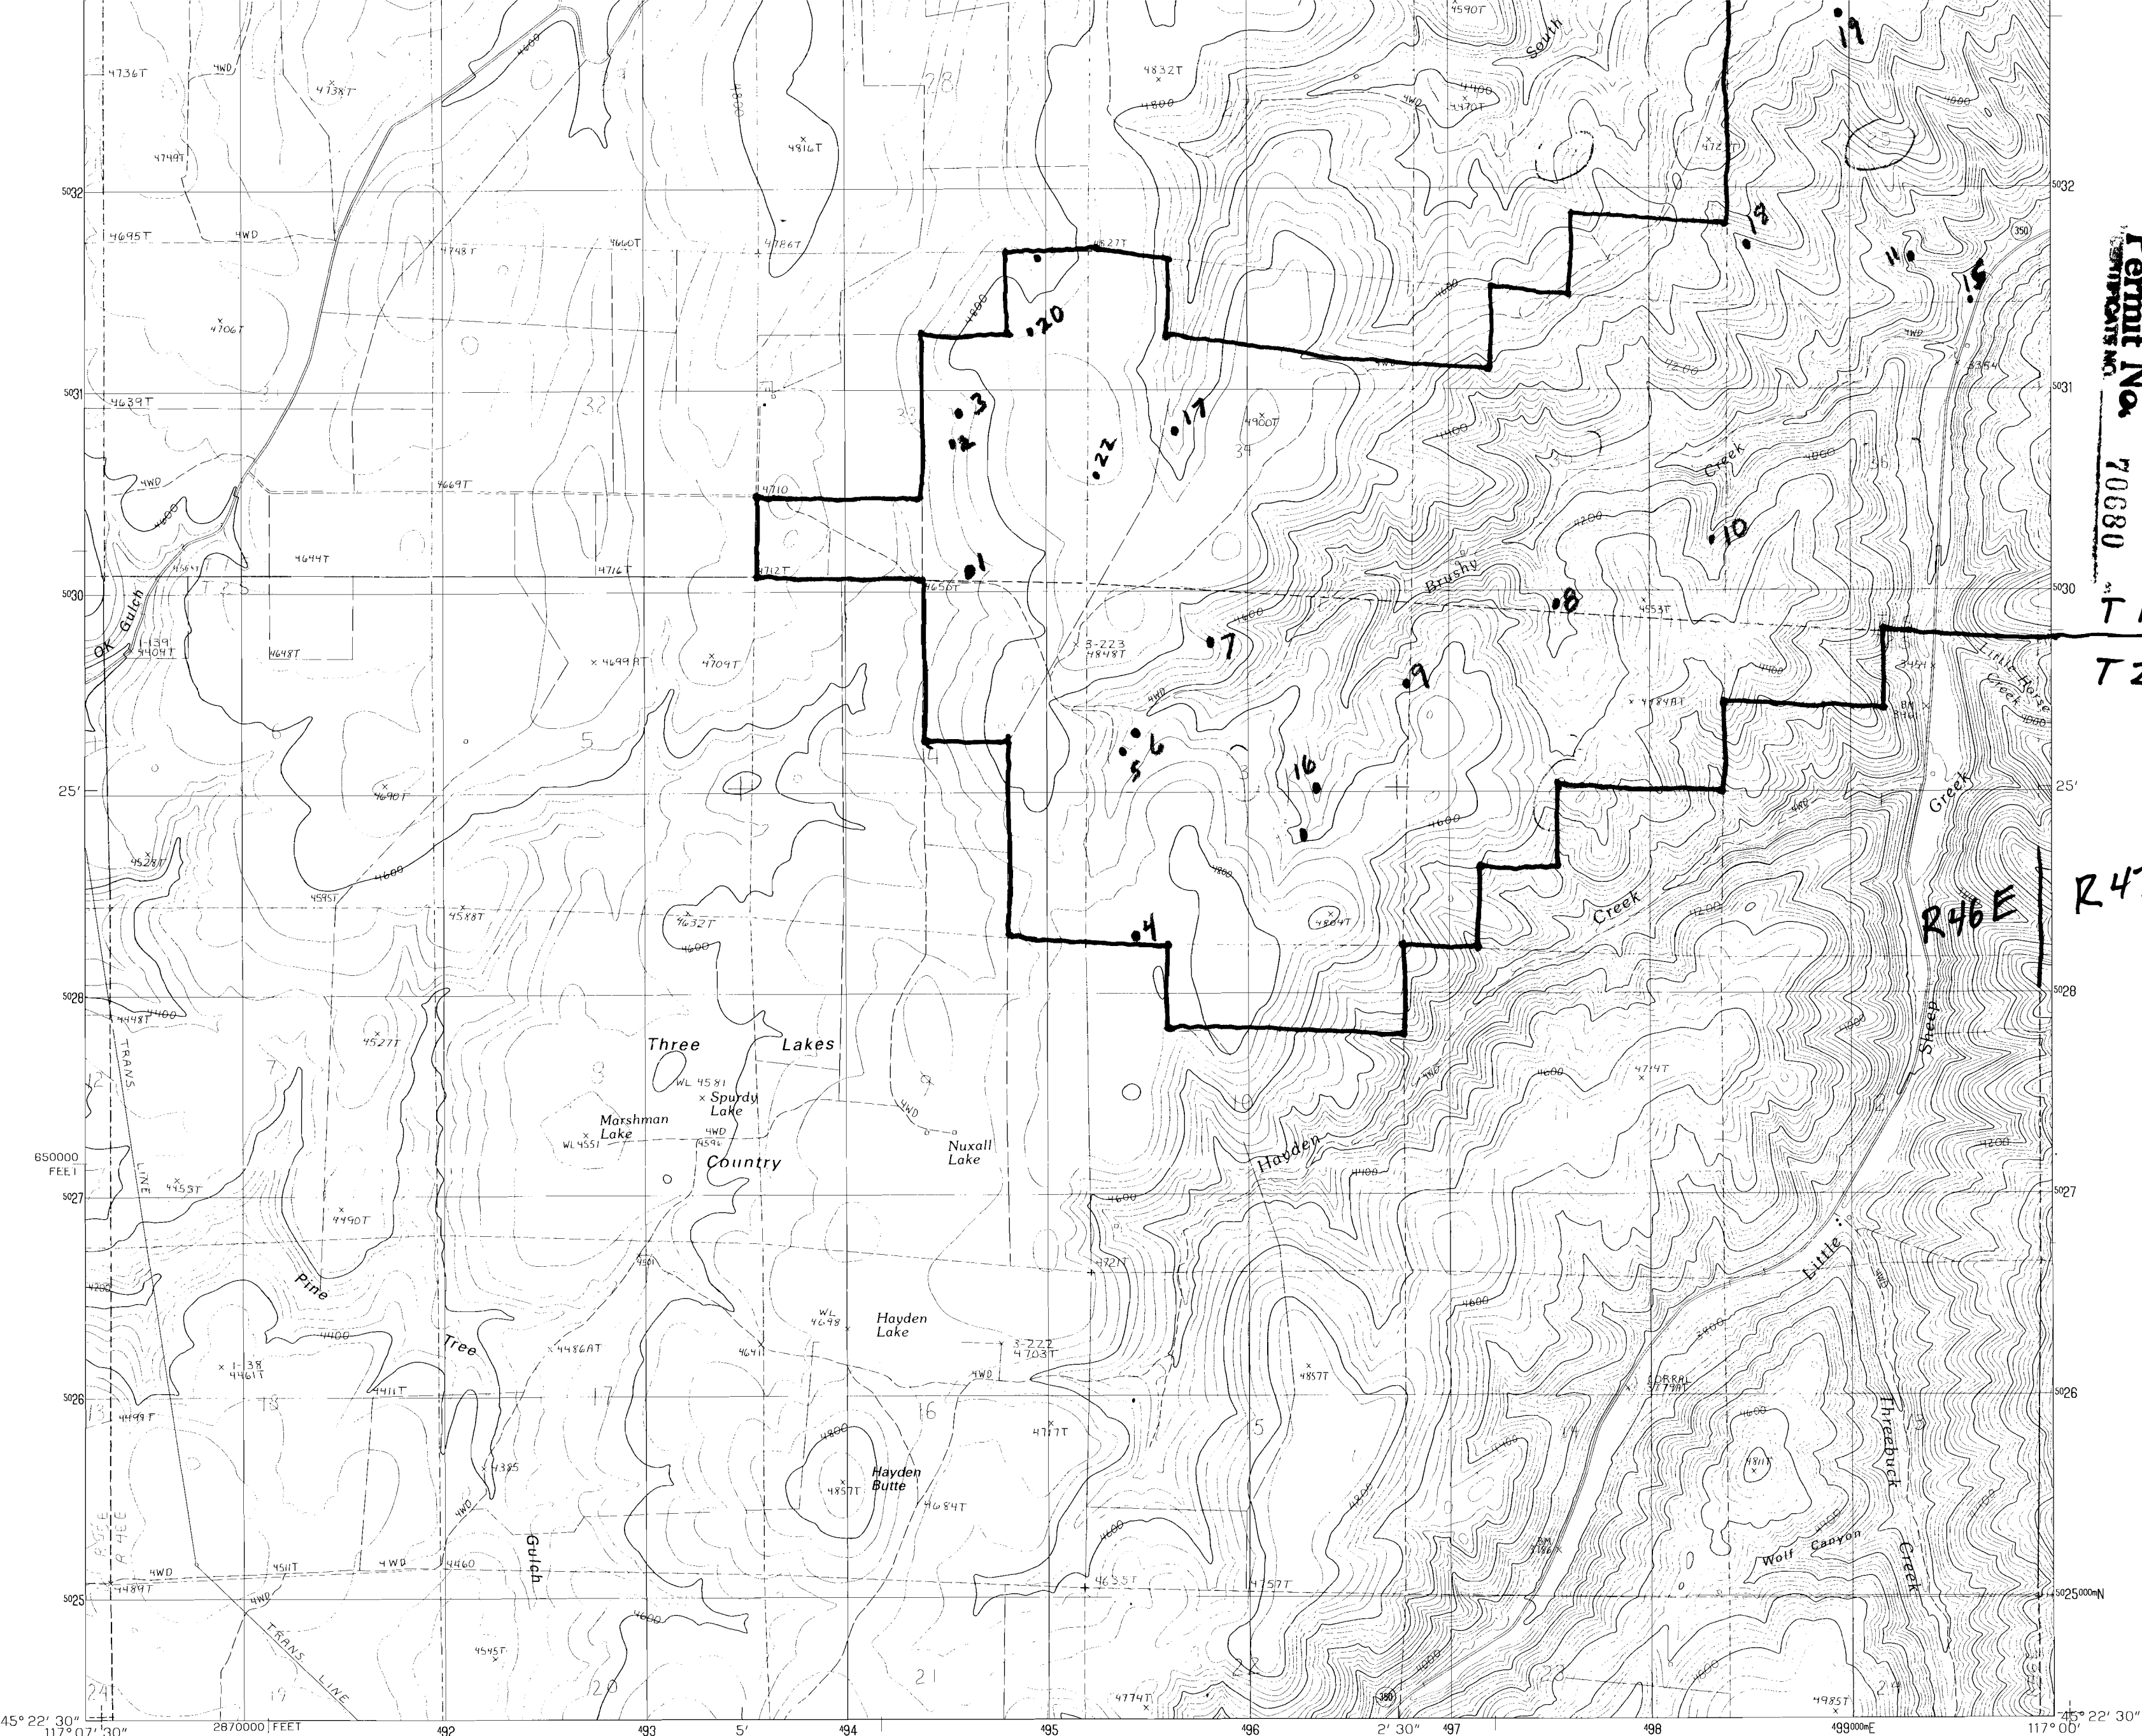

PRODUCED BY THE UNITED STATES GEOLOGICAL SURVEY
CONTROL BY.....USGS AND NOS/NOAA
COMPILED FROM AERIAL PHOTOGRAPHS TAKEN.....1981
FIELD CHECKED.....1987. MAP EDITED.....1990
PROJECTION.....LAMBERT CONFORMAL CONIC
GRID: 1000-METER UNIVERSAL TRANSVERSE MERCATOR.....ZONE 11
10,000-FOOT STATE GRID TICKS.....OREGON, NORTH ZONE
UTM GRID DECLINATION.....0 03' WEST
1990 MAGNETIC NORTH DECLINATION.....17 30' EAST
VERTICAL DATUM.....NATIONAL GEODETIC VERTICAL DATUM OF 1929
HORIZONTAL DATUM.....1927 NORTH AMERICAN DATUM
To place on the predicted North American Datum of 1983,
move the projection lines as shown by dashed corner ticks
(17 meters north and 78 meters east)
There may be private inholdings within the boundaries of any
Federal or State reservations shown on this map

PROVISIONAL MAP
Produced from original
manuscript drawings. Infor-
mation shown as of date of
field check.

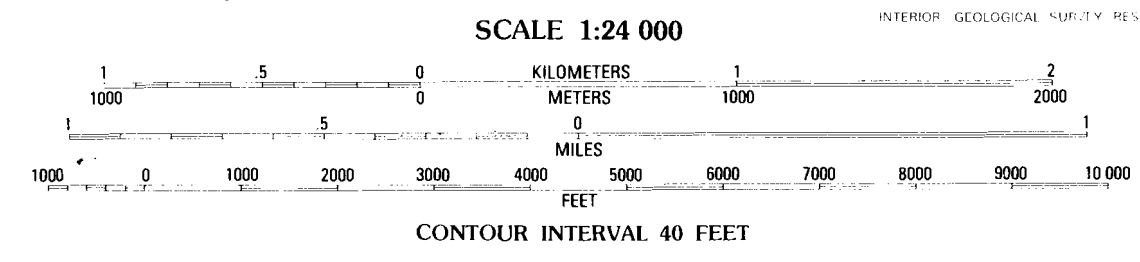

THIS MAP COMPLIES WITH NATIONAL MAP ACCURACY STANDARDS
FOR SALE BY U. S. GEOLOGICAL SURVEY, DENVER, COLORADO 80225, OR RESTON, VIRGINIA 22092

ROAD LEGEND

Improved Road
Unimproved Road
Trail

Interstate Route U. S. Route State Route

QUADRANGLE LOCATION

1	2	3	1 Elk Mountain 2 Elk Mountain SE 3 Findley Buttes 4 Joseph NW 5 Clear Lake Ridge 6 Joseph 7 Kinney Lake 8 Harl Butte
4		5	
6	7	8	

ADJOINING 7.5 QUADRANGLE NAMES

THREE LAKES COUNTRY, OREGON
PROVISIONAL EDITION 1990

45117-D1-TF-024

No Final Proof Map available

No Permit Map available