

RECEIVED

DEC 21 1994

WATER RESOURCES
SALEM, OREGON

WATER RESOURCES DLP
SALEM, OREGON

T2S R47E

Downey Lake

4942T

X

4921T

CORRAL

SPRING

FLOWING

THILL

5101T

SPRING

1994

WATER RESOURCES DLP

SALEM, OREGON

STOCK

POND

5345AT

STOCK

POND

5010T

5204T

SPRING

5004AT

SPRING

5533T

CORRAL

YND

SPRING

19

5049T

SPRING

SPRINGS

SPRINGS

5571T

5082T

5863T

MAP 81

86-80

X 5084T

X 5117T


Application No.

R-76759

Permit No.

70681

CERTIFICATE NO.

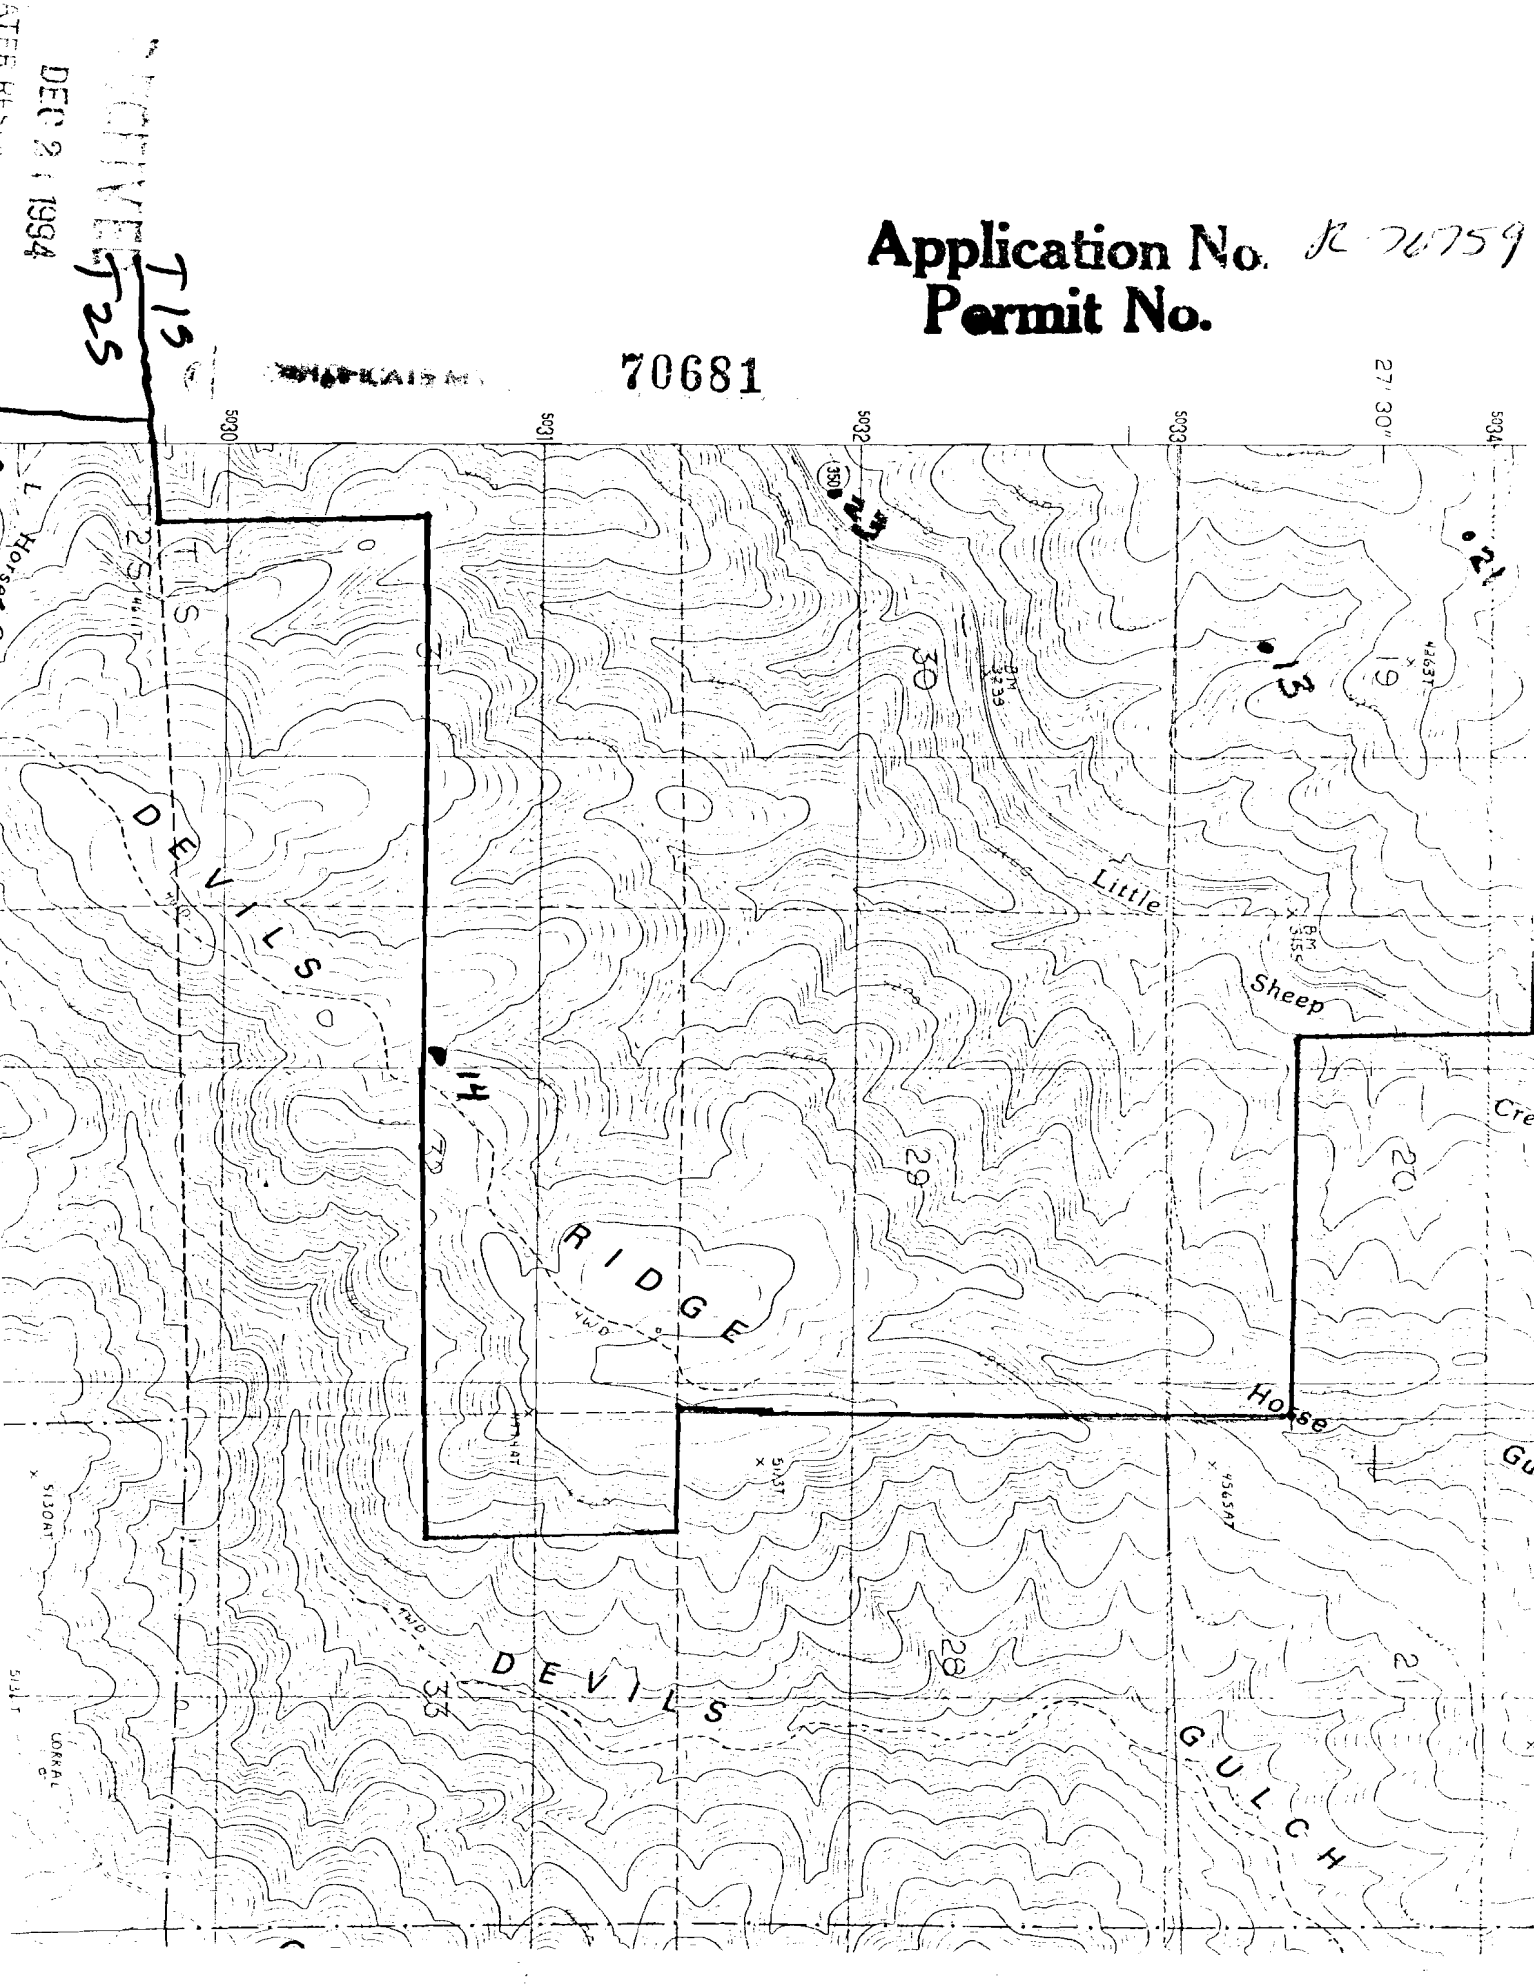


Application No. R 76759
Permit No.

70681

DEC 21 1994

T13
T25

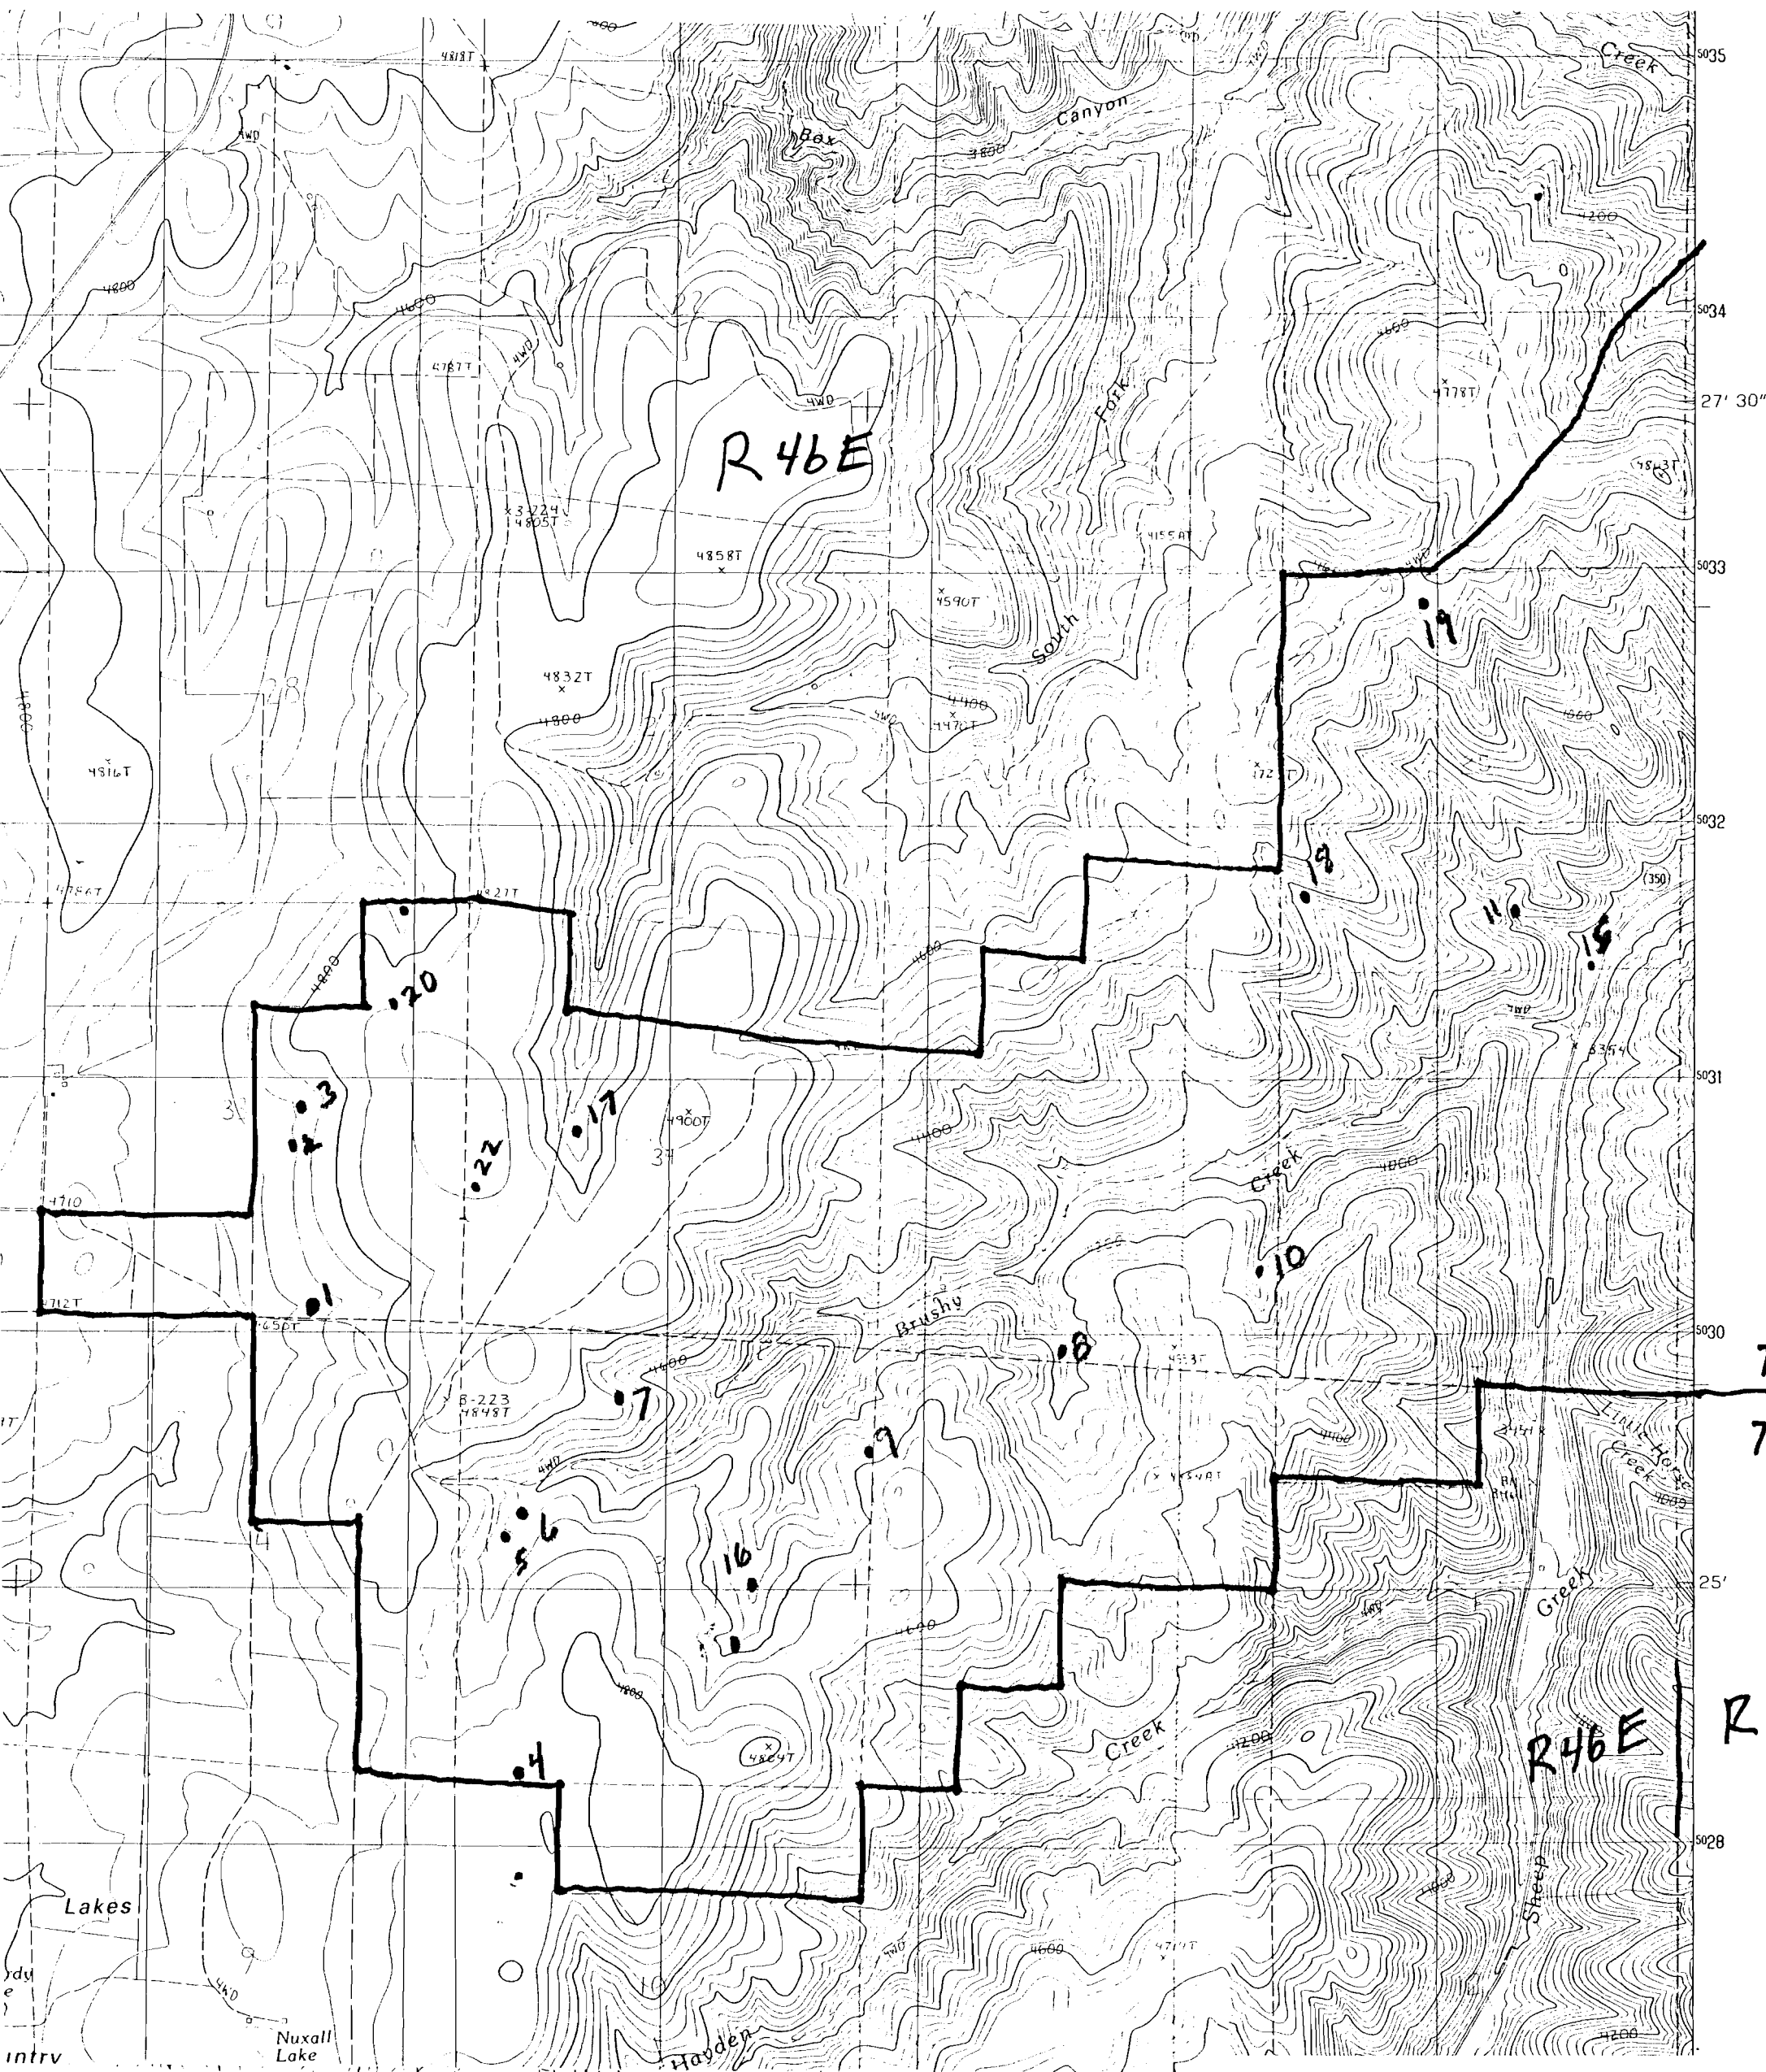

T 1 S
T 2 S

R 47 E

R 46 E

Application No. R-76759

Permit No.

CERTIFICATE NO. 70681

RECEIVED
DEC 21 1994
NATURAL RESOURCES DEPT.
SALEM, OREGON

No Final Proof Map available

No Permit Map available