

RECEIVED  
JAN 03 1995  
WATERMASTER  
HILLSBORO, OR

SEC  
SE/SE 00 28

SECTION [REDACTED]


P-51132 several sources  
see abstract

WASHINGTON COUNTY, OREGON

SCALE 1"=400'

Application No R-76778  
Permit No.


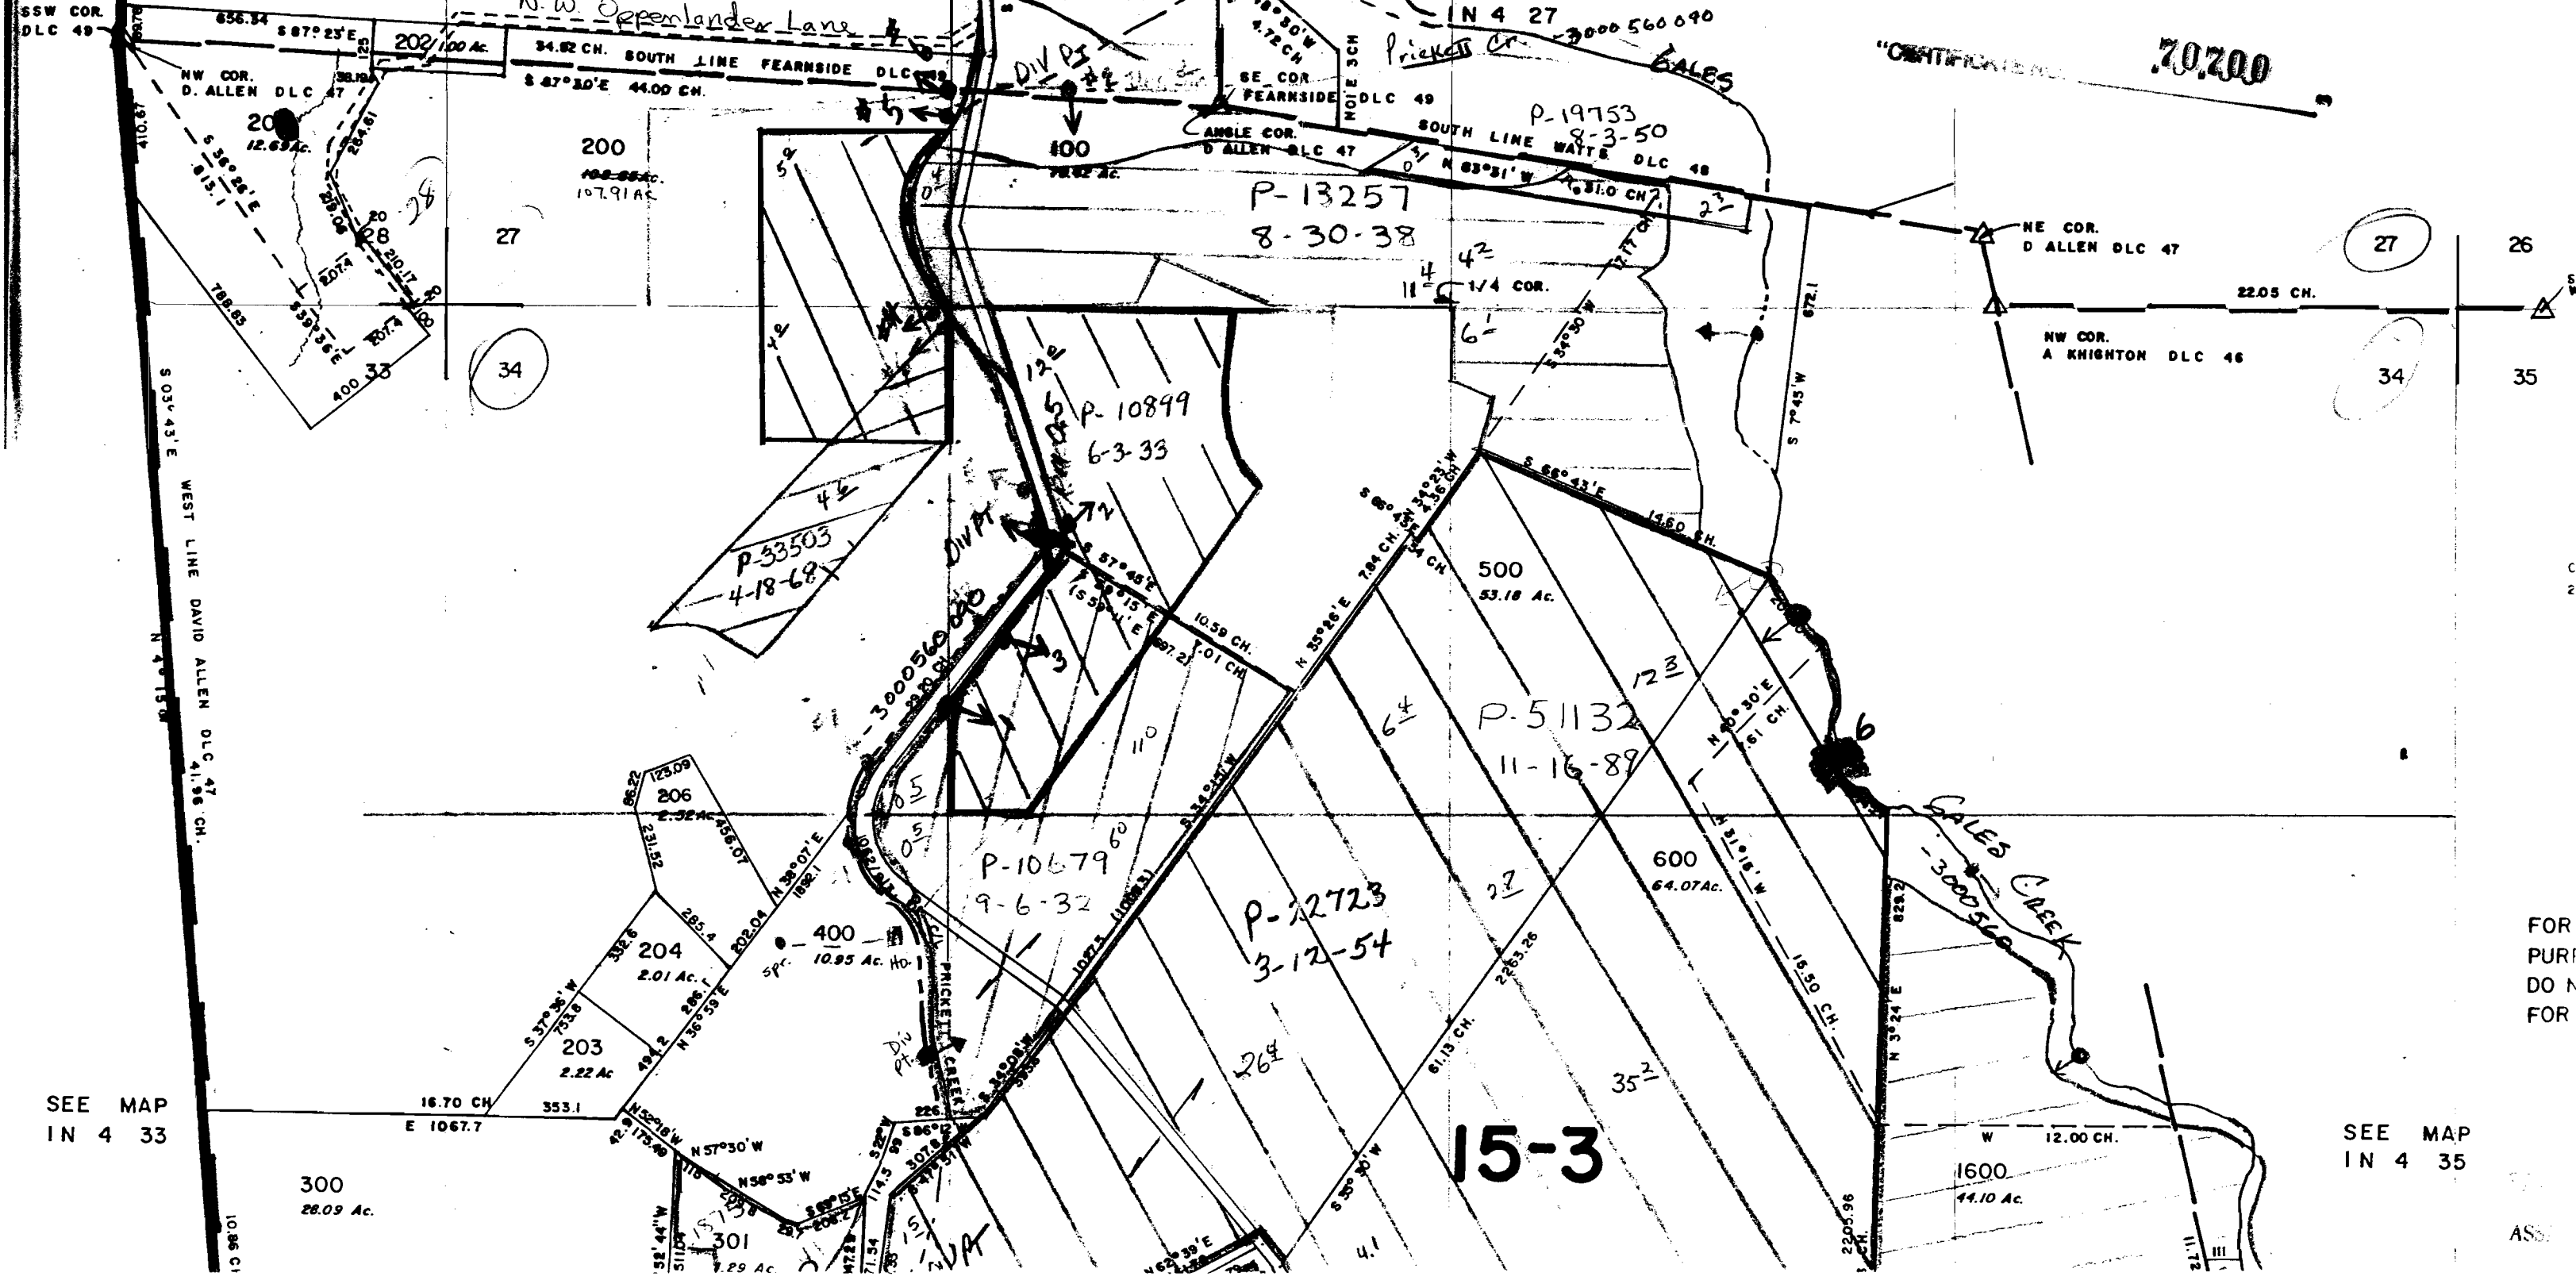

SEE MAP  
IN 4 33

SEE MAP  
IN 4 35

FOR  
PUR  
DO N  
FOR

ASS

No Final Proof Map available

No Permit Map available