

CERTIFICATE NO. 70704

PARTITION PLAT NO. 1990-

RECEIVED




JAN 20 1995

SECTION 32, TOWNSHIP 4 NORTH, RANGE 38 EAST, W.M.,

UMATILLA COUNTY, OREGON

Application No. R-76784
Permit No. R-76783

WATER RES. DIV. DEPT. OF AG.
SALEM, OREGON

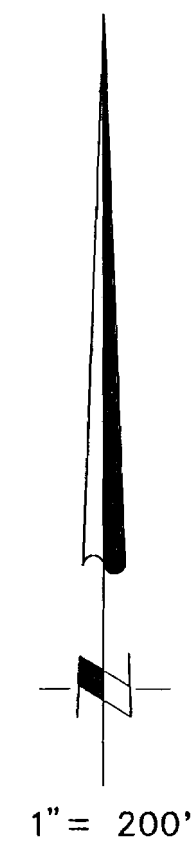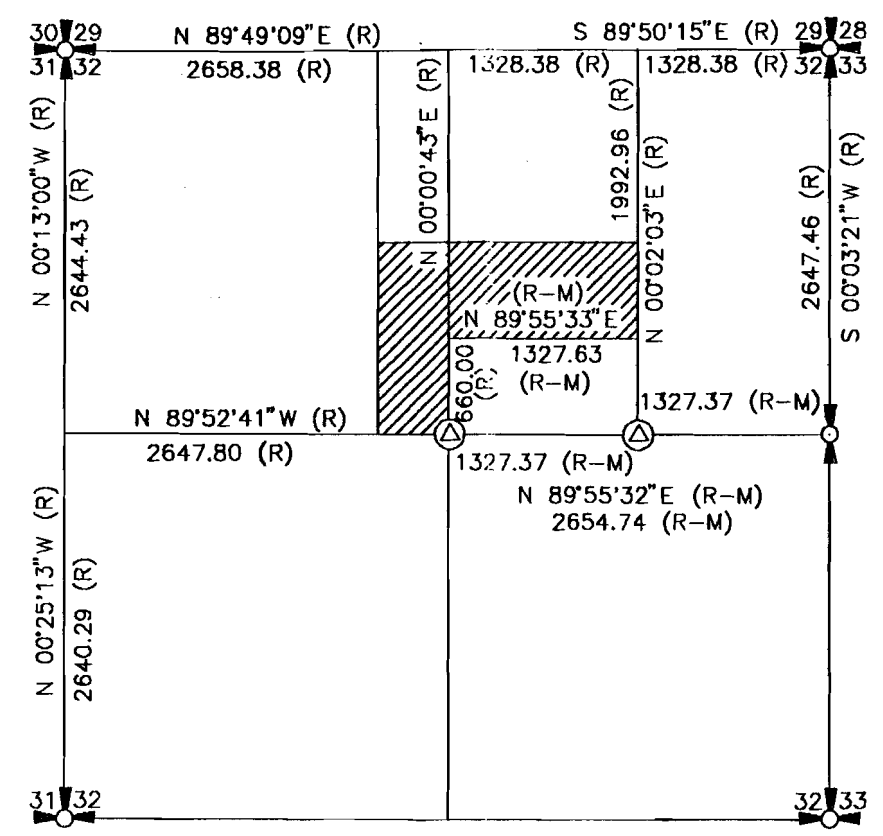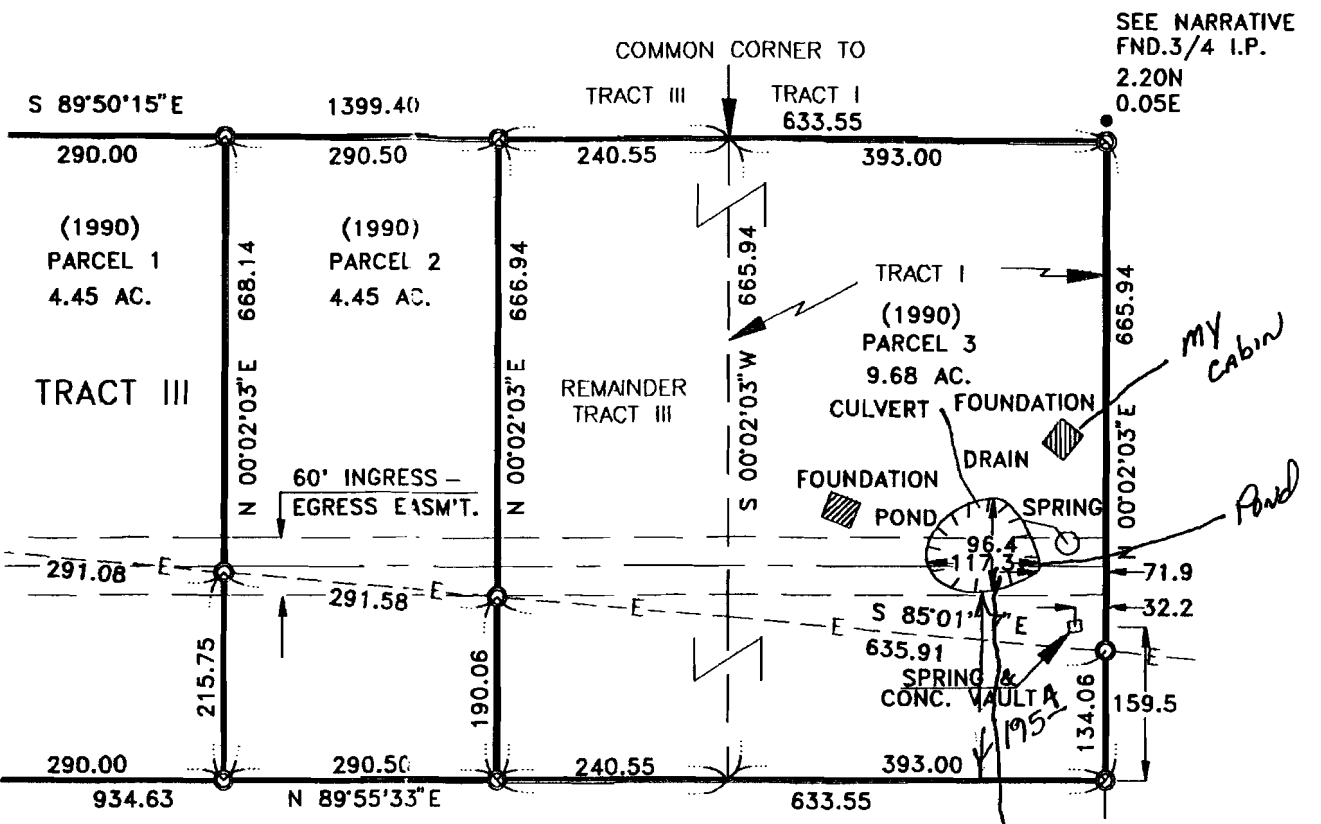

NOTE 1

PARCEL 1 & 2 WERE APPROVED FOR SEGRAGATION IN 1989 BY THE COUNTY OF UMATILLA, BUT WAS NOT RECORDED. THE PROPERTY IS VESTED IN ARCHIE HARRIS AND MARJORIE HARDER. SECOND PARTY BEING KEITH ADAMS AND THIRD PARTY BEING THOMAS L. BOSCH, MARY P. BOSCH, GARY E. BOSCH AND NAYDENE L. BOSCH.

CERTIFICATION

SURVEY NARRATIVE

I, A PROFESSIONAL LAND SURVEYOR IN THE STATE OF OREGON, THIS MAP CORRECTLY REPRESENTS A SURVEY CONDUCTED IN ACCORDANCE WITH THE REQUIREMENTS OF THE OREGON LAND SURVEYING ACT.

THE PURPOSE OF THIS SURVEY WAS TO ESTABLISH THE BOUNDARY OF FOUR PARTITIONED PARCELS WHICH IS TRACT III AND A PORTION OF TRACT I.

No Final Proof Map available

No Permit Map available