

Application No. R-76787

Permit No. 18706

CERTIFICATE NO.

RECEIVED

DEC 21 1994

WATER RESOURCES DEPT.
SALEM, OREGON

MOORE MILL


PLAT OF

Twp. 29s Rge. 13w Sec. 28

RECEIVED

DEC 29 1994

WATER RESOURCES
SALEM, OREGON

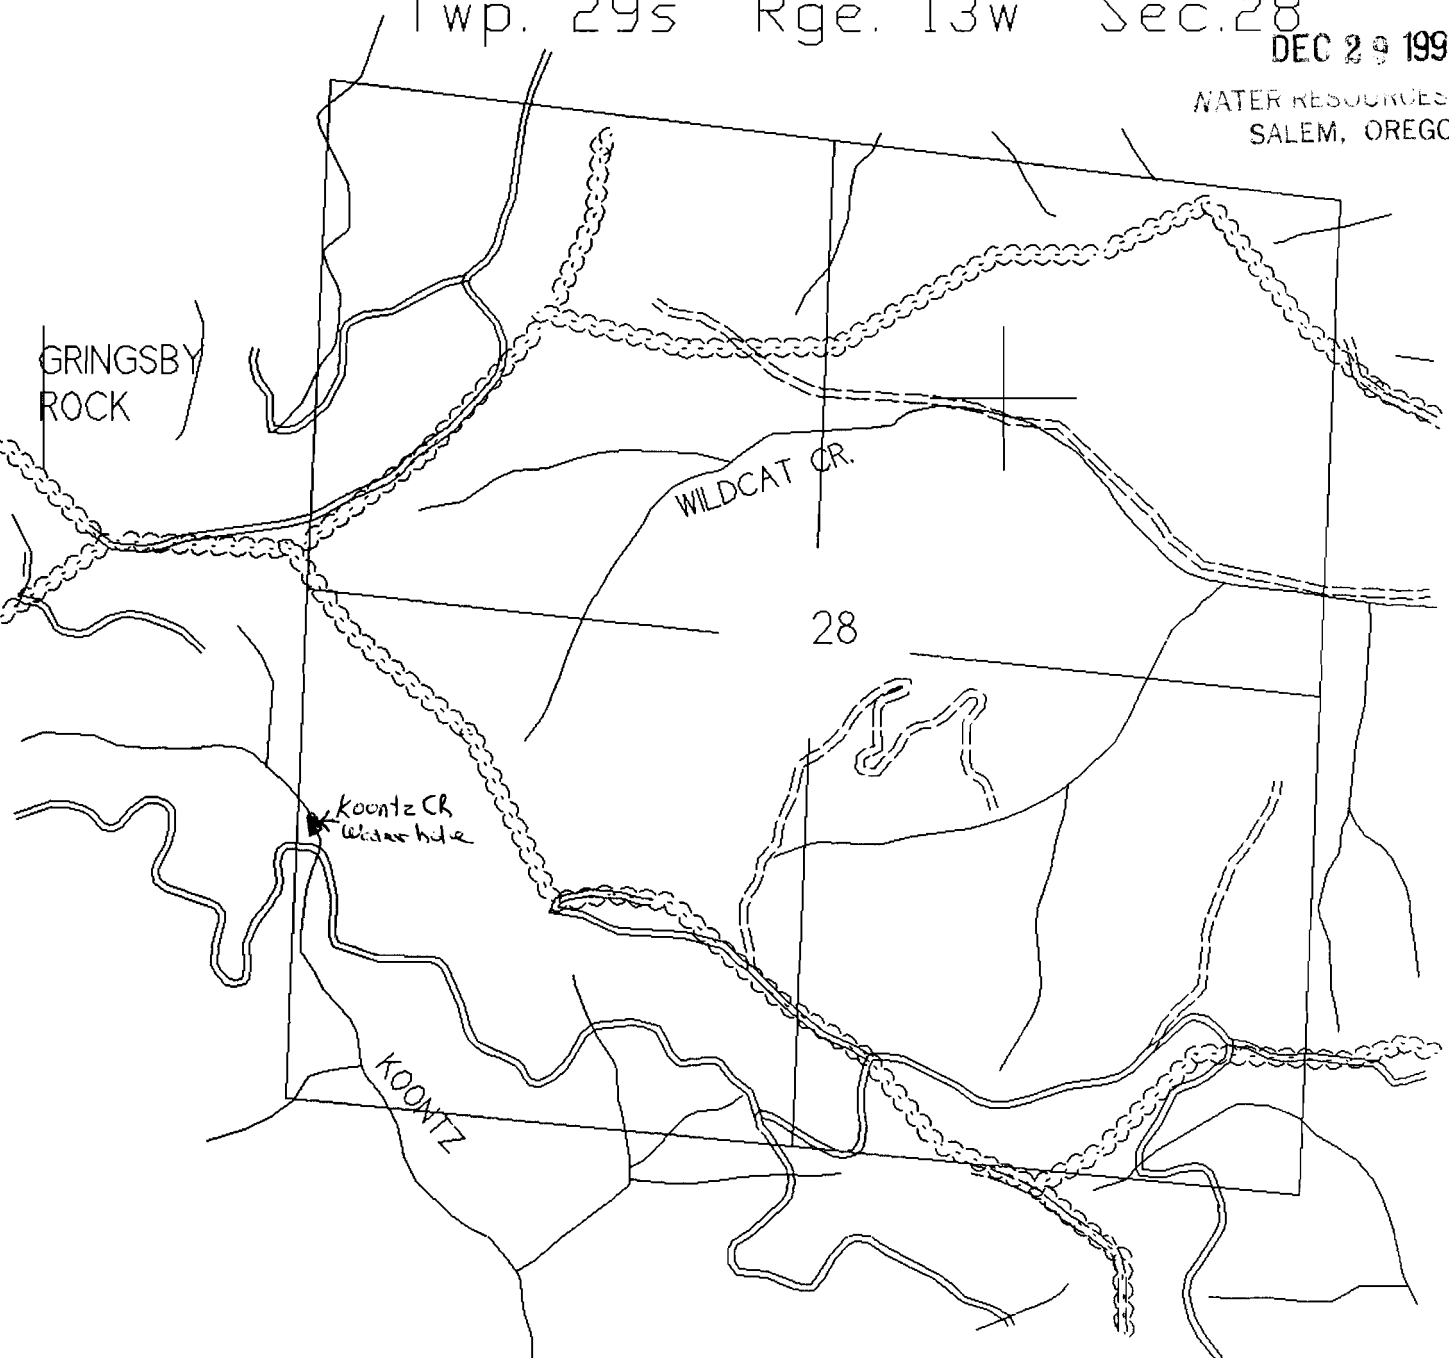

1 in. = 1000 ft.

No Final Proof Map available

No Permit Map available